




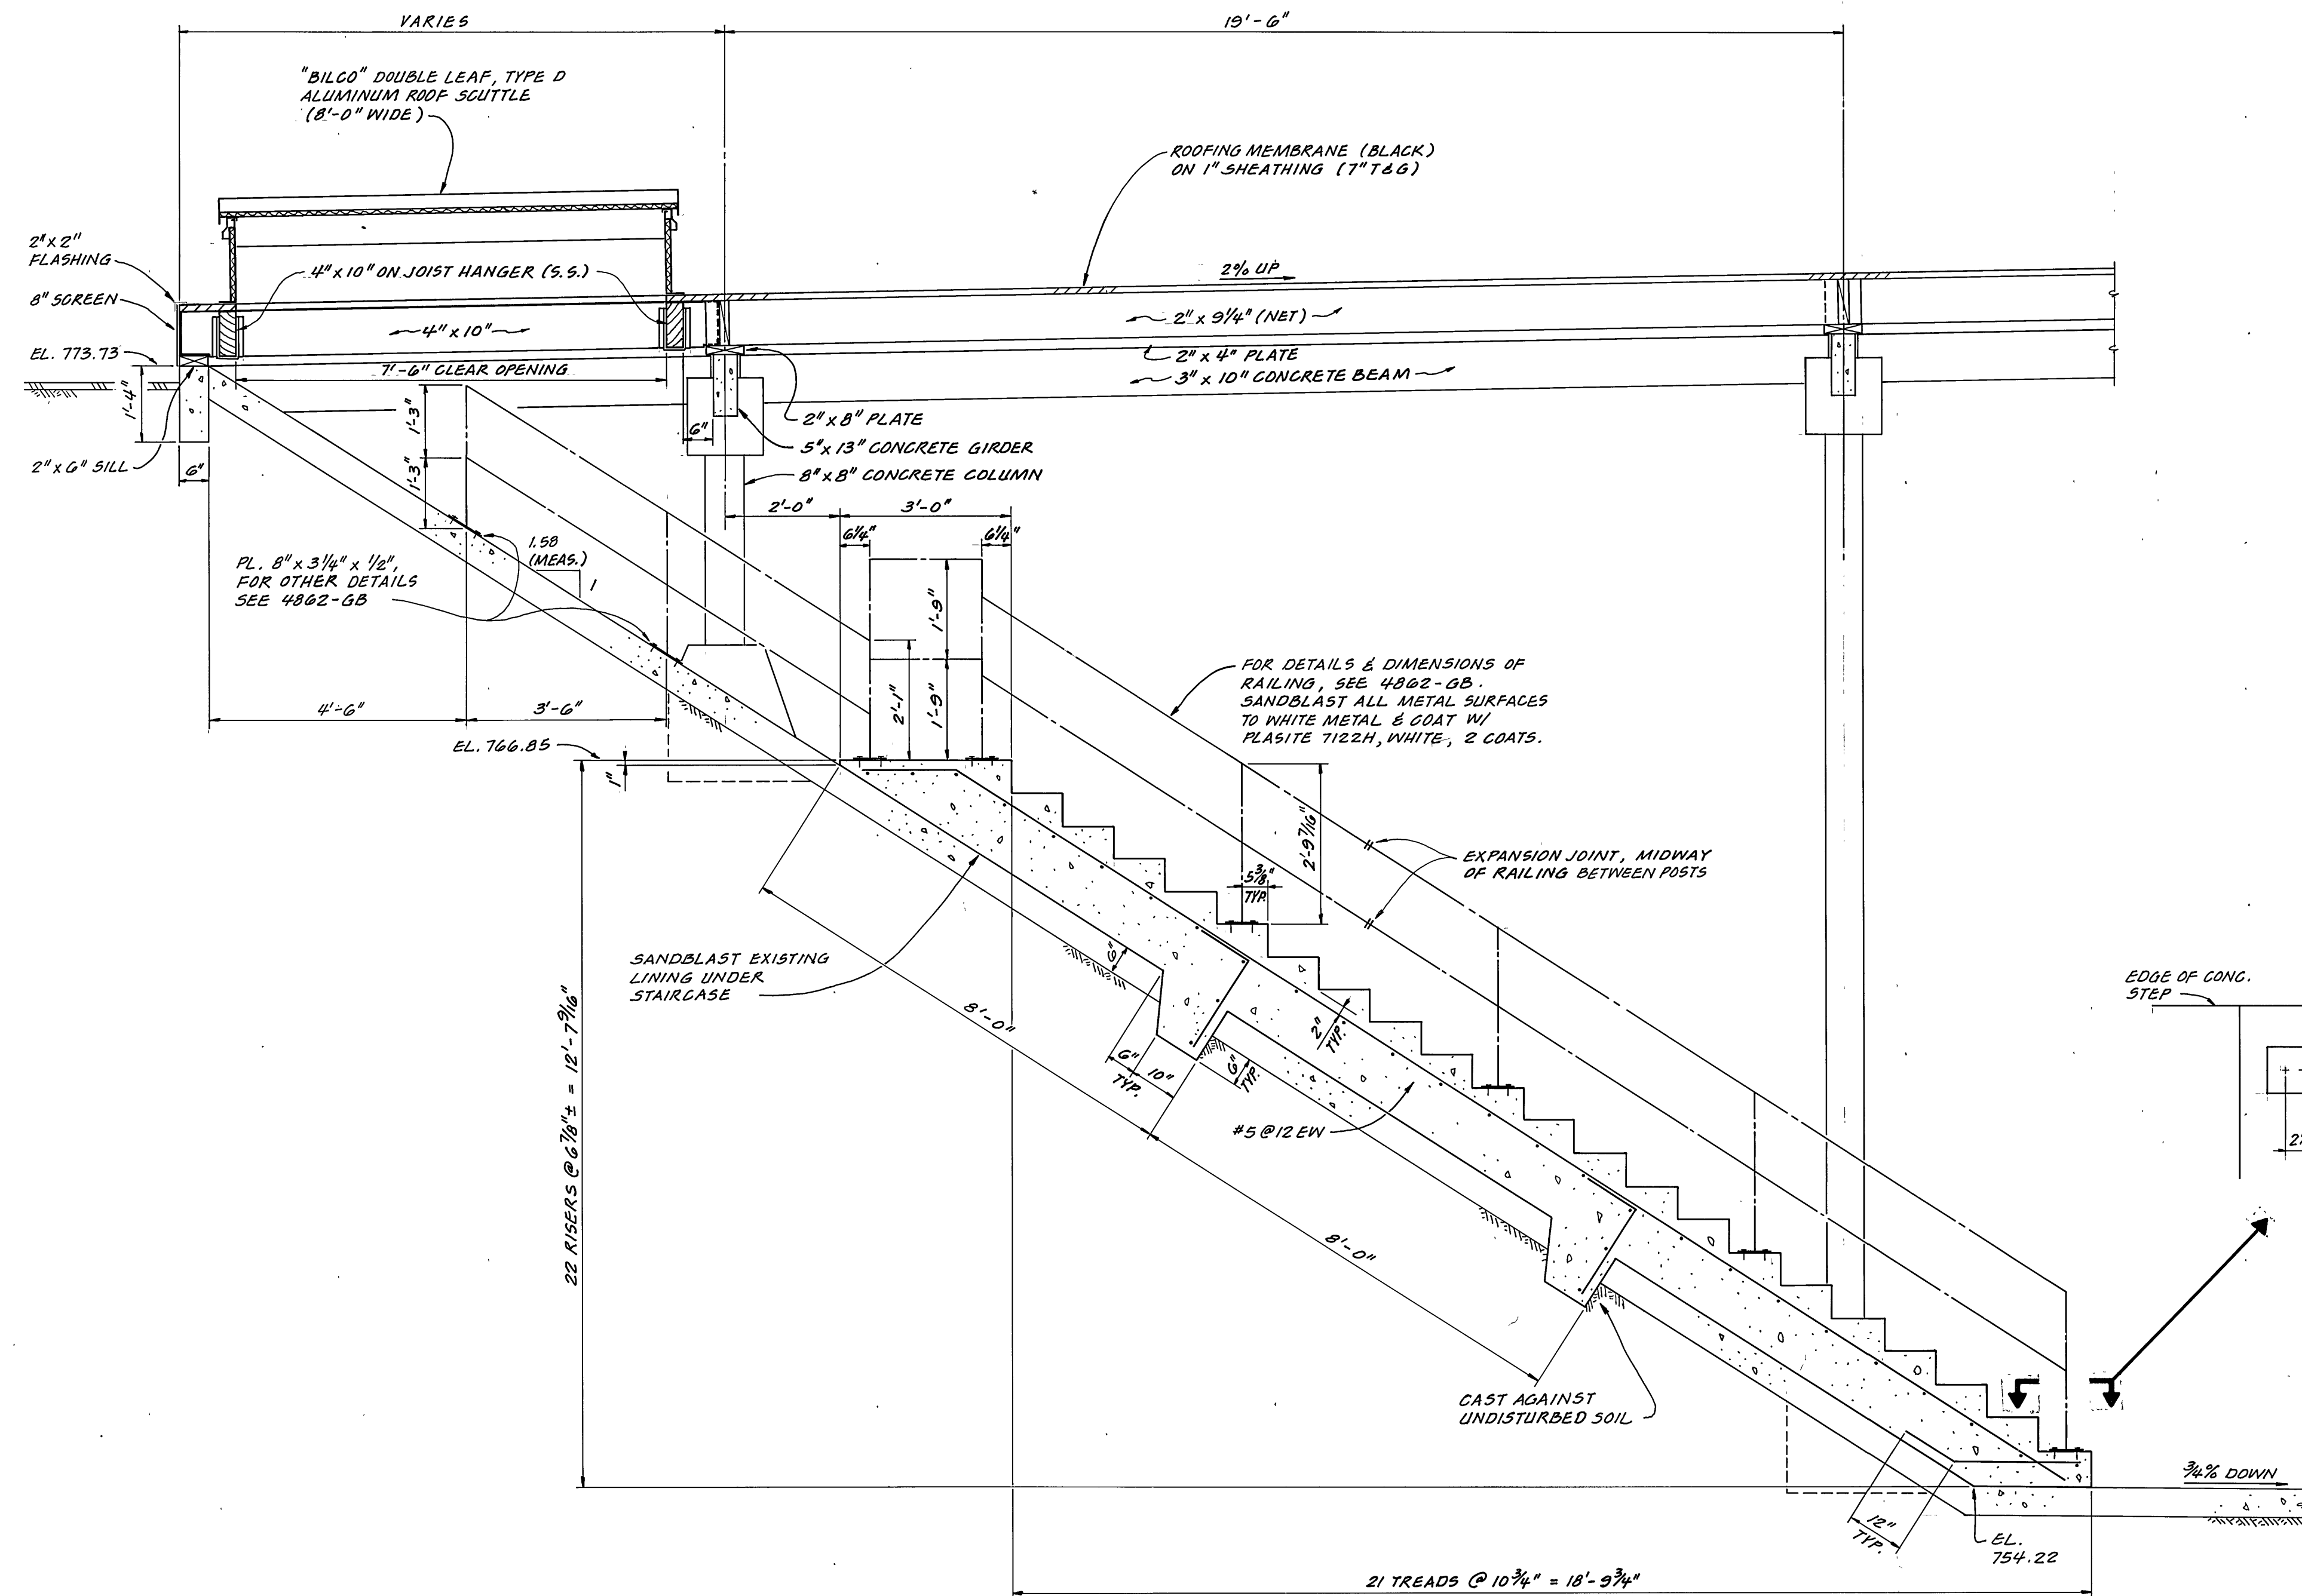

SECTION A-A
1/2" = 1'-0"

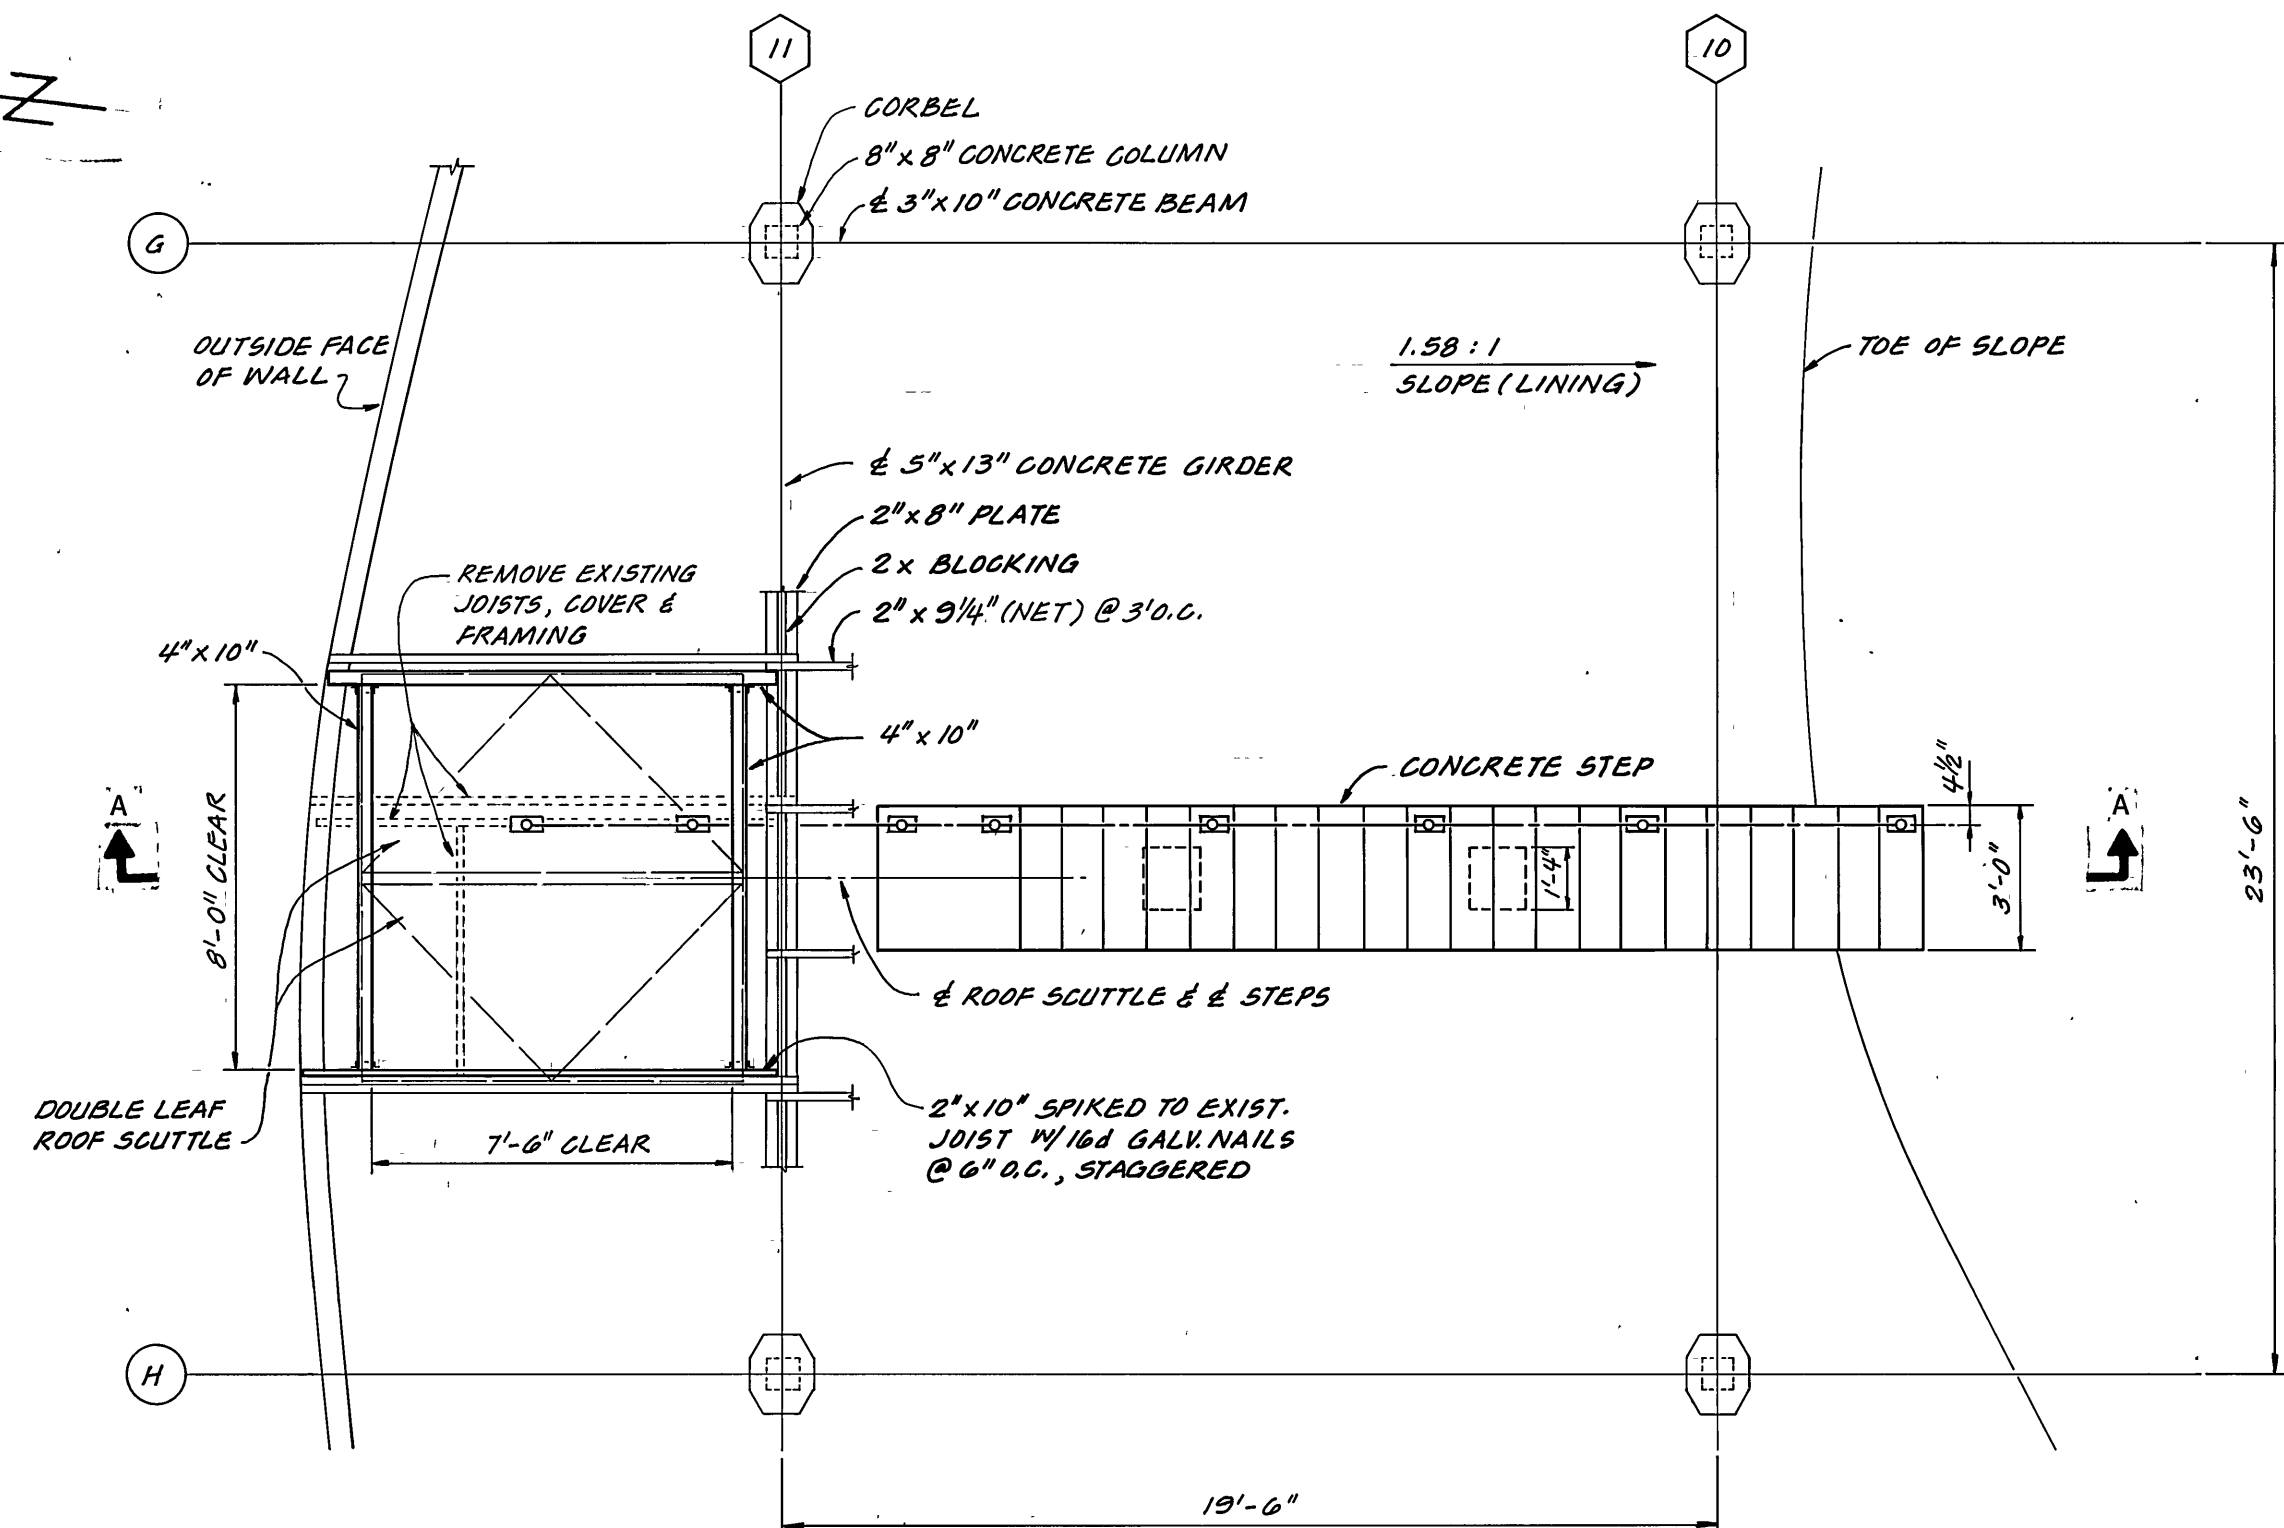

PLAN
1/4" = 1'-0"

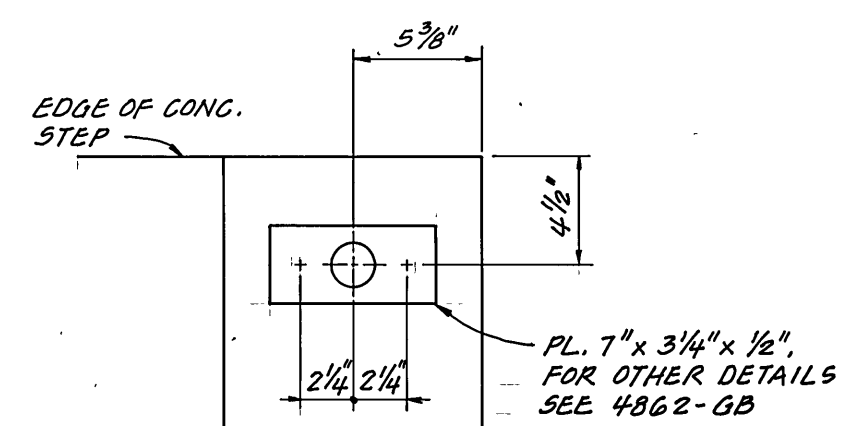

APPROVED *Orin D. Jordan*
CHIEF ENGINEER, R.P.E. NO. C 8216

DESIGN BY <i>L.A. Lee</i>	DESIGN CHECK BY	EAST BAY MUNICIPAL UTILITY DISTRICT OAKLAND, CALIFORNIA
DRAWN BY <i>M. L. FONG</i>	PIPELINE CORR <i>10m</i> FNDN	DINGEE RESERVOIR
PROJ. ENGR. R.P.E. NO. C 8696 <i>L.A. Lee</i>		STAIRWAY & HANDRAIL ADDITION
MGR. OF PLANT ENG'G. R.P.E. NO. M 015907 <i>M.P. Fong</i>	STRUCTURE OR ZONE DESIGNATION <i>7/7</i>	SCALE <i>AS SHOWN</i>
ASST. CH. ENG., DES. & CONST. R.P.E. NO. C 26724 <i>M.P. Fong</i>	DATE <i>1 JUL 82</i>	7283-G

NO.	DATE	REVISION	BY	APP.
1	8 DEC 83	IN SERVICE		
2	13 JUL 83	AS BUILT	<i>L. Lewis</i>	