


EAST BAY MUNICIPAL UTILITY DISTRICT SPECIAL DISTRICT NO. 1



Oakland, California

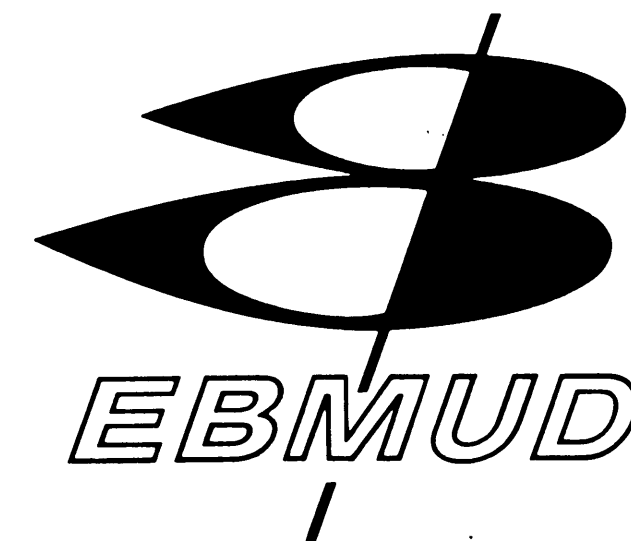


REPAIR OF DIGESTERS 1, 2, 3 & 4

Specification SD-180

**PART B
Drawings**

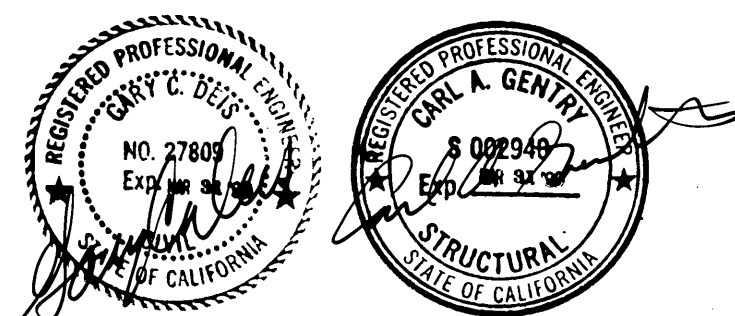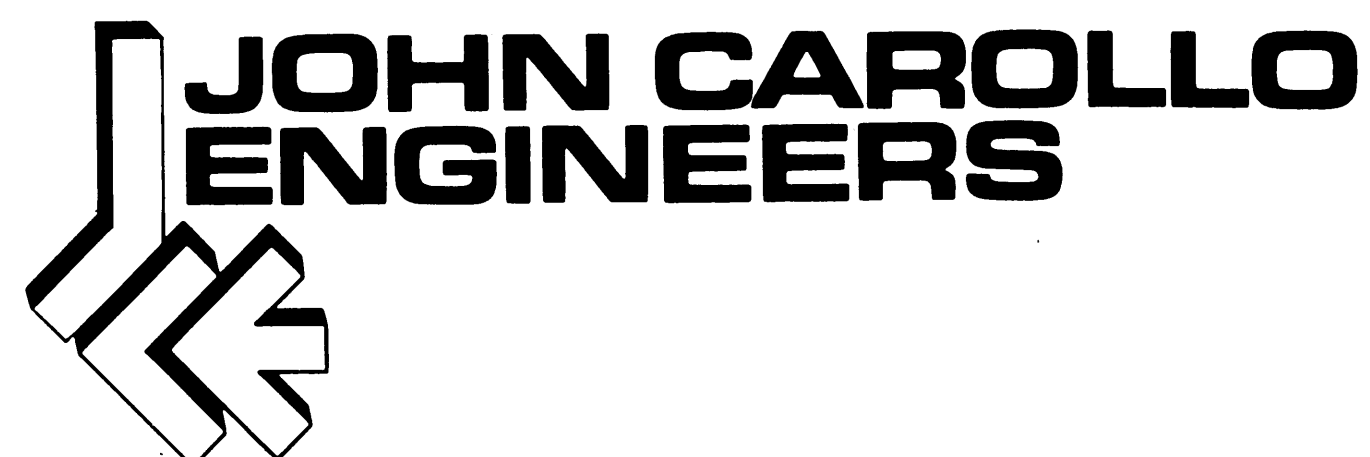

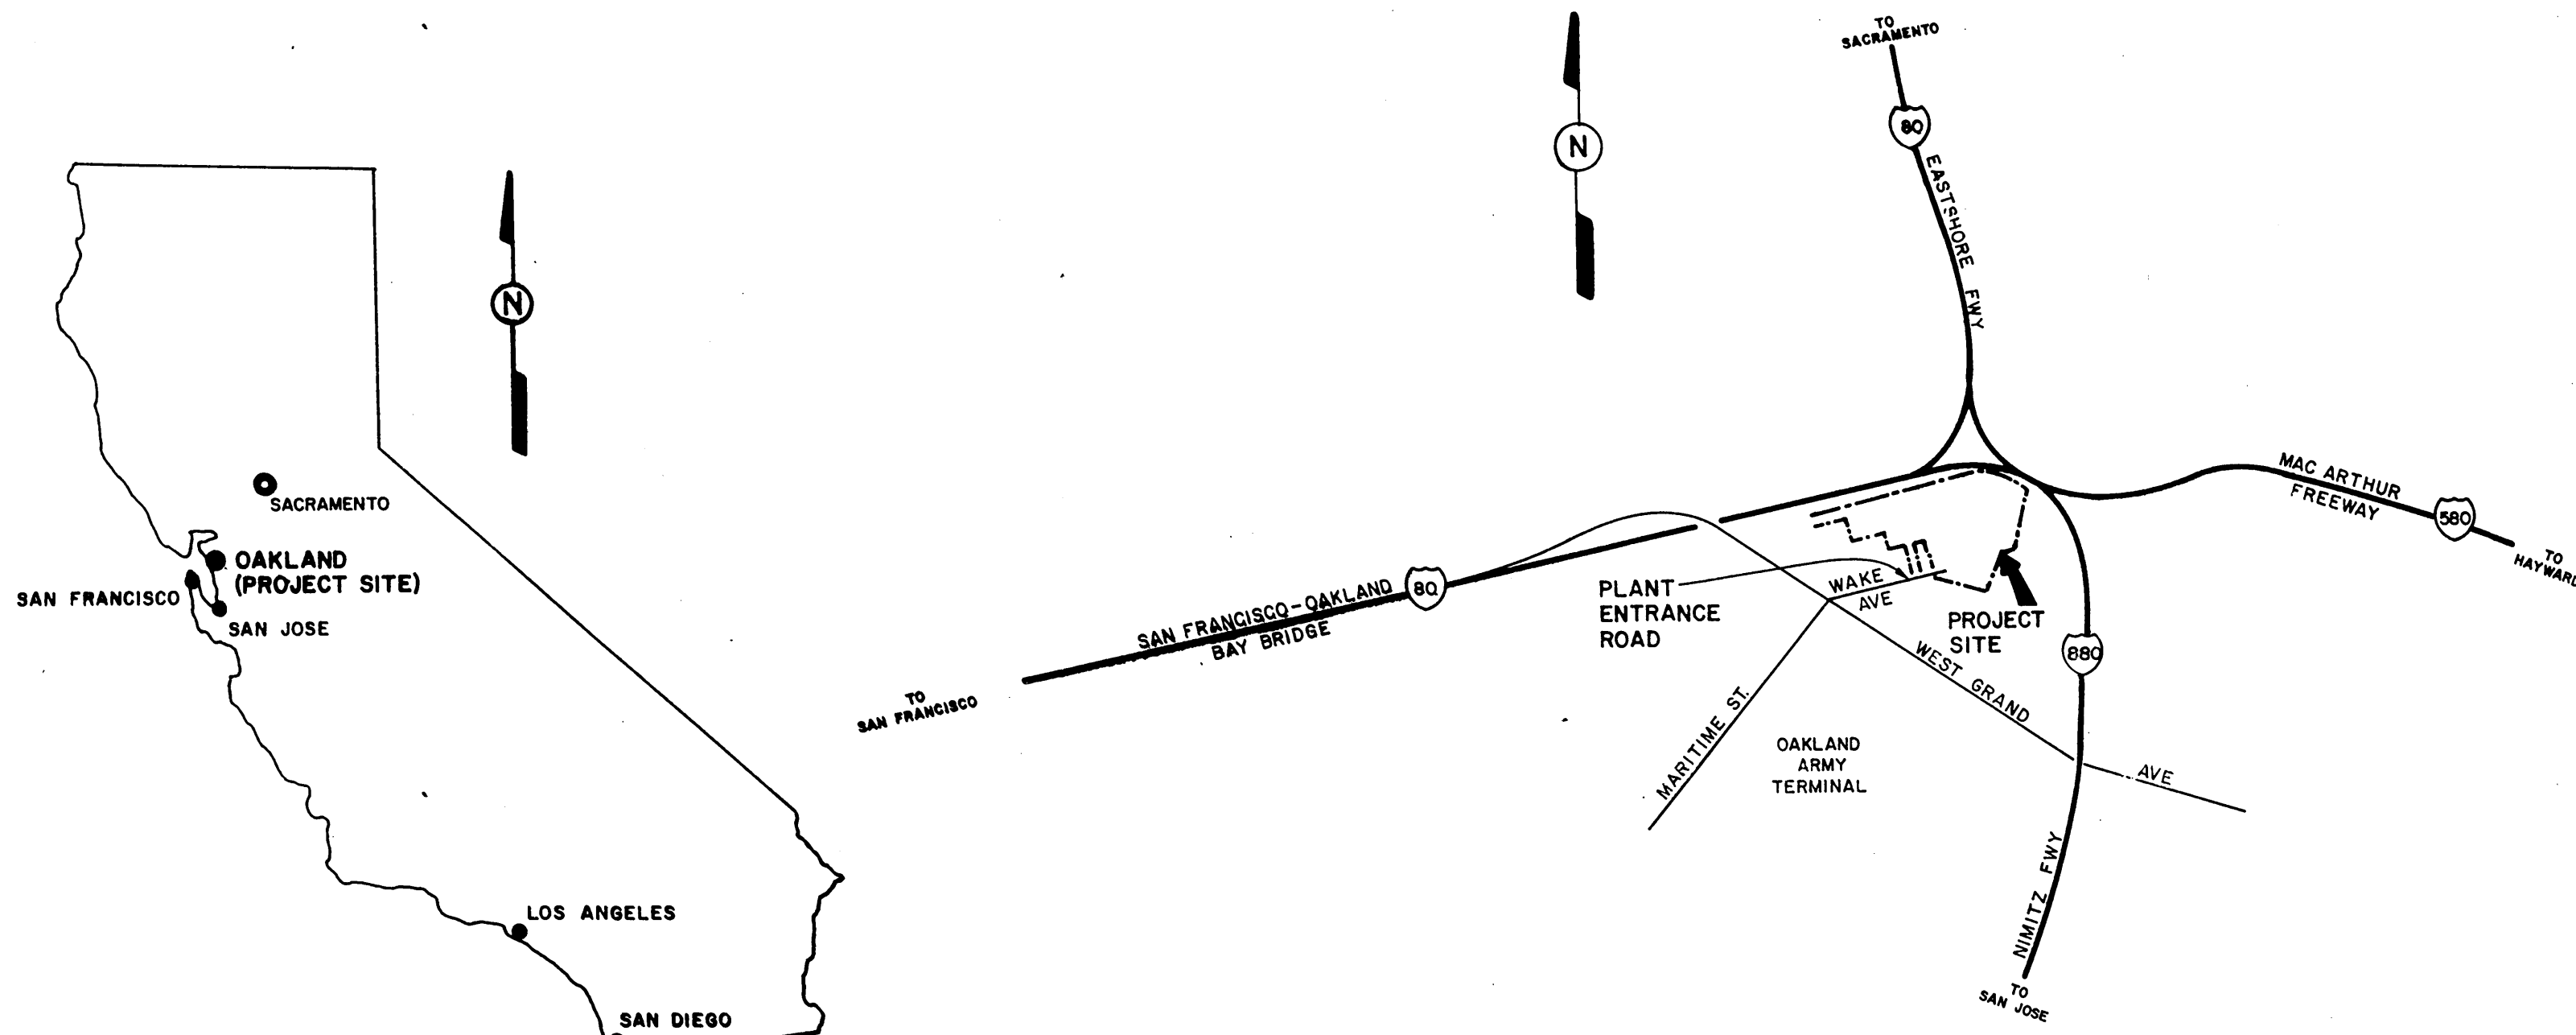

AREA MAP
STATE OF CALIFORNIA

LOCATION MAP

NEW STRUCTURES	
EXISTING STRUCTURES	
NEW PIPING	
EXISTING PIPING	
HIDDEN LINE	
CENTER, MONUMENT OR SURVEY LINE	
HAND RAIL	
EXISTING CONTOURS	
NEW CONTOURS	
NEW FENCE	
EXISTING FENCE	
REMOVE	
POWER POLE & LINE	
PROPERTY LINE OR RIGHT OF WAY	
SLOPE	
RAILROAD	
CITY LIMITS	
FUTURE ROAD	
EXISTING ROAD	
CURB & GUTTER	

NOTE: ALL SCREENED BACKGROUND IS EXISTING.

INDEX OF DRAWINGS

Sheet No.	Dwg. No.	Title
1.	G-1	TITLE SHEET
2.	G-2	LOCATION MAPS, INDEX AND DETAILS
3.	G-3	DIGESTER AREA PLAN
4.	S-1	COMPOSITE DEMOLITION WALL SECTIONS
5.	S-2	TYPICAL WALL SECTIONS AND DETAILS
6.	S-3	STRUCTURAL DETAILS
7.	M-1	PIPING SECTIONS
8.	M-2	MECHANICAL DETAILS

B LINE WORK

AB	ANCHOR BOLT	JT	JOINT
ABC	AGGREGATE BASE COURSE	LAB	LABORATORY
ACT	ACoustical TILE	LAV	LAVATORY
ALT	ALTERNATE	LP	LOW POINT OR LIQUID PROPANE
ALUM	ALUMINUM	LWS	LOW WATER SURFACE
ANCH	ANCHOR	MATL	MATERIAL
APPROX	APPROXIMATE	MAX	MAXIMUM
AT	AVERAGE	MCC	MOTOR CONTROL CENTER
AVG	AVERAGE	MECH	MECHANICAL
BD	BOARD	MFRS	MANUFACTURER'S
BLDG	BUILDING	MIN	MINIMUM
BLK	BLOCK	MK	MARK
CA	CONCRETE ANCHOR	NAT GR	NATURAL GRADE
CB	CATCH BASIN	N	NORTH
CL OR C	CENTER LINE	N/A	NOT APPLICABLE
CLR	CLEAR	NO OR #	NUMBER
CMU	CONCRETE MASONRY UNIT	NTS	NOT TO SCALE
CPLG	COUPLING	OC	ON CENTER
CW	COLD WATER	OD	OUTSIDE DIAMETER
CONC	CONCRETE	OPNG	OPENING
CONT	CONTINUATION, CONTINUOUS	PR	PAIR
CTSK	COUNTERSINK	PERP	PERPENDICULAR
CJ	CUBIC	PH OR Ø	PHASE
CU	DEGREE	PL	PLATE OR PROPERTY LINE
DEG	DOUBLE	R	RADIUS
DBL	DIAMETER	REINF	REINFORCEMENT
DIG	DIGESTER	REINFC	REINFORCING
DIST	DISTRIBUTION	REQD	REQUIRED
DWG	DRAWING	REV	REVISION
E	EAST	R/W	RIGHT OF WAY
EA	EACH	S	SOUTH
EF	EACH FACE	SCH	SCHEDULE
ELEC	ELECTRIC(AL)	SEL	SELECT
EL	ELEVATION	SGI	SINGLE
EQPT	EQUIPMENT	SHT	SHEET
EW	EACH WAY	SPEC	SPECIFICATION
EXIST	EXISTING	ST STL	STAINLESS STEEL
EXP	EXPANSION	STD	STANDARD
FB	FLAT BAR	STA	STATION
FLEX	FLEXIBLE	STL	STEEL
FG	FINISH GRADE	STRUCT	STRUCTURAL
FIG	FIGURE	SQ	SQUARE
FT	FOOT	SYMM	SYMMETRICAL
GALV	GALVANIZED	T & B	TOP & BOTTOM
GA	GAUGE	THK	THICK
GL	GLASS	TOS	TOP OF STEEL
GWB	GYPSUM WALL BOARD	TOW	TOP OF WEIR
H/E	HOOK ONE END	TYP	TYPICAL
HZE	HOOK TWO ENDS	VERT	VERTICAL
HDWR	HARDWARE	VOL	VOLUME
HORIZ	HORIZONTAL	W	WEST
HW	HOT WATER	W/O	WITH OUT
HP	HIGH POINT	WS	WATER SURFACE
HWS	HIGH WATER SURFACE	WWF	WELDED WIRE FABRIC
ID	INSIDE DIAMETER		
IN OR	INCH		
INV	INVERT		

DETAIL OR SECTION IDENTIFICATION
DETAIL OR SECTION TAKEN ON THE SAME SHEET
DETAIL OR SECTION MAY BE TAKEN ON SEVERAL DIFFERENT SHEETS
DETAIL OR SECTION IS TAKEN ON THE DRAWING INDICATED

AT TITLE

DETAIL OR SECTION IDENTIFICATION
DETAIL OR SECTION IS TO BE FOUND ON THE SAME SHEET
DETAIL OR SECTION IS TO BE FOUND ON THE DRAWING INDICATED

AT CROSS REFERENCE

D DRAWING CROSS REFERENCING

C ABBREVIATIONS

SPECIFICATION SD-180

REPAIR OF DIGESTERS 1, 2, 3 & 4

DESIGNED BY	CAG
DESIGN CHECKED BY	DMM
DRAWN BY	ELP/RMK
SR. PROJ. ENGR.	
APPROVED	GCD
PRINCIPAL-IN-CHARGE, R.P.E. NO. C	


PROJECT ENG.	R.P.E. NO. C
PROJECT MGR.	R.P.E. NO. C 26855
MGR. OF SUPPORT SERVICES	R.P.E. NO. C 29111
MANAGER OF WASTEWATER	R.P.E. NO. C 26855

EAST BAY MUNICIPAL UTILITY DISTRICT
SPECIAL DISTRICT No. 1
OAKLAND, CALIFORNIA

LOCATION MAPS INDEX AND DETAILS

DRAWN BY	DRAWING No.
SCALE	G-2
DATE	SHEET 2 OF 8

DIETZCH POST REORDER NO. 117768

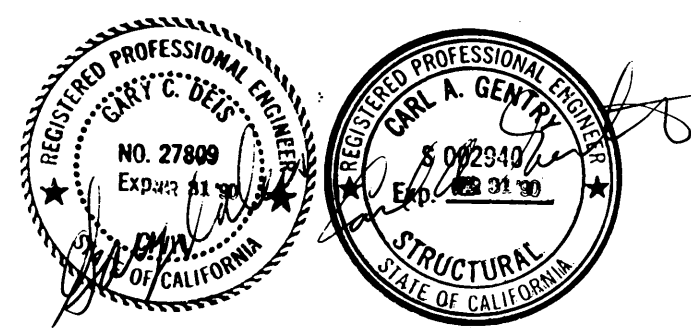


A SITE PLAN

SCALE 1" = 100'


JOHN CAROLLO ENGINEERS
PHOENIX, AZ • WALNUT CREEK, CA
FOUNTAIN VALLEY, CA • VISALIA, CA
SAN BERNARDINO, CA • TUCSON, AZ
SAN DIEGO, CA • BAKERSFIELD, CA

NO.	DATE	REVISION	BY	REC.	APP.
1	31 MAR 93	AS BUILT	W. J. J. J.	W. J. J.	W. J. J.

JOB NO.
3134A.10

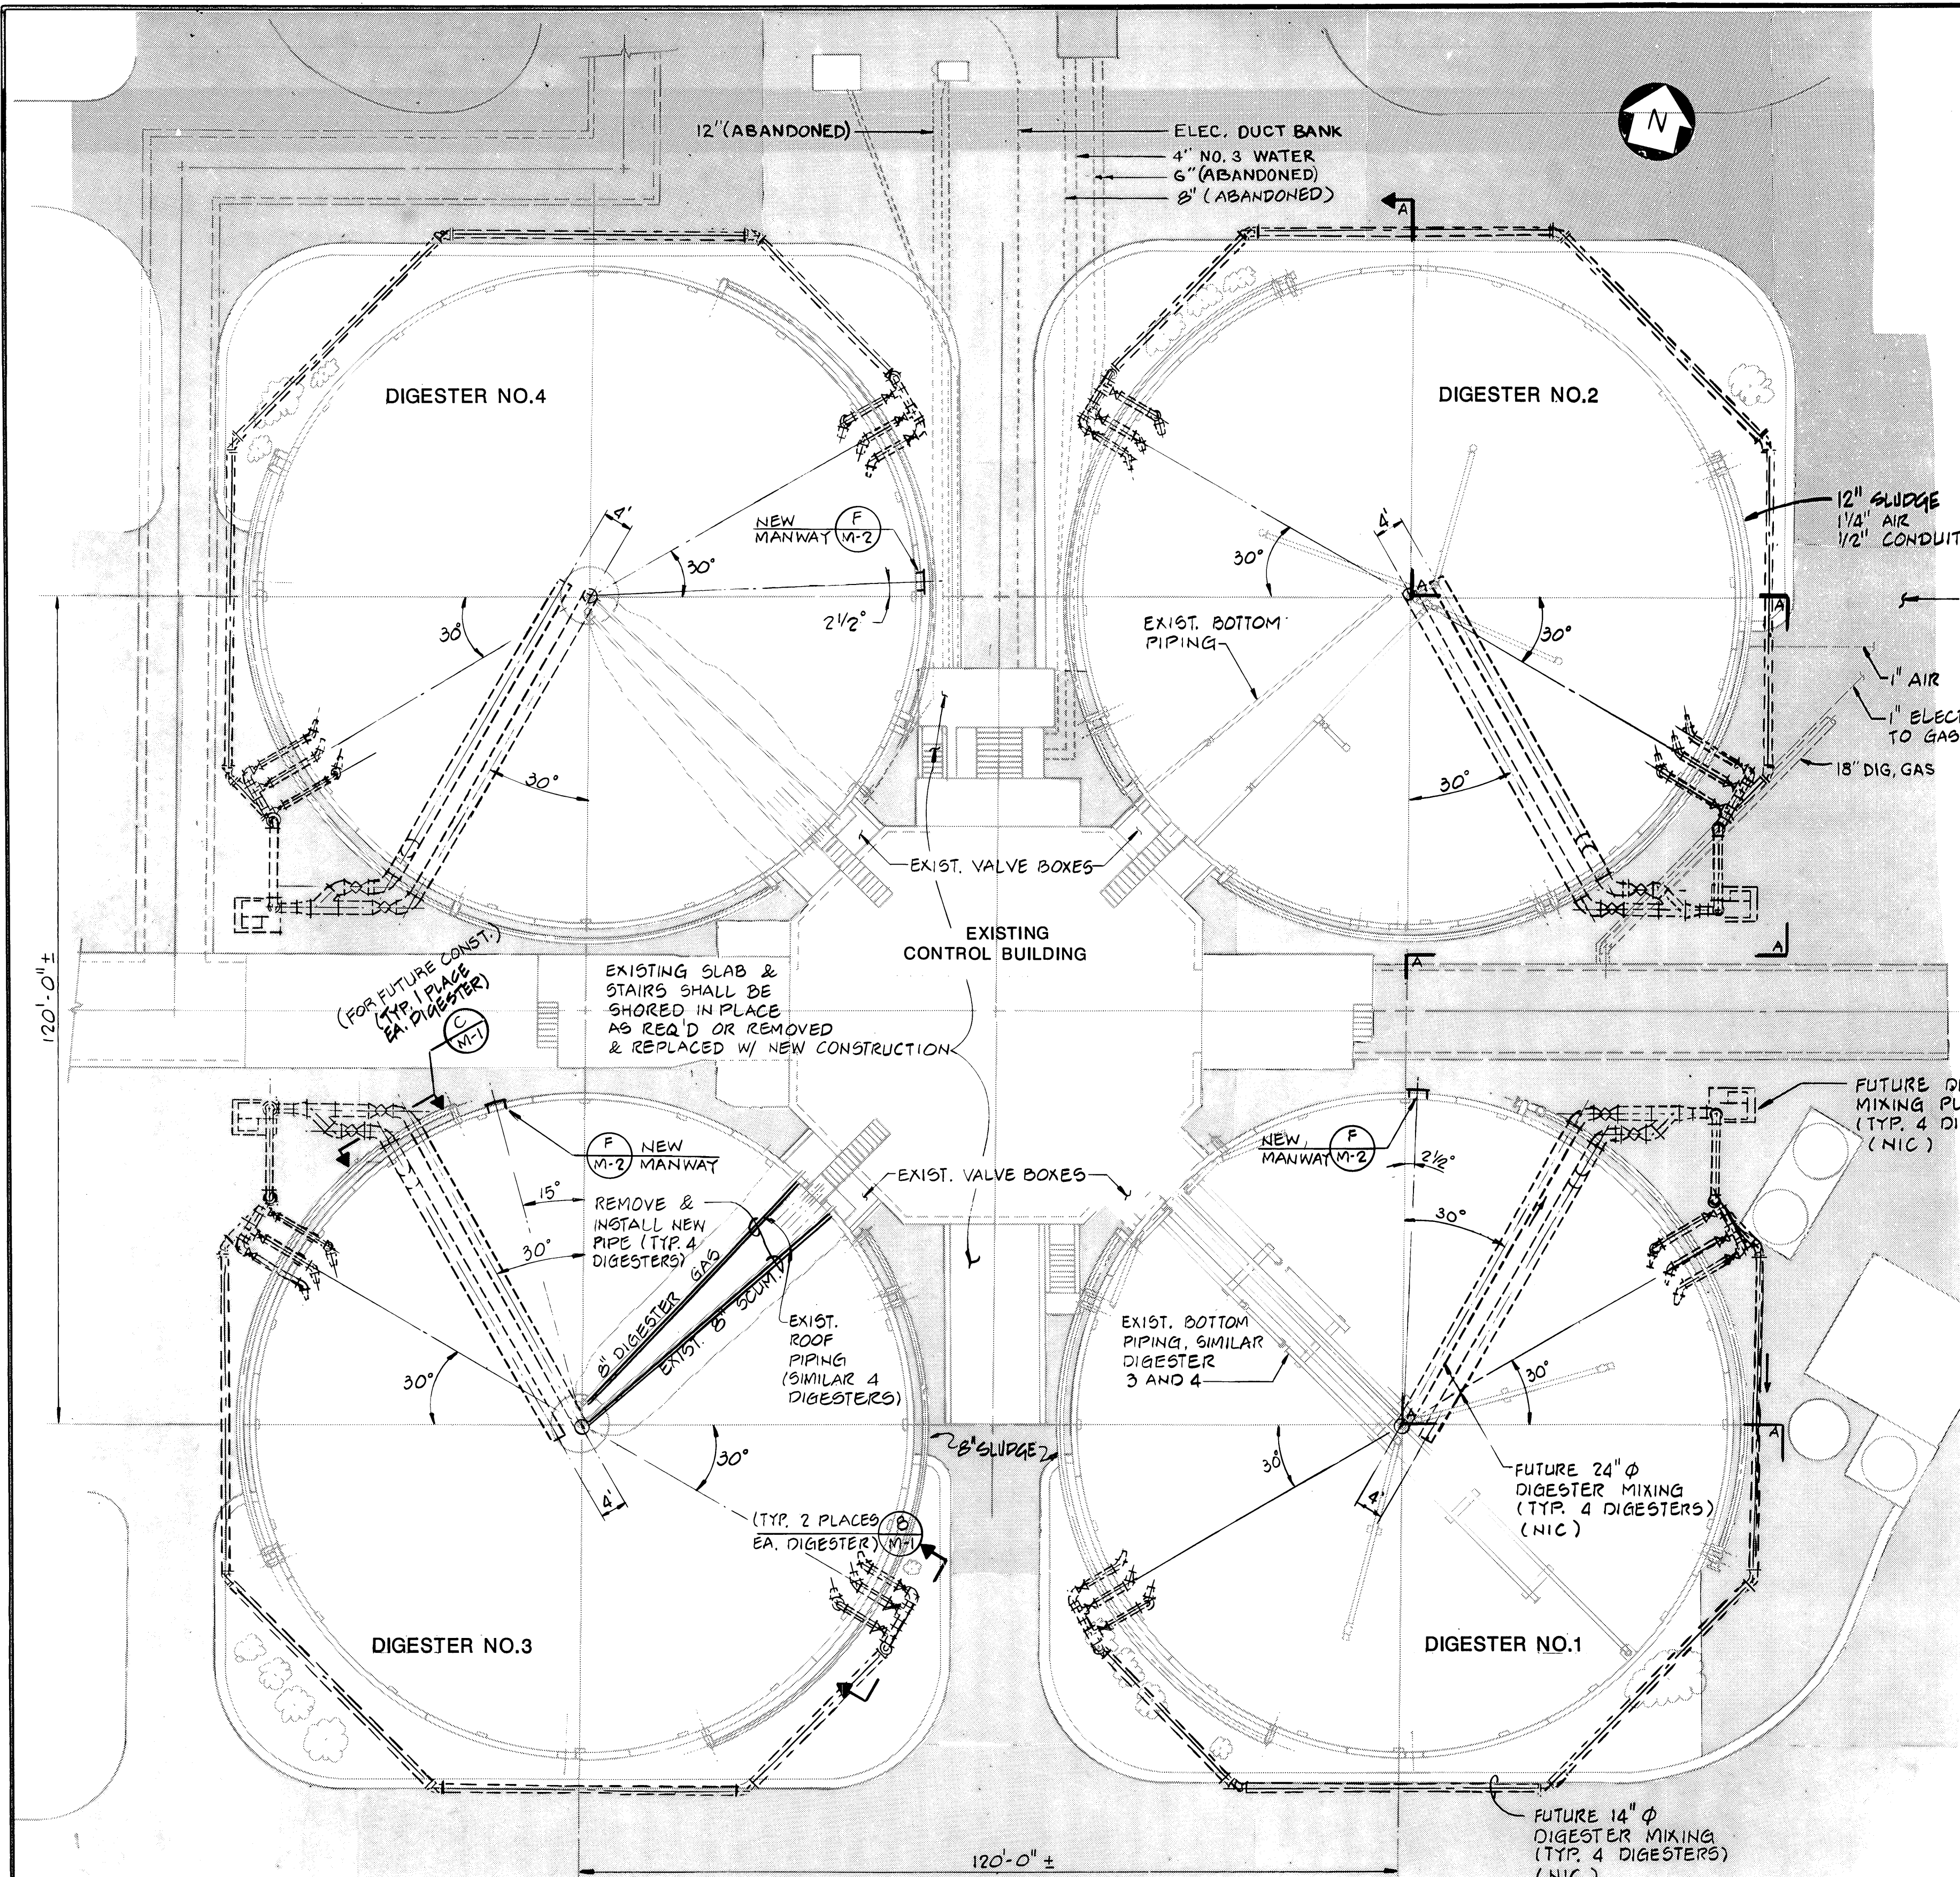


- NOTES:
1. SEE DRAWING S-1 FOR DEMOLITION WALL SECTIONS.
 2. SEE DRAWING S-2 FOR TYPICAL WALL SECTIONS, LOCATIONS OF NEW BARS, AND SHOTCRETE.
 3. NOT ALL LANDSCAPING IS SHOWN. EXISTING LANDSCAPING SHALL BE SAVED AND PROTECTED TO THE MAXIMUM EXTENT POSSIBLE.
 4. REMOVE AND REPLACE EXISTING PIPING AND CONDUITS AS REQUIRED.
 5. SEE (G) FOR DETAIL FOR REPLACEMENT OF CONCRETE CURB AND PAVING. REPLACE ALL CURB AND PAVING DAMAGED IN REPAIRING THE DIGESTERS.

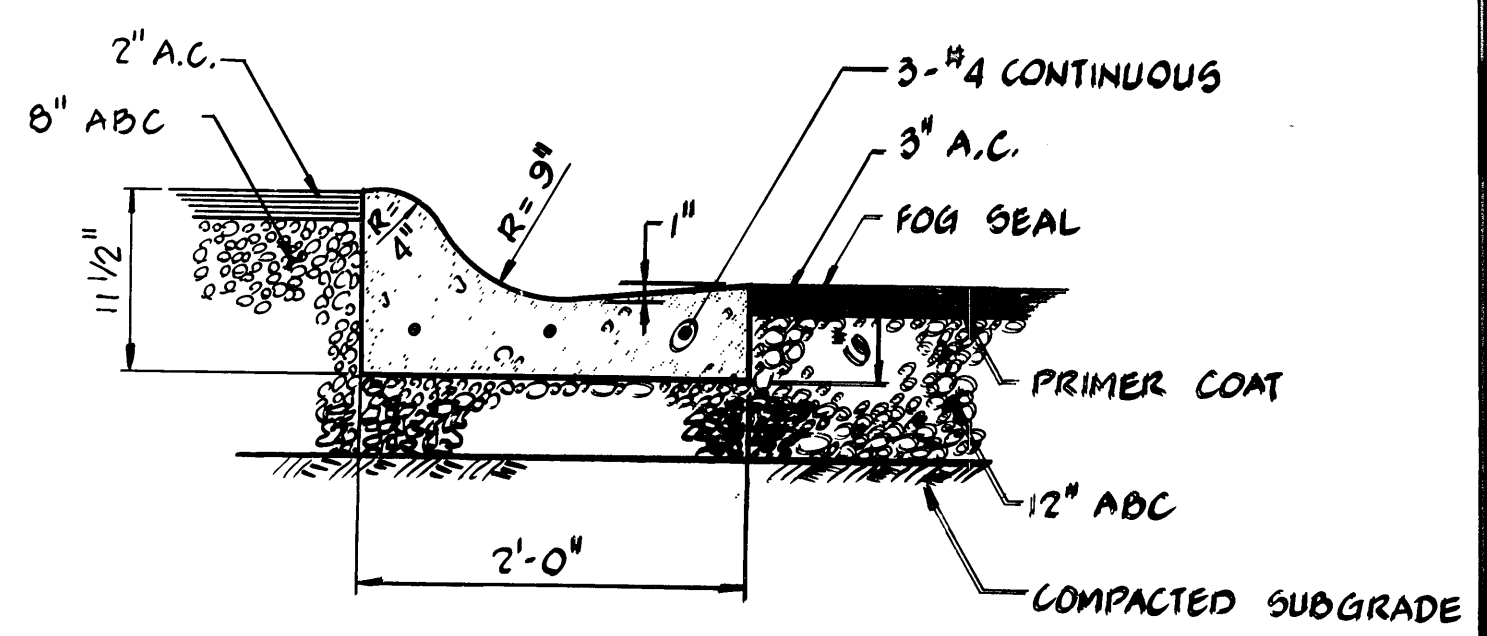

(G) CONCRETE CURB AND PAVING DETAIL
1" = 1'-0"

(F) DIGESTER AREA PLAN
1" = 15'

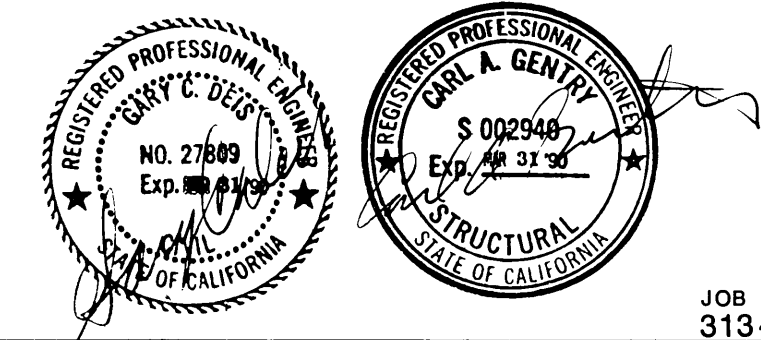

JOHN CAROLLO ENGINEERS
PHOENIX, AZ • WALNUT CREEK, CA
FOUNTAIN VALLEY, CA • VISALIA, CA
SAN BERNARDINO, CA • TUCSON, AZ
SAN DIEGO, CA • BAKERSFIELD, CA

NO.	DATE	REVISION	BY	REC.	APP.
11-16-88		SLEEVES NOTED FOR FUTURE CONST.	Rmc		
31 MAR 93		AS BUILT	Walt Williams	RW	CEBS 705

SPECIFICATION SD-180
**REPAIR OF
DIGESTERS 1, 2, 3 & 4**


DESIGNED BY	CAG
DESIGN CHECKED BY	DMM
DRAWN BY	ELP/so
SR. PROJ. ENGR.	—
APPROVED	GCD
PRINCIPAL-IN-CHARGE, R.P.E. NO. C	

PROJECT ENG.	R.P.E. No. C
PROJECT MGR.	R.P.E. No. C 23317
MGR. OF SUPPORT SERVICES	R.P.E. No. C 29111
MANAGER OF WASTEWATER	R.P.E. No. C 26855

**EAST BAY MUNICIPAL UTILITY DISTRICT
SPECIAL DISTRICT NO. 1
OAKLAND, CALIFORNIA**

DIGESTER AREA PLAN


DRAWN BY	DRAWING No.
SCALE	G-3
DATE	SHEET 3 OF 8

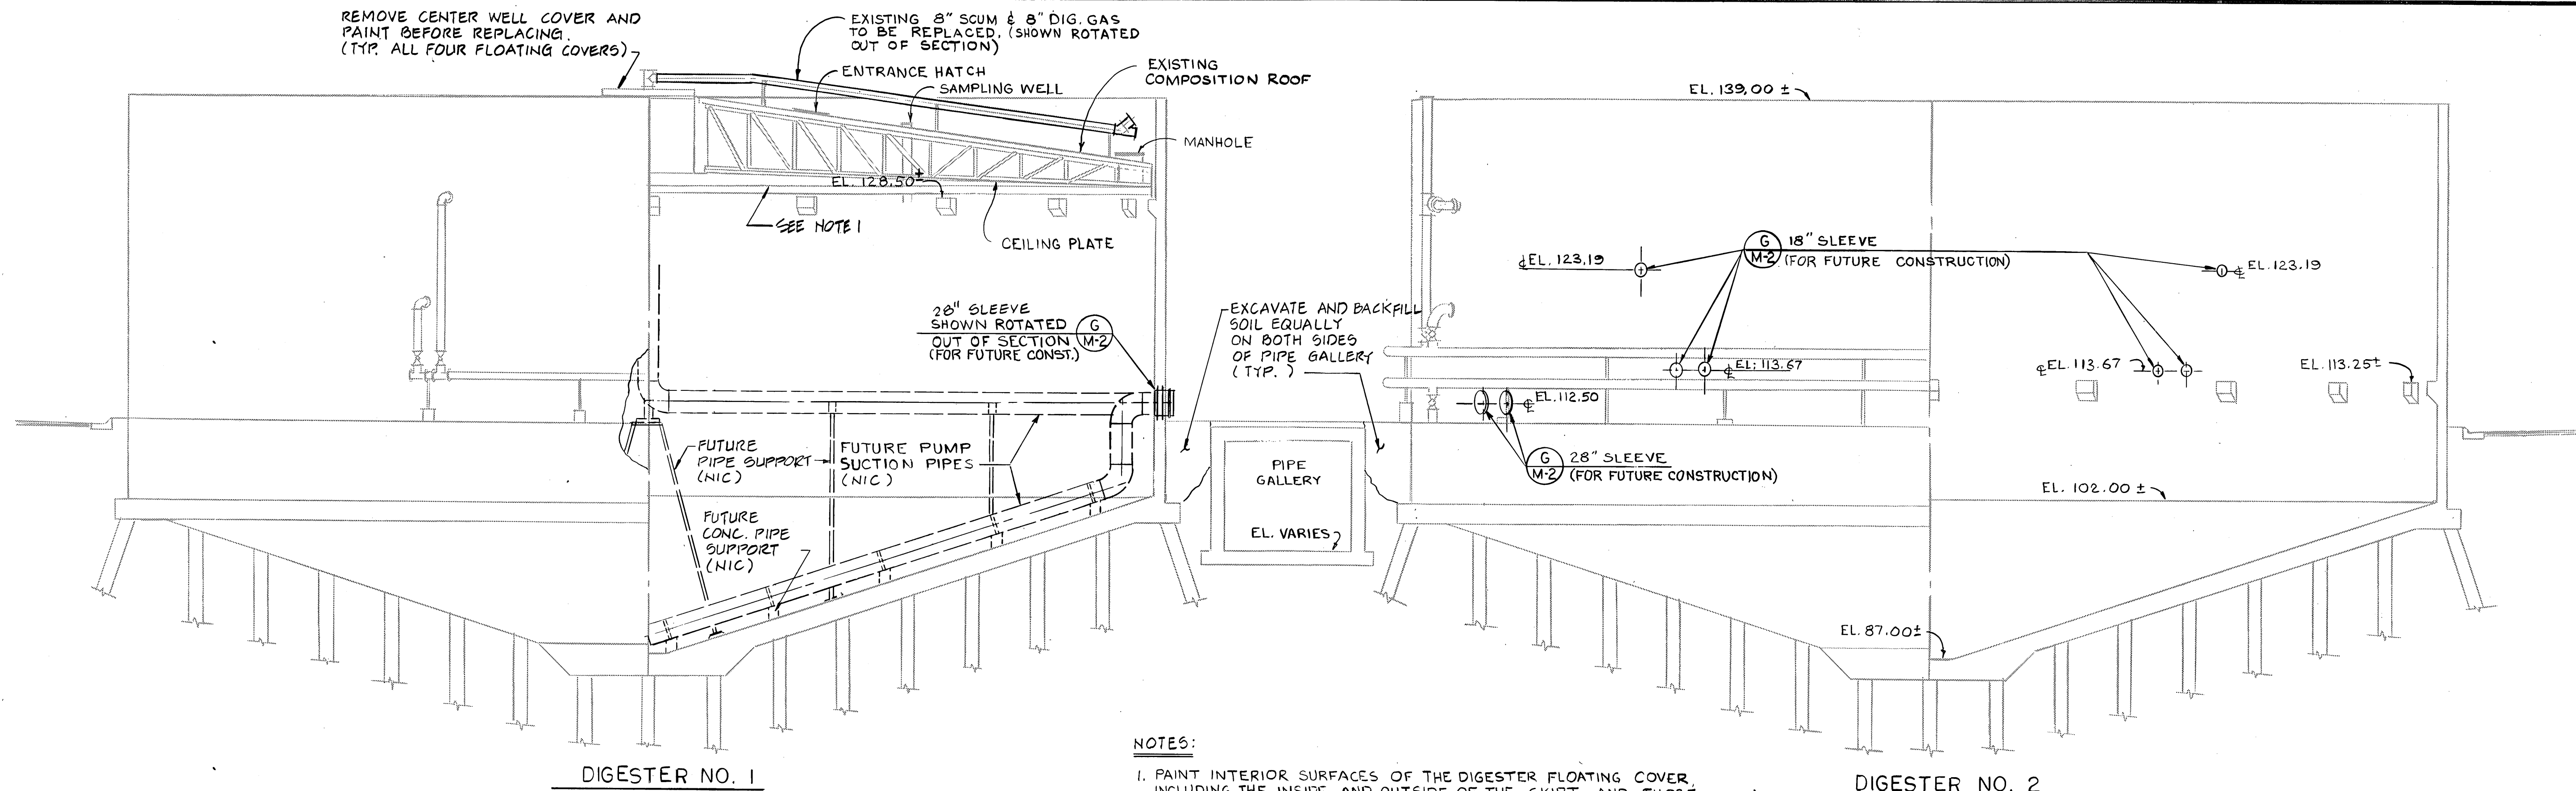

NOTES:

1. PAINT INTERIOR SURFACES OF THE DIGESTER FLOATING COVER, INCLUDING THE INSIDE AND OUTSIDE OF THE SKIRT AND THOSE PORTIONS OF THE CEILING PLATE AND CENTER WELL NORMALLY IN CONTACT WITH SLUDGE OR DIGESTER GAS.

A SECTION
1/8" = 1'-0"

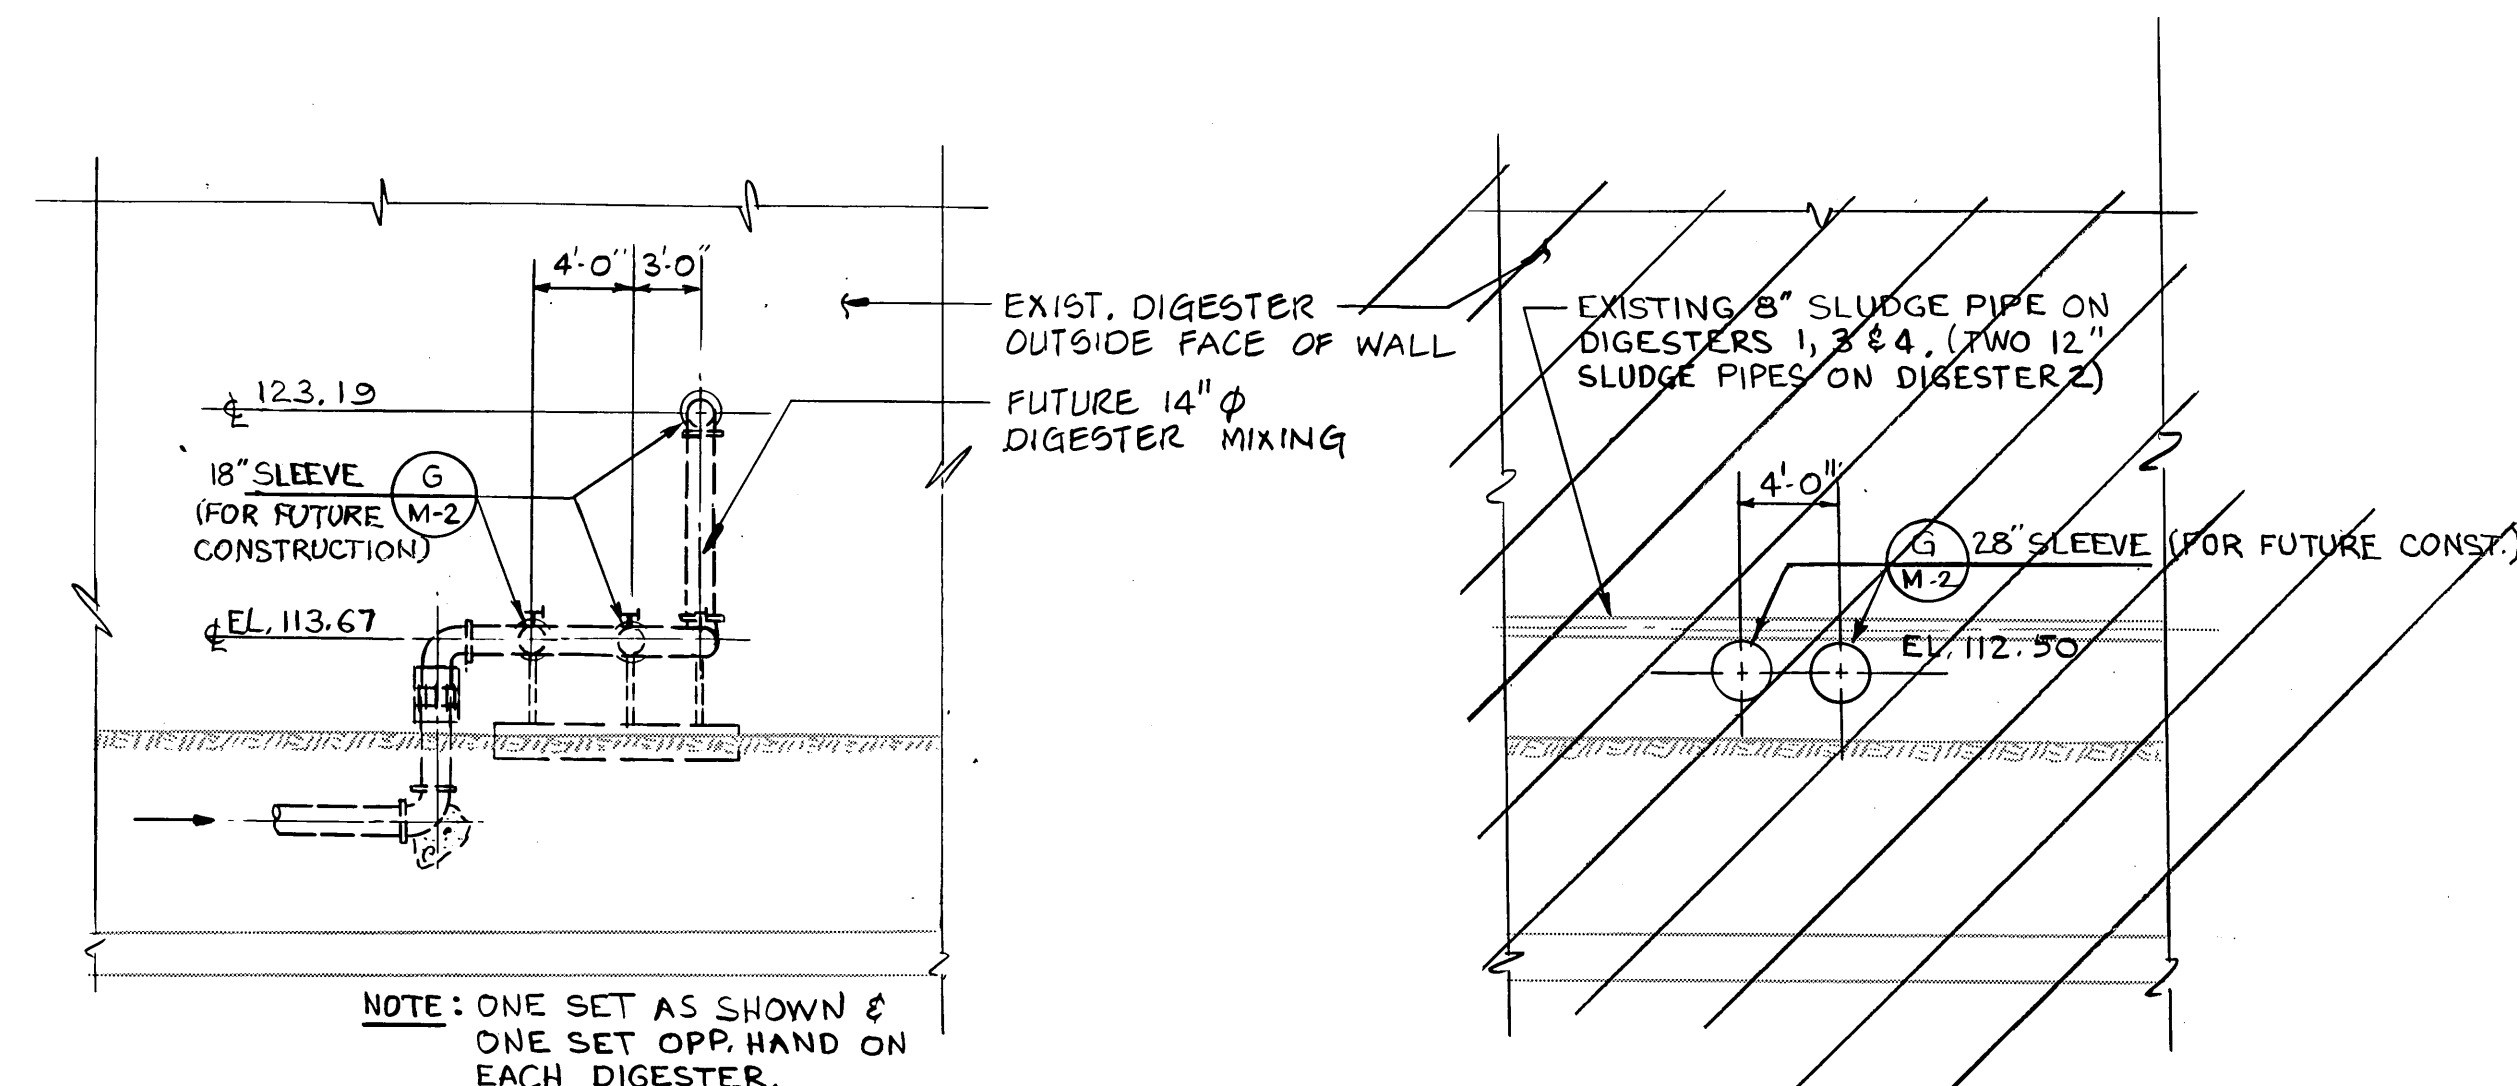

B SECTION
1/8" = 1'-0"

C SECTION
1/8" = 1'-0"

EAST BAY MUNICIPAL UTILITY DISTRICT
SPECIAL DISTRICT No. 1
OAKLAND, CALIFORNIA

PIPING SECTIONS

DRAWN BY: _____
SCALE: _____
DATE: _____
DRAWING No. **M-1**
SHEET 7 OF 8

JOHN CAROLLO ENGINEERS

PHOENIX, AZ • WALNUT CREEK, CA
FOUNTAIN VALLEY, CA • VISALIA, CA
SAN BERNARDINO, CA • TUCSON, AZ
SAN DIEGO, CA • BAKERSFIELD, CA


JOB NO.
3134A.10

NO.	DATE	REVISION	BY	REC.	APP.
1	11/14/88	SLEEVES NOTED FOR FUT. CONST.	ELP	CAG	


SPECIFICATION SD-180
**REPAIR OF
DIGESTERS 1, 2, 3 & 4**

DESIGNED BY: CAG
DESIGN CHECKED BY: DMM
DRAWN BY: ELP/RMK
SR. PROJ. ENGR.: _____
APPROVED: GCD
PRINCIPAL-IN-CHARGE, R.P.E. NO. C




PROJECT ENG. R.P.E. No. C
PROJECT MGR. R.P.E. No. C 33317
MGR. OF SUPPORT SERVICES R.P.E. No. C 29111
MANAGER OF WASTEWATER R.P.E. No. C 26855
R. A. Bishop

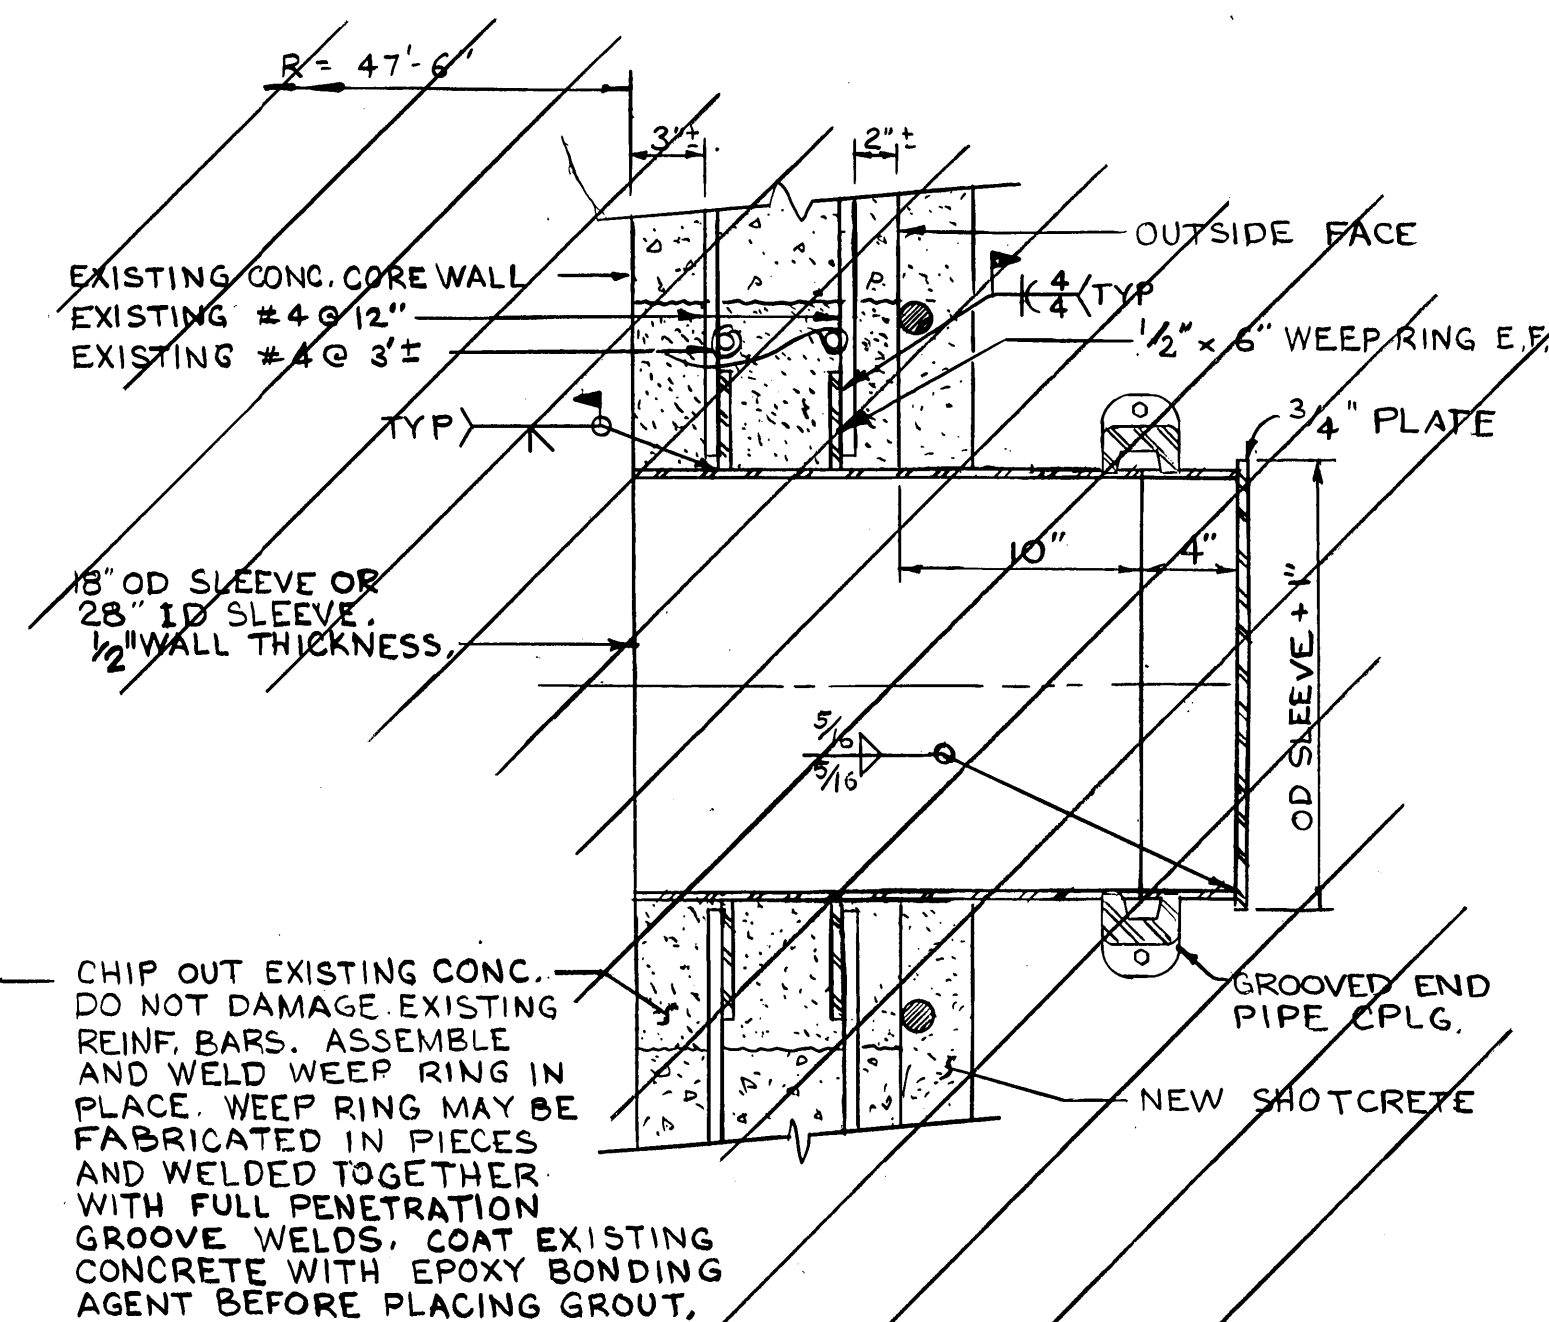

1. **FILL HOLE WITH EPOXY GEL BEFORE INSERTING REINFORCING BAR.**
2. **DRILL HOLES WITH IMPACT DRILL TO OBTAIN ROUGH HOLE SURFACE. THE HOLE SHALL BE CLEAN AND DRY.**
3. **THE REINFORCING BAR SHALL BE FREE OF OIL, PAINT, DIRT, OR OTHER COATINGS THAT WILL REDUCE BOND.**
4. **DO NOT DAMAGE OR CUT EXISTING REINFORCING BARS. IF THE DRILL HITS AN EXISTING REINFORCING BAR, OR OTHER OBSTRUCTION, STOP DRILLING AND FILL THE HOLE WITH DRYPACK MORTAR. RELOCATE HOLE FOR REINFORCING BAR AND DRILL ANOTHER HOLE. REPEAT UNTIL A HOLE FOR REINFORCING BAR HAS BEEN DRILLED TO THE REQUIRED DEPTH.**

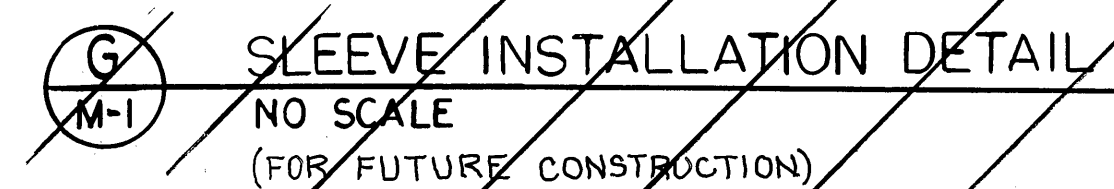

DELETED

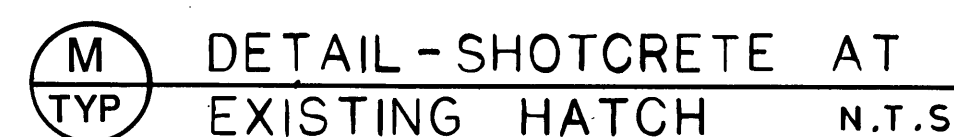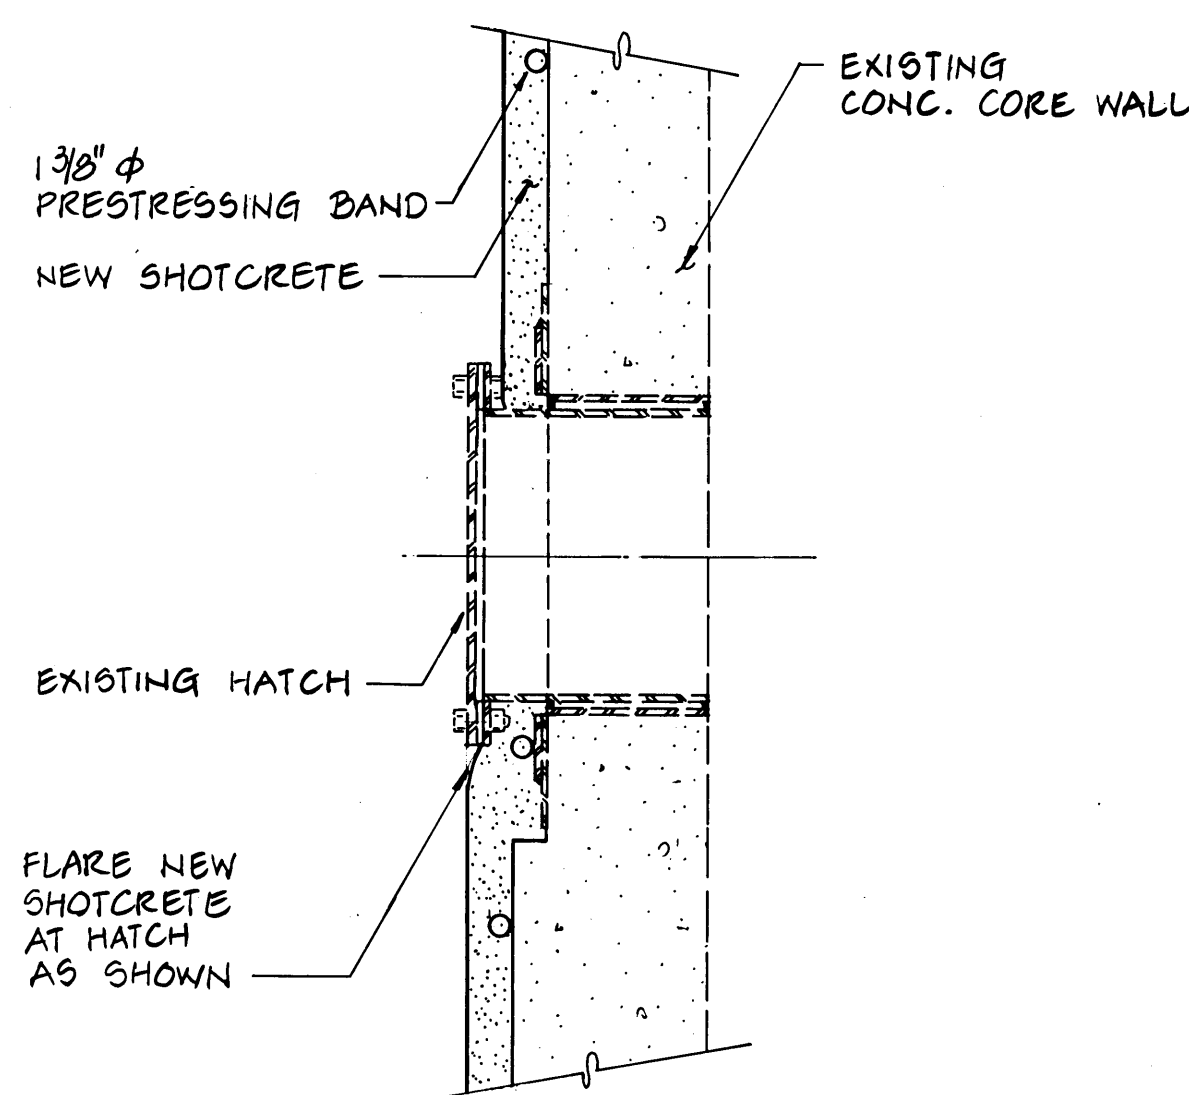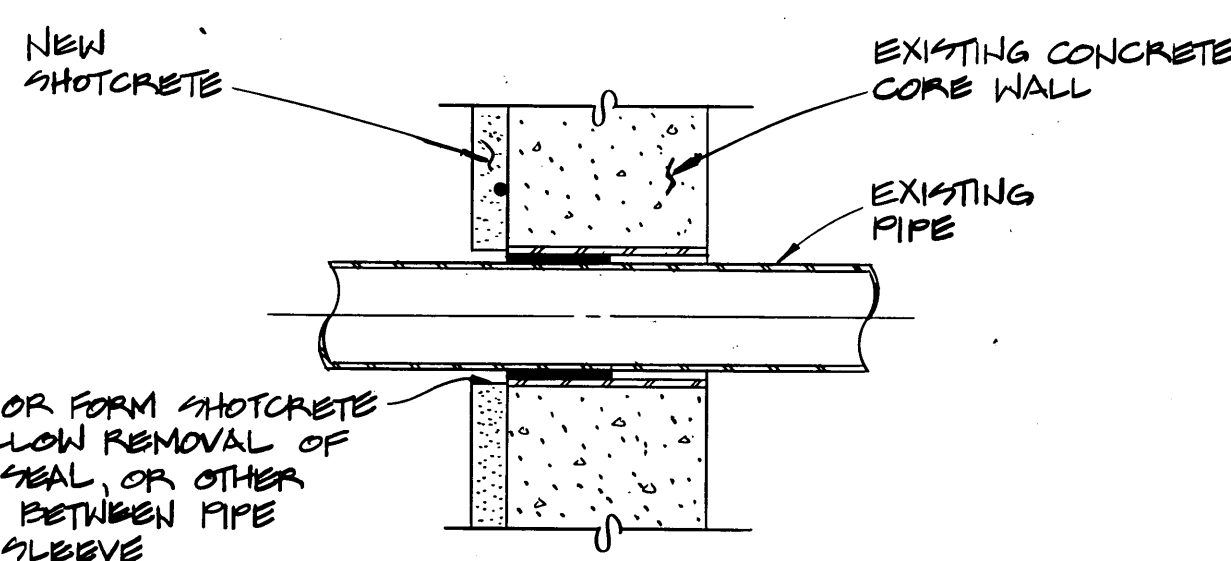

SPECIFICATION SD-180

REPAIR OF DIGESTERS 1, 2, 3 & 4

DESIGNED BY	CA
DESIGN CHECKED BY	DM
DRAWN BY	ELP/RM
SR. PROJ. ENGR.	
APPROVED	GCD
PRINCIPAL-IN-CHARGE, R.P.E. NO. C	

EMUD	PROJECT ENG. R.P.E. No. C	<i>P.A. Clinton</i>
	PROJECT MGR. C-233	<i>W. K. Kelly</i>
	R.P.E. No. C33317	<i>W. K. Kelly</i>
	MGR. OF SUPPORT SERVICES R.P.E. No. C29111	
	<i>Deanne M. Dren</i>	
	MANAGER OF WASTEWATER R.P.E. No. C 26855	<i>Walter L. Richards</i>

**EAST BAY MUNICIPAL UTILITY DISTRICT
SPECIAL DISTRICT No. 1
OAKLAND, CALIFORNIA**

MECHANICAL DETAILS


DRAWN BY	DRAWING No. M-2
SCALE	
DATE	

SHEET	8	OF	8
-------	---	----	---



JOB NO.
3134A.10

[illegible]

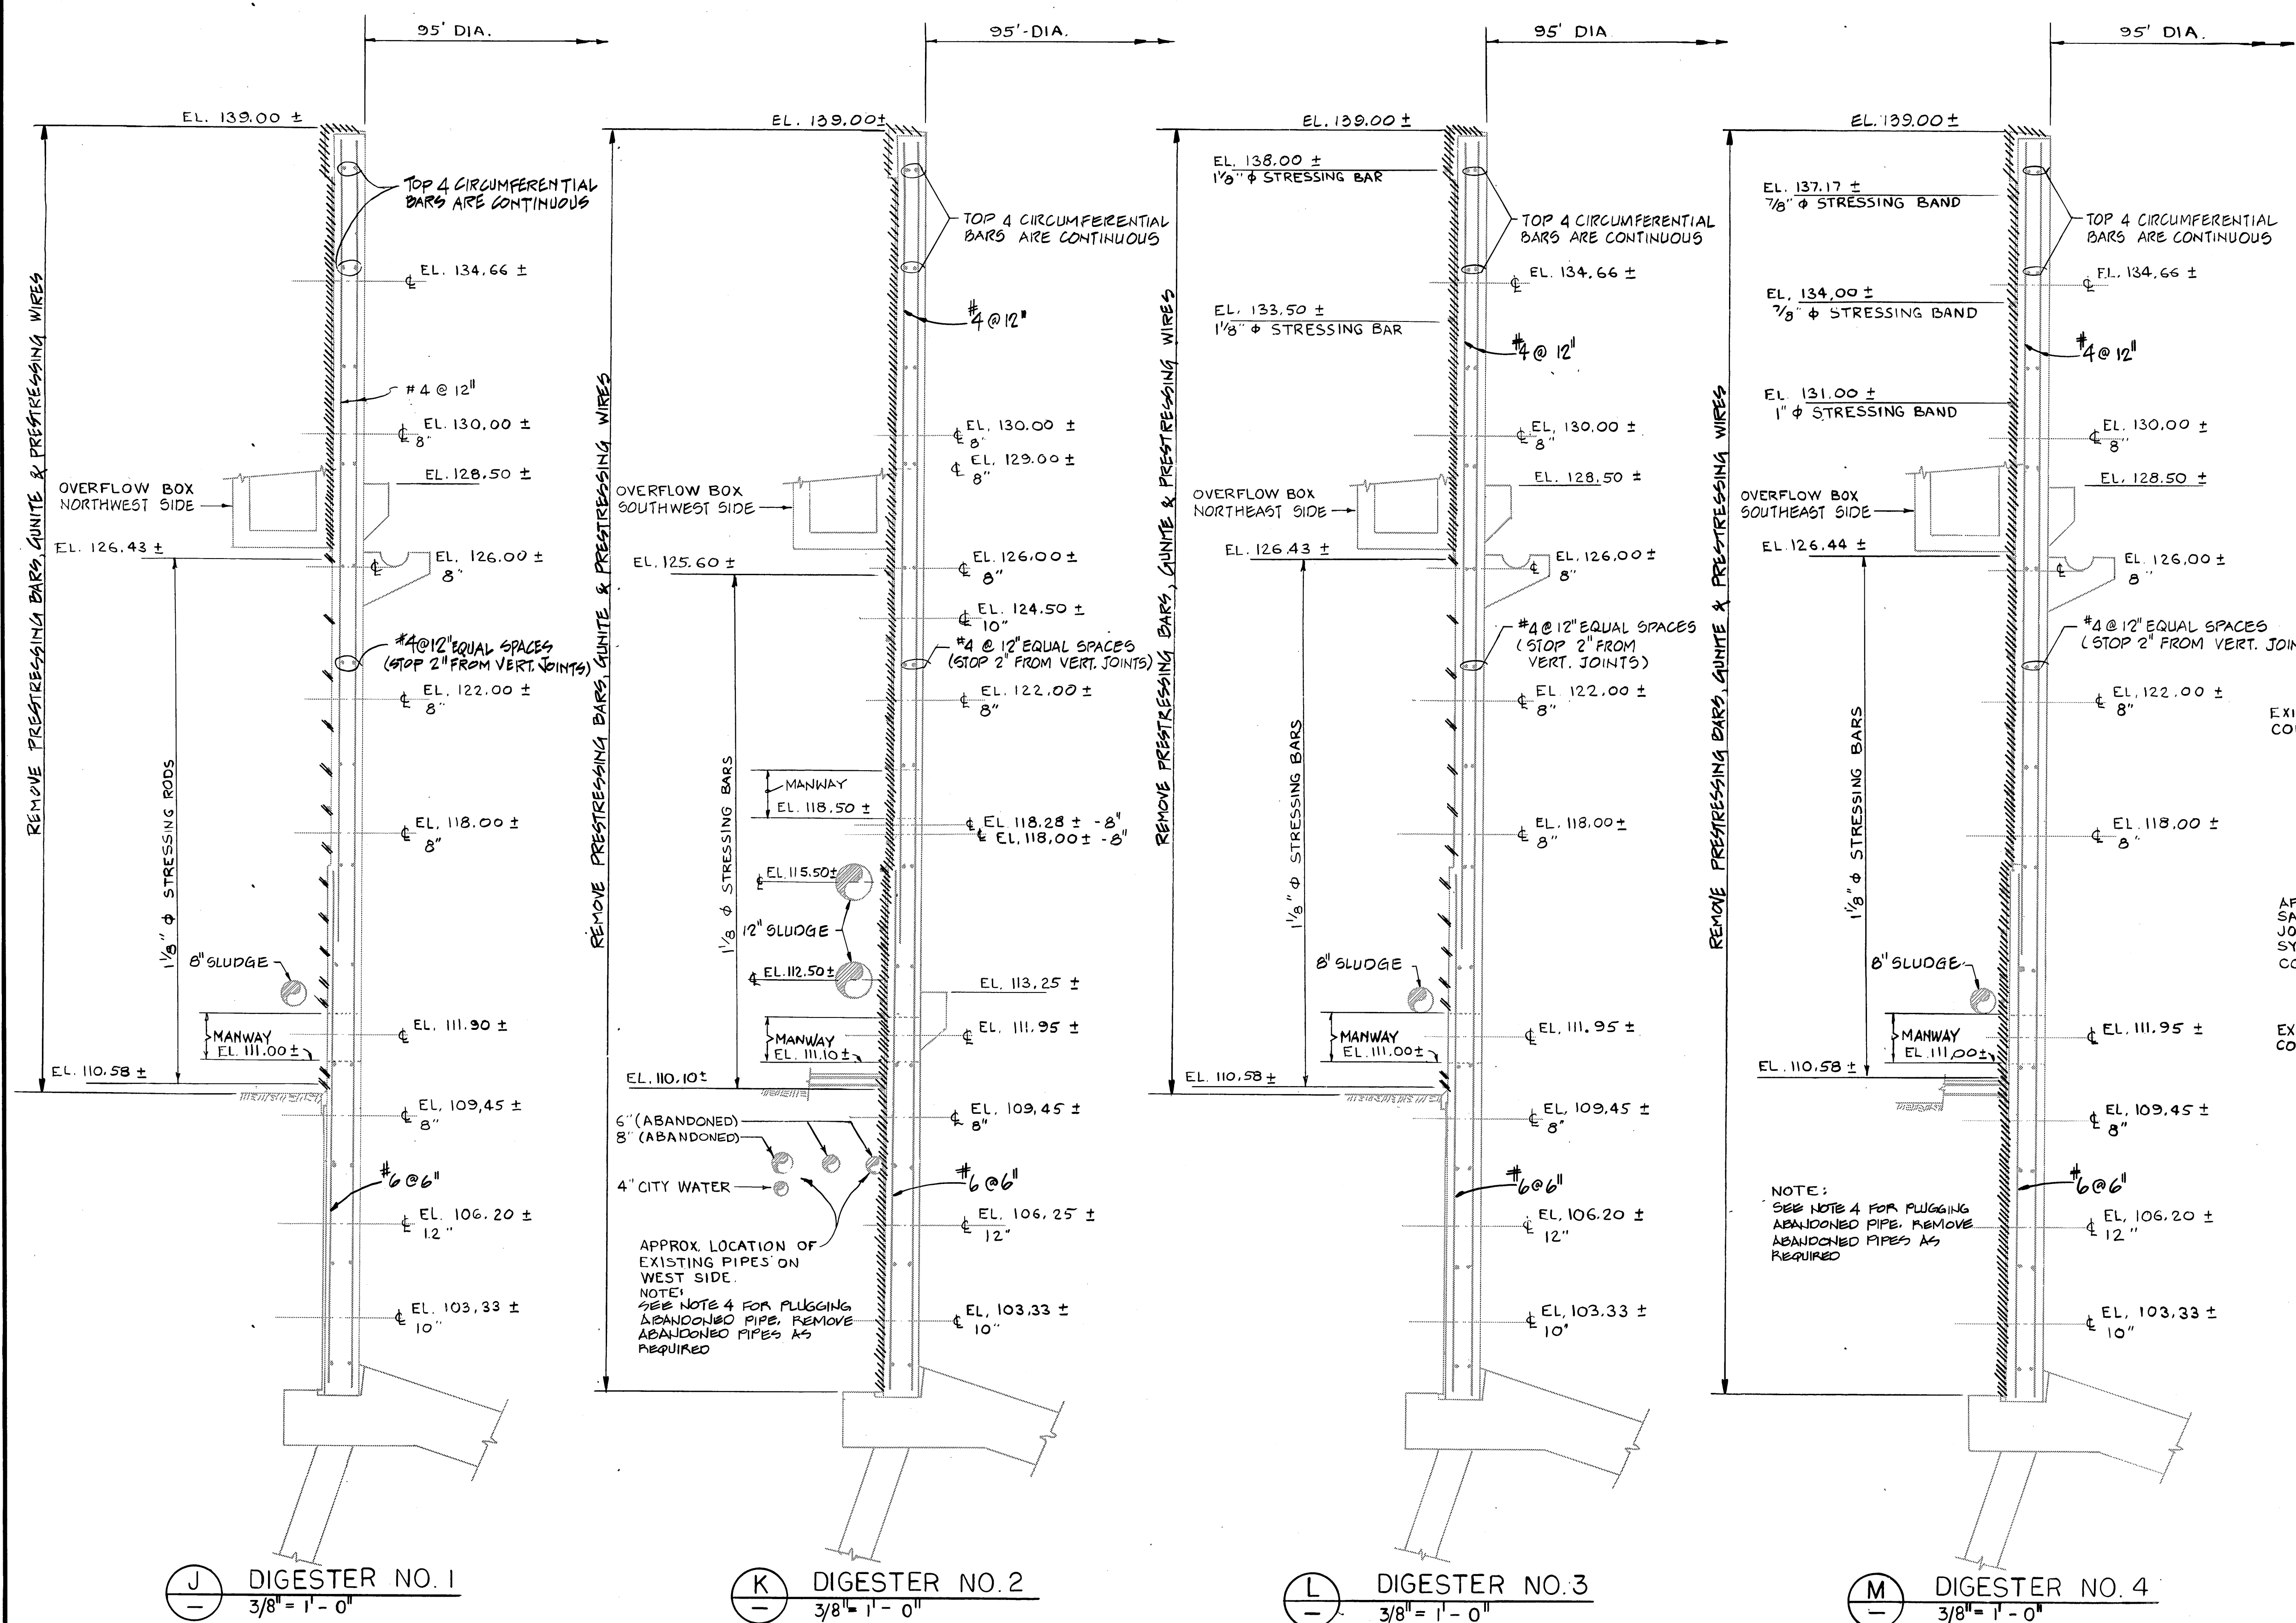


- NOTES:**
- THE WALL SECTIONS ARE COMPOSITE WALL SECTIONS SHOWING PIPES AND PIPE PENETRATIONS AT VARIOUS PLACES AROUND THE DIGESTERS.
 - ONLY THE TOP FOUR HORIZONTAL REINFORCING BARS ARE CONTINUOUS AROUND THE DIGESTER. DUE TO THE AGE OF THE DIGESTERS, THE REINFORCING BARS SHOULD BE ASSUMED TO BE CORRODED. TEMPORARY PRESTRESSING BARS OR WALL BRACES SHALL BE INSTALLED TO KEEP THE WALLS STABLE DURING CONSTRUCTION AFTER THE EXISTING WIRES AND BARS HAVE BEEN REMOVED.
 - THE COVER SHALL BE SHORED IN PLACE DURING THE PERIOD THAT THE EXISTING PRESTRESSING WIRE AND BARS HAVE BEEN REMOVED FROM THE WALL AND BEFORE THE NEW PRESTRESSING BARS ARE INSTALLED. THE COVER LOAD SHALL NOT BE SUPPORTED BY THE TANK WALLS.
 - THE REMAINING ENDS OF ABANDONED PIPE CUT FOR CONSTRUCTION SHALL BE FILLED FOR 3' LENGTH WITH GROUT.
- VERTICAL CONSTRUCTION JOINT DIGESTERS 1, 3 & 4 NO SCALE**
- AFTER INSTALLING PRESTRESSING BARS SANDBLAST & THOROUGHLY CLEAN JOINT IMMEDIATELY BEFORE APPLYING SYNTHETIC RUBBER SEALING COMPOUND
- REMOVE EXISTING WATER SEAL.
- VERTICAL CONSTRUCTION JOINT DIGESTER 2 NO SCALE**

J DIGESTER NO. 1
3/8" = 1' - 0"

K DIGESTER NO. 2
3/8" = 1' - 0"

L DIGESTER NO. 3
3/8" = 1' - 0"

M DIGESTER NO. 4
3/8" = 1' - 0"

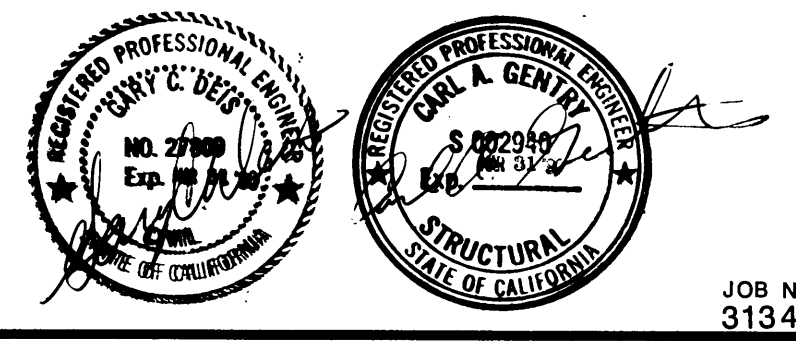

JOHN CAROLLO ENGINEERS
PHOENIX, AZ • WALNUT CREEK, CA
FOUNTAIN VALLEY, CA • VISALIA, CA
SAN BERNARDINO, CA • TUCSON, AZ
SAN DIEGO, CA • BAKERSFIELD, CA

NO.	DATE	REVISION	BY	REC.	APP.
1	31 MAR 93	AS BUILT	W. H. H. RW	123	775

SPECIFICATION SD-180
REPAIR OF
DIGESTERS 1, 2, 3 & 4

DESIGNED BY	CAG
DESIGN CHECKED BY	DMM
DRAWN BY	ELP/RMK
SR. PROJ. ENGR.	
APPROVED	GCD
PRINCIPAL-IN-CHARGE, R.P.E. NO. C	

PROJECT ENG. R.P.E. NO. C	PA. Clifton
PROJECT MGR. R.P.E. NO. C	PA. Clifton
MGR. OF SUPPORT SERVICES R.P.E. NO. C	PA. Clifton
MANAGER OF WASTEWATER R.P.E. NO. C	PA. Clifton

EAST BAY MUNICIPAL UTILITY DISTRICT
SPECIAL DISTRICT No. 1
OAKLAND, CALIFORNIA


COMPOSITE DEMOLITION
WALL SECTIONS

DRAWN BY: DATE: SCALE: SHEET 4 OF 8


DRAWING No. **S-1**

GENERAL NOTES:

- EXISTING SLUDGE PIPE, WATER PIPES AND ELECTRICAL CONDUITS LOCATED ON THE SIDE OF THE DIGESTER AND BELOW GRADE AT THE DIGESTER WHICH MAY INTERFERE WITH WORK ARE NOT ALL DETAILED. RELOCATION OF INTERFERING PIPES AND ELECTRICAL CONDUITS, AND REALIGNMENT OF PRESTRESSING BANDS SHALL BE COMPLETED AS NECESSARY. THE CONTRACTOR SHALL VISIT THE JOB SITE AND REVIEW THE LOCATION OF INTERFERENCES WHICH MAY AFFECT PLACING PRESTRESSING BANDS ON THE DIGESTERS BEFORE BIDDING THE JOB.
- PROVIDE OFFSET SPACERS FOR REINSTALLATION OF ELECTRICAL CONDUIT, PIPING, INDICATOR PANELS, ALARMS AND APPURTENANCES AFTER PRESTRESSING BARS ARE INSTALLED AND PAINTED. ALL WIRING REMOVED SHALL BE REPLACED WITH NEW ELECTRICAL WIRING.
- SEE DETAILS (D), (E) AND (F) FOR PRESTRESSING BAND DETAILS.
- SPECIFIED STRENGTH OF CONCRETE CORE WALL IS 4500 POUNDS PER SQUARE INCH FOR DIGESTER 2 AND 3000 POUNDS PER SQUARE INCH FOR DIGESTER 1, 3 AND 4.
- REMOVE ALL REMAINING MORTAR FROM SNAP TIE CONE HOLES ON INSIDE FACE AND OUTSIDE FACE OF WALLS ON DIGESTERS 1, 2, 3 AND 4. ON DIGESTERS 1 AND 3, THE SNAP TIE CONE HOLE ON THE OUTSIDE FACE OF WALL BEHIND THE GUNITE THAT WILL REMAIN IN PLACE, SHALL NOT BE REPAIRED. REMOVE RUST AND ROUGHEN CONCRETE IN SNAP TIE CONE HOLES. THEN COAT HOLES WITH EPOXY AND FILL HOLES WITH EPOXY GROUT.
- SEE SPECIFICATION SECTION 031100 FOR INSTALLATION OF PRESTRESSING BANDS.
- SEE DETAILS (P) AND (Q) FOR JOINT DETAILS.

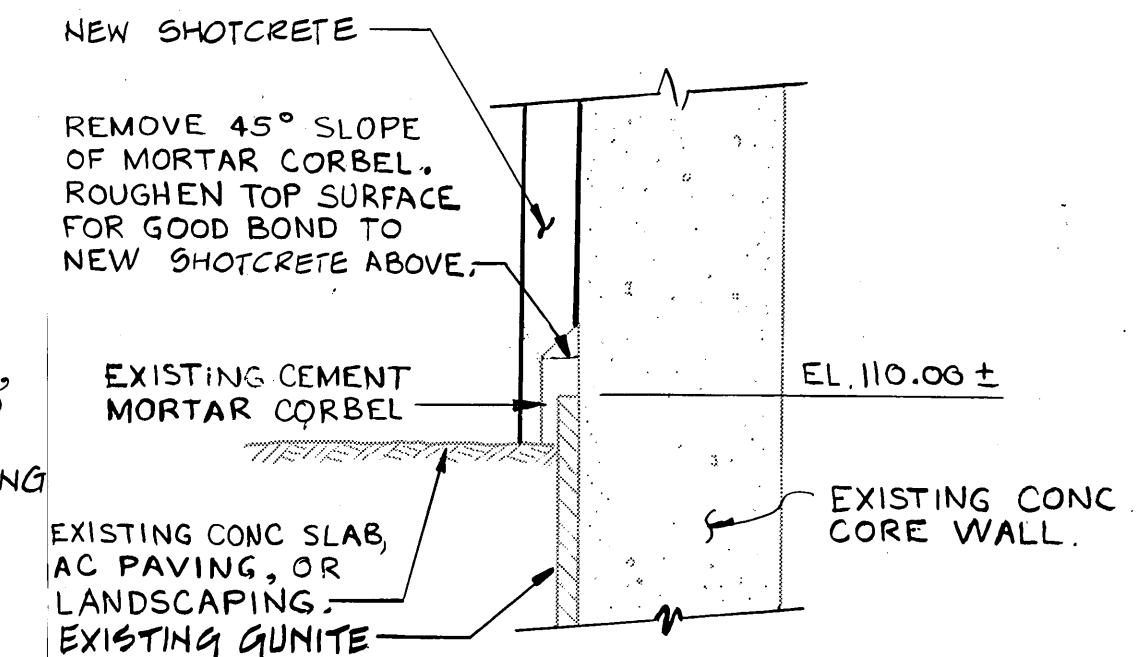

(T) SHOTCRETE JOINT DETAIL
NO SCALE

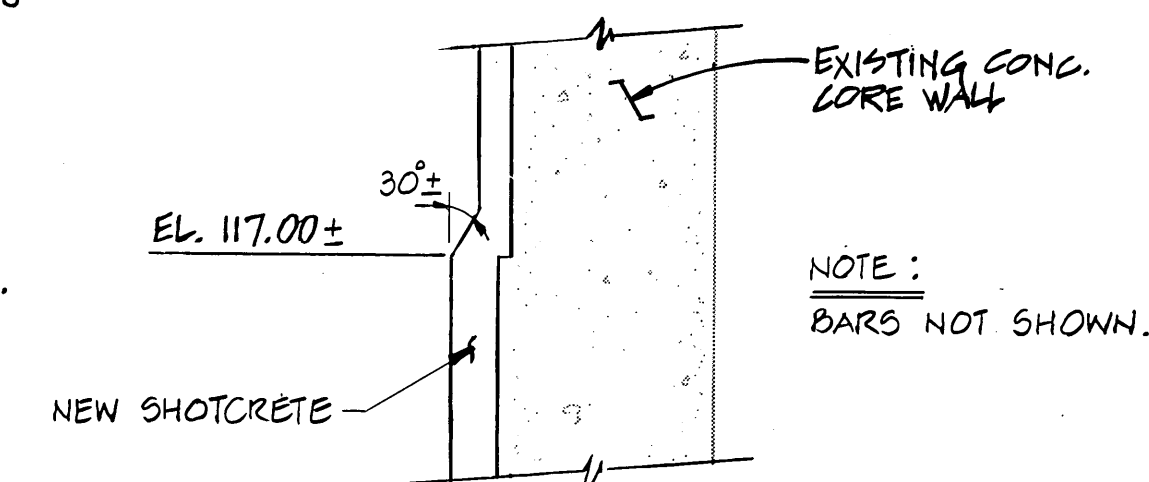


(X) DETAIL
NO SCALE


EAST BAY MUNICIPAL UTILITY DISTRICT
SPECIAL DISTRICT No. 1
OAKLAND, CALIFORNIA

TYPICAL WALL SECTIONS AND DETAILS


DRAWN BY: SCALE: DATE: DRAWING No. **S-2** SHEET 5 OF 8

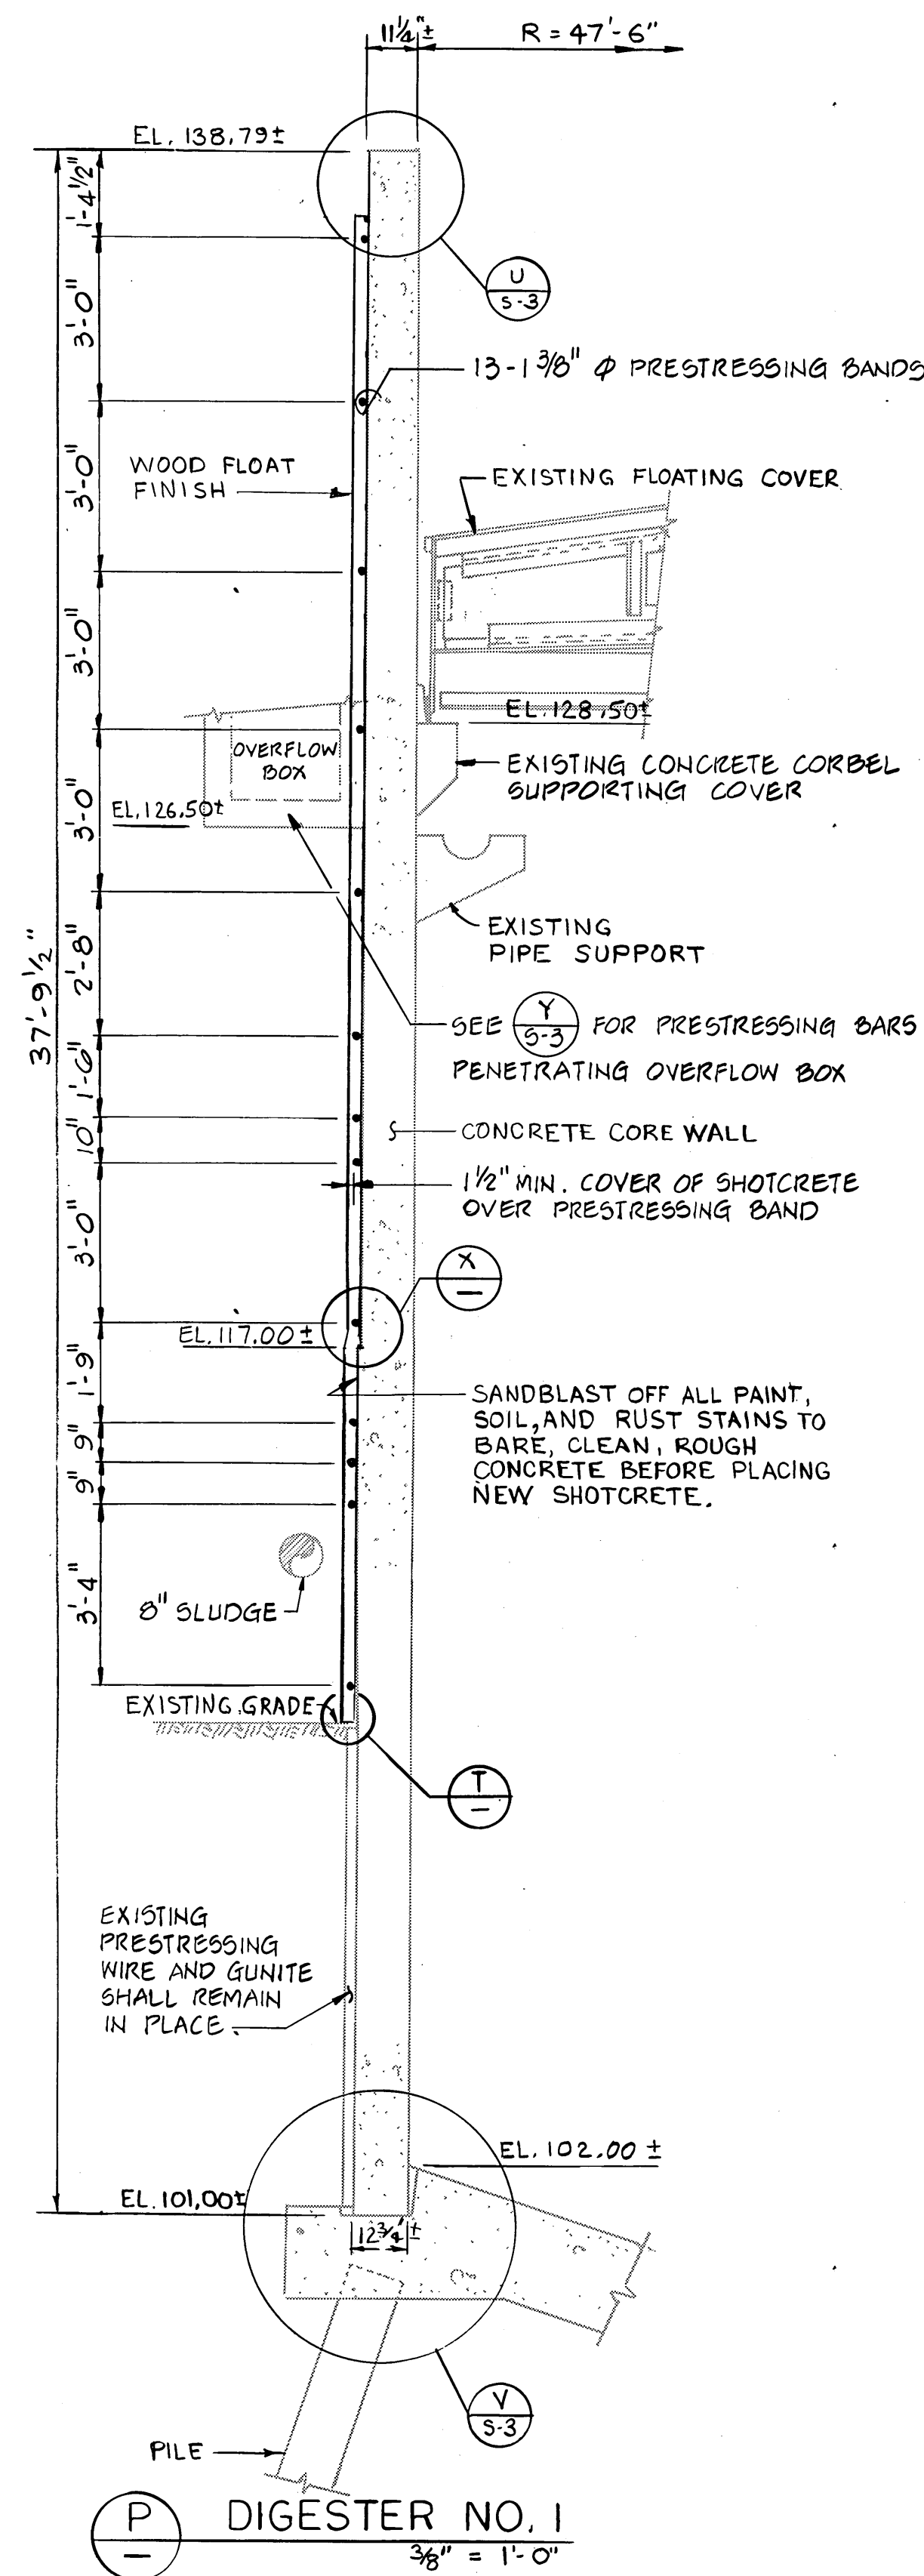


(P) DIGESTER NO. 1
3/8" = 1'-0"

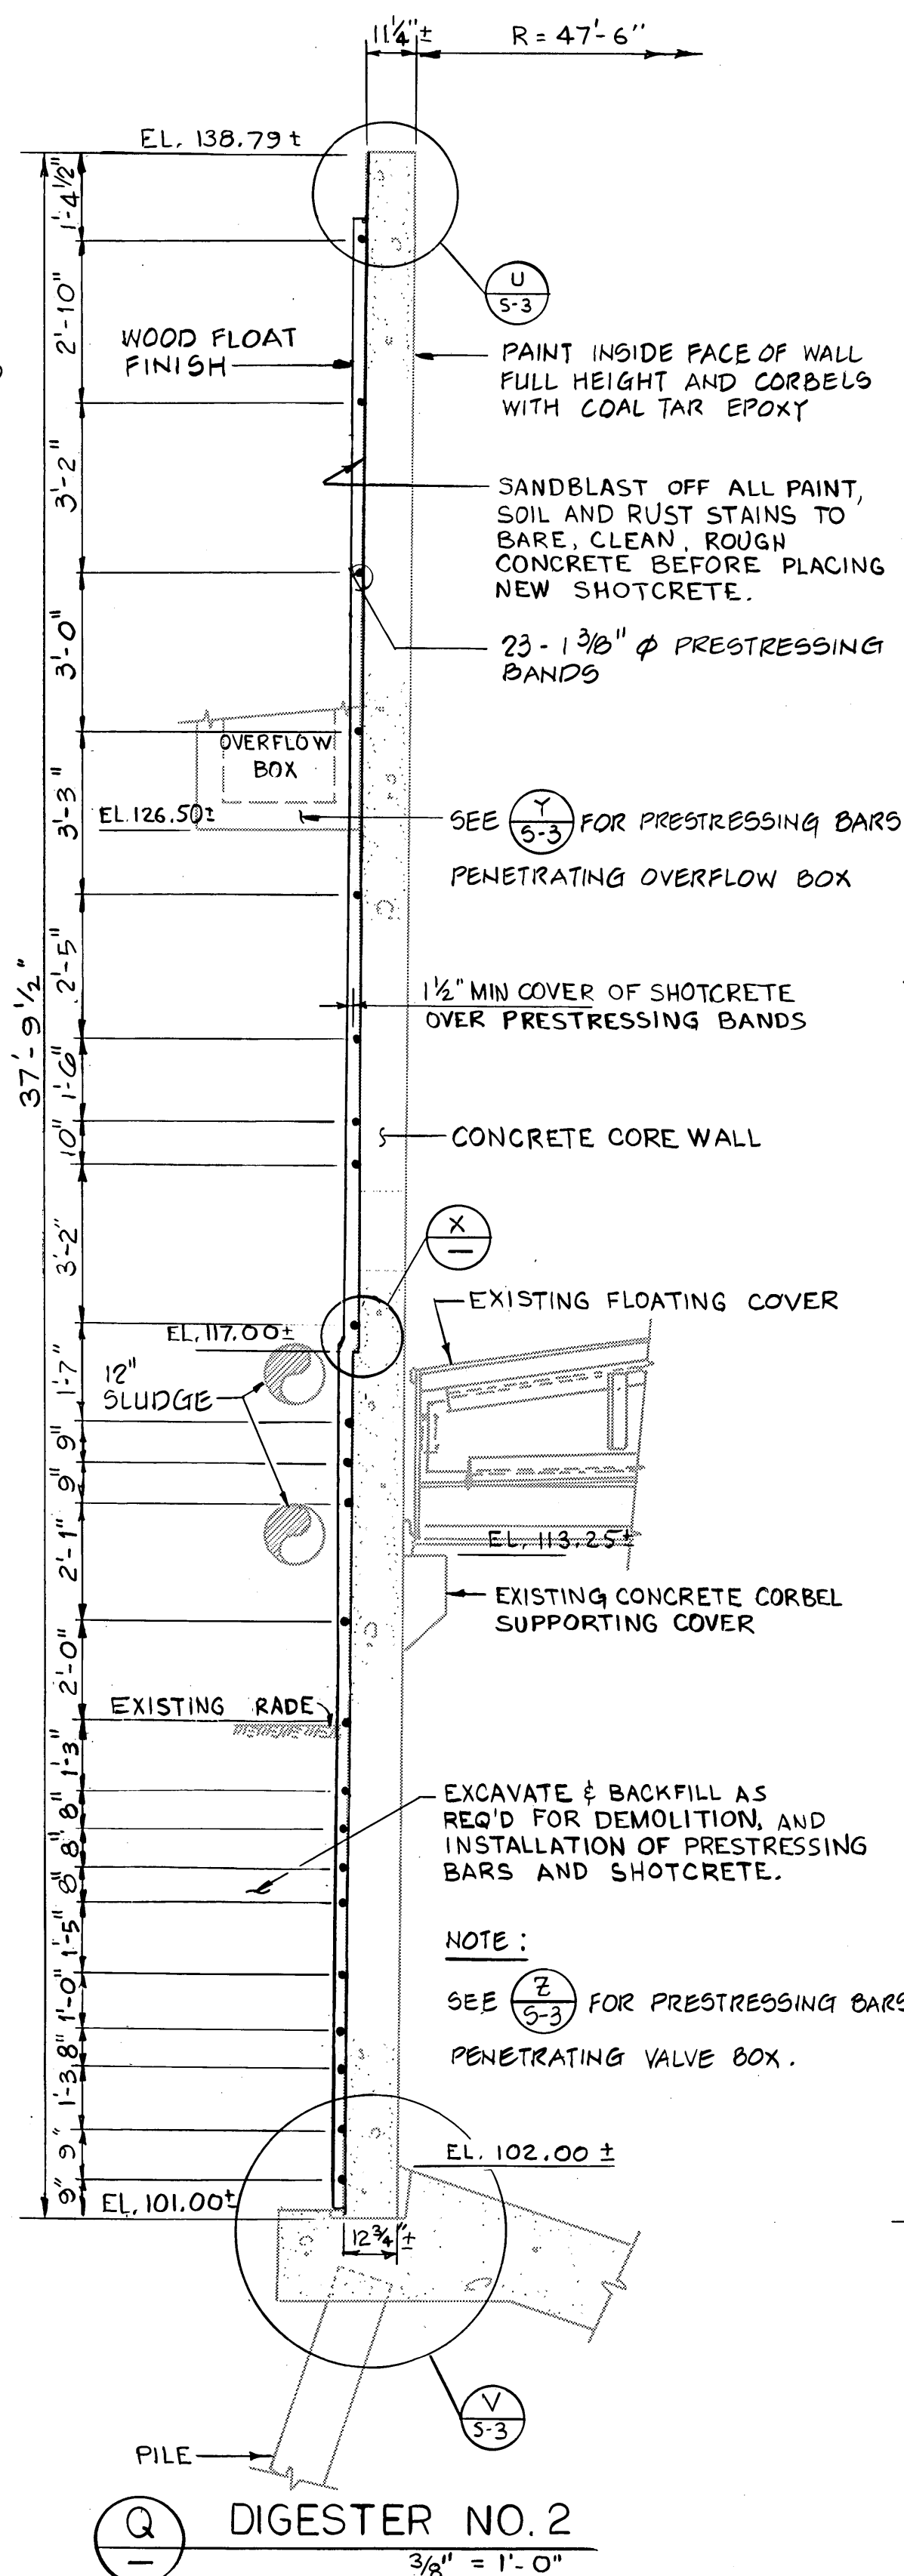

(Q) DIGESTER NO. 2
3/8" = 1'-0"

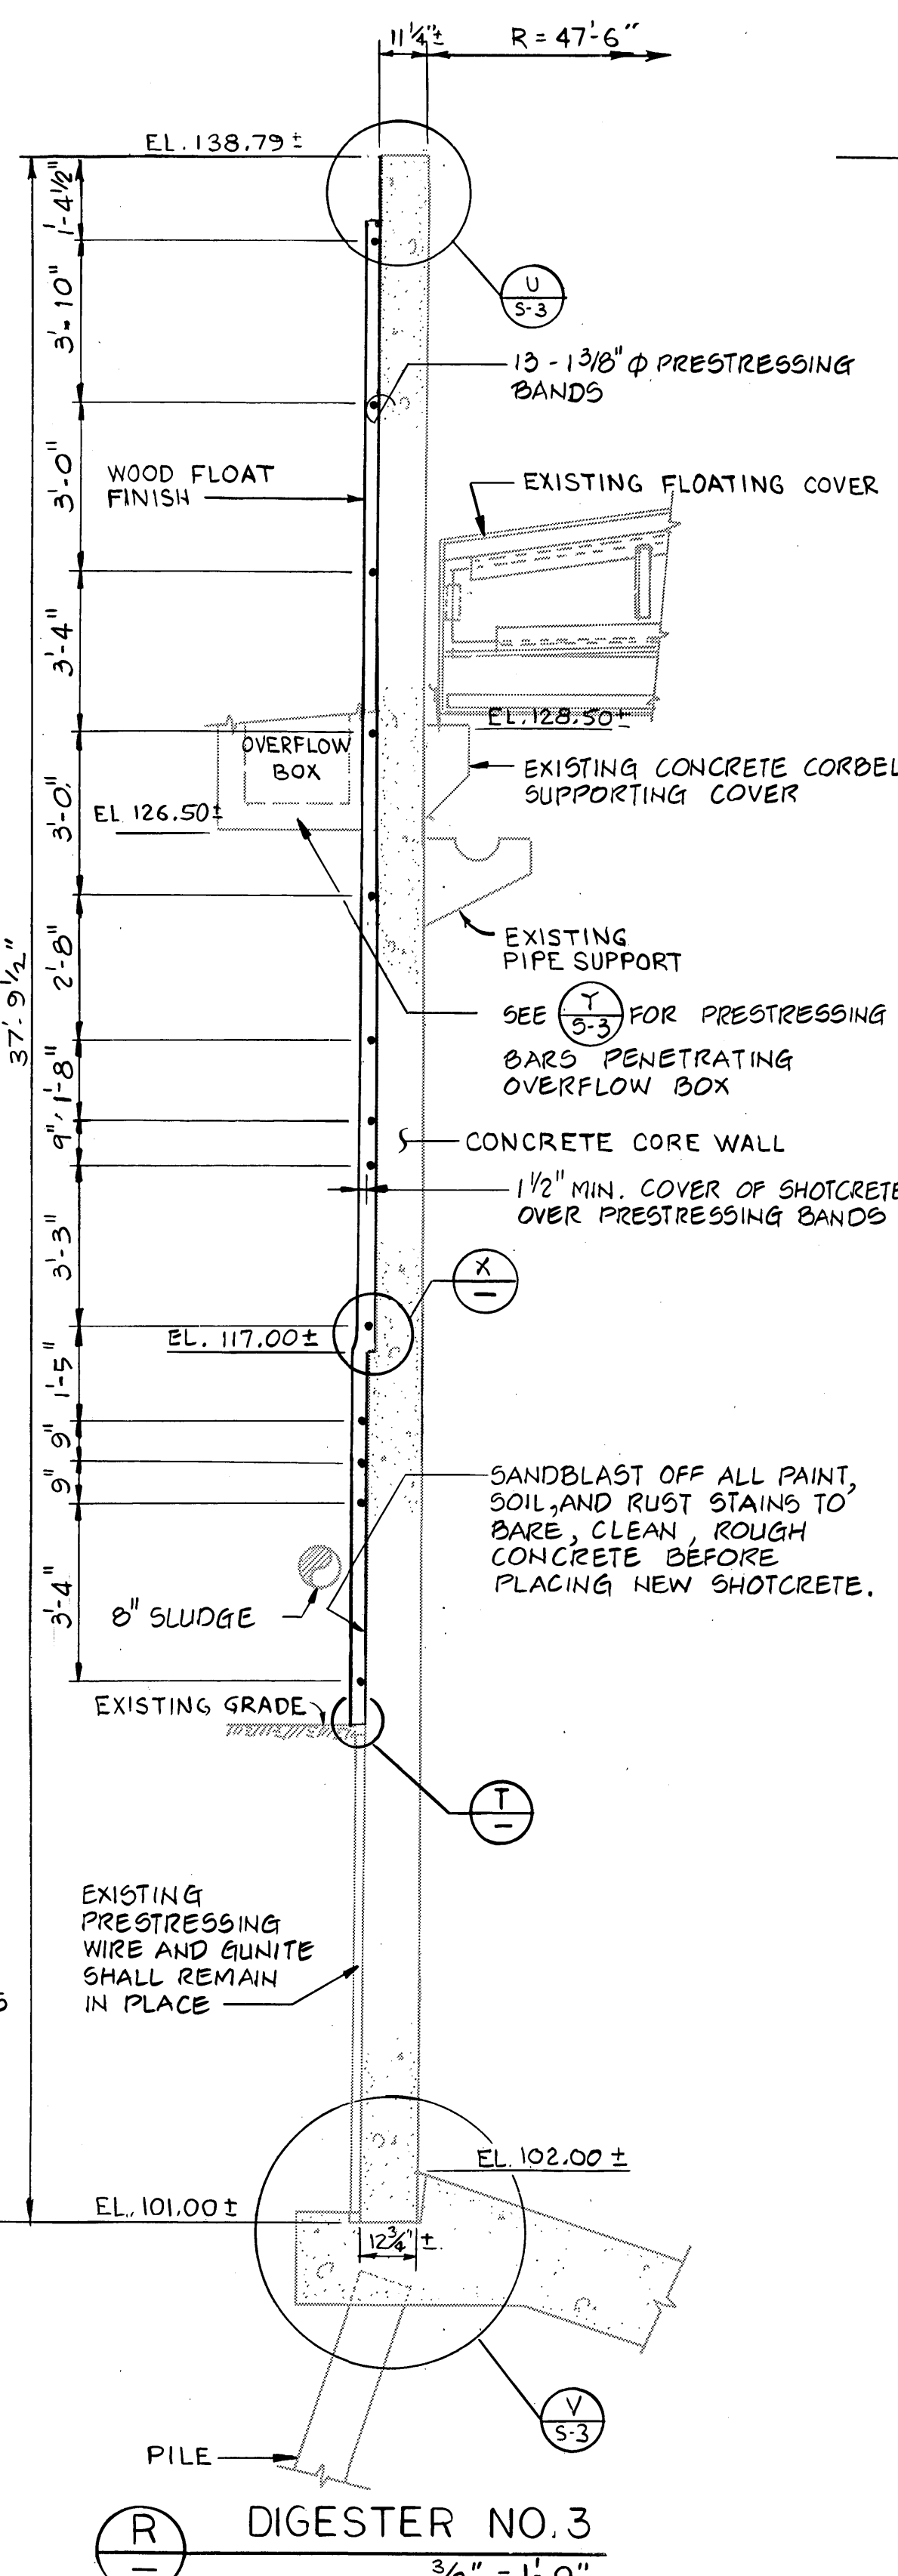

(R) DIGESTER NO. 3
3/8" = 1'-0"

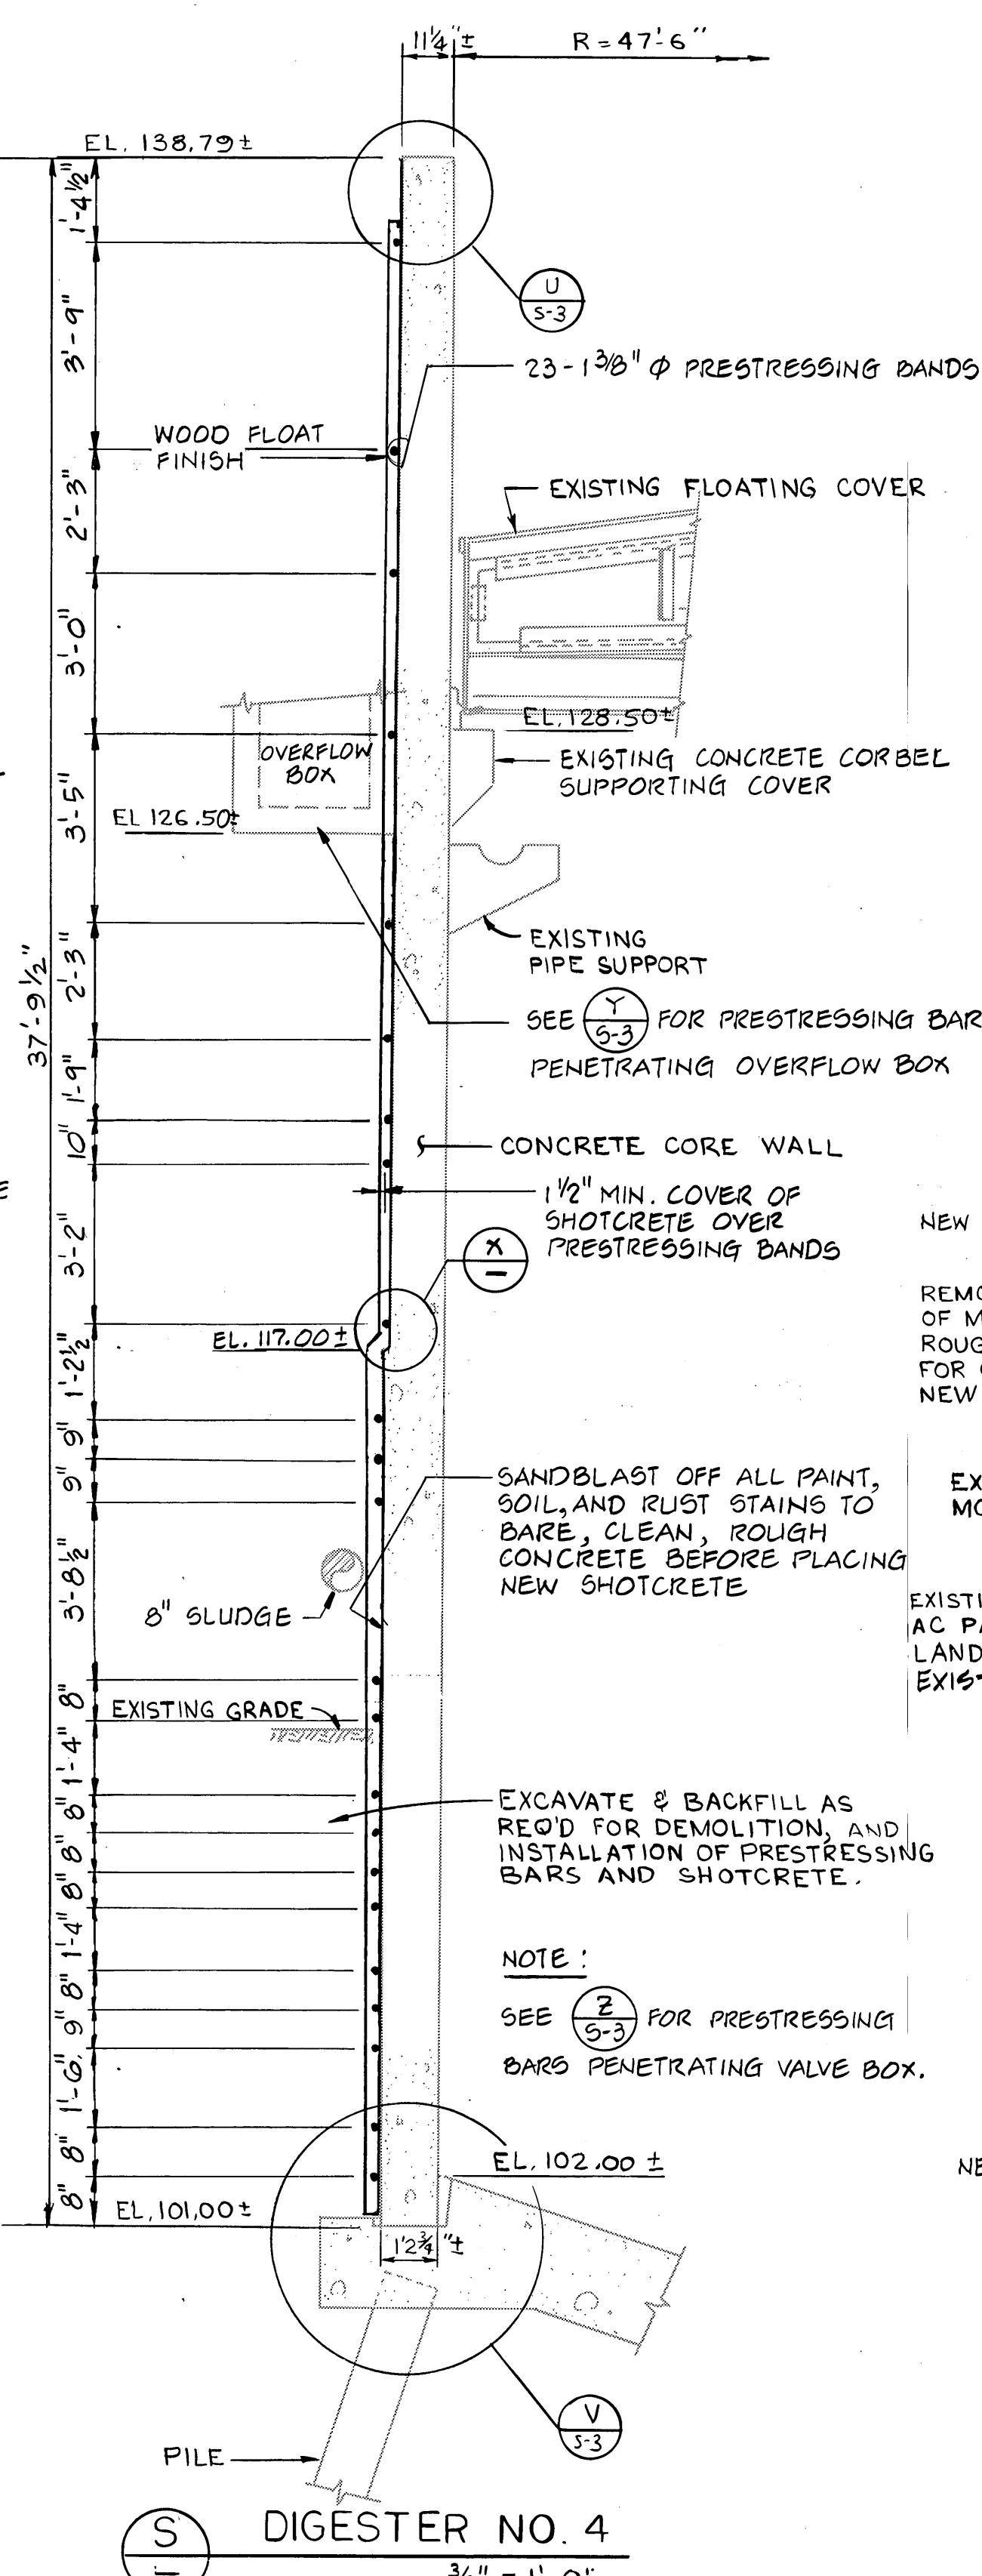

(S) DIGESTER NO. 4
3/8" = 1'-0"


JOHN CAROLLO ENGINEERS
PHOENIX, AZ • WALNUT CREEK, CA
FOUNTAIN VALLEY, CA • VISALIA, CA
SAN BERNARDINO, CA • TUCSON, AZ
SAN DIEGO, CA • BAKERSFIELD, CA

NO.	DATE	REVISION	BY	REC.	APP.
1	31 MAR 93	AS BUILT	W. J. J. J.	RW	775

SPECIFICATION SD-180
REPAIR OF
DIGESTERS 1, 2, 3 & 4

DESIGNED BY: CAG
DESIGN CHECKED BY: DMM
DRAWN BY: ELP
SR. PROJ. ENGR.:
APPROVED: GCD
PRINCIPAL-IN-CHARGE, R.P.E. NO. C

PROJECT ENG. R.P.E. NO. C
PROJECT MGR. R.P.E. NO. C
MGR. OF SUPPORT SERVICES R.P.E. NO. C29111
MANAGER OF WASTEWATER R.P.E. NO. C26855
DATE: 10/1/93

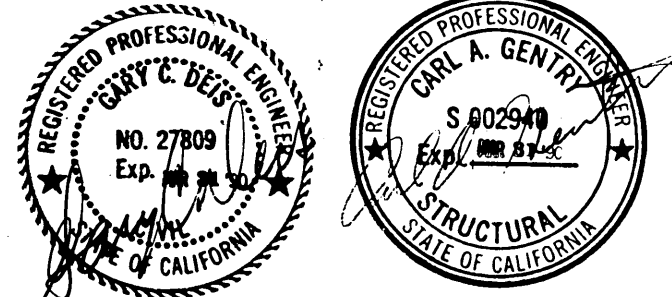

JOB NO. 3134A.10

GENERAL:

- THE CONTRACTOR SHALL VERIFY ALL DIMENSIONS BEFORE STARTING WORK AND SHALL IMMEDIATELY NOTIFY THE ENGINEER OF ANY DISCREPANCIES.
- UNLESS DETAILED, SPECIFIED, OR INDICATED OTHERWISE, CONSTRUCTION SHALL BE AS INDICATED IN THE APPLICABLE TYPICAL DETAILS AND GENERAL NOTES. TYPICAL DETAILS ARE MEANT TO APPLY EVEN THOUGH NOT REFERENCED AT SPECIFIC LOCATIONS ON DRAWINGS.
- WHERE NO CONSTRUCTION DETAILS ARE SHOWN OR NOTED FOR ANY PART OF WORK, DETAILS SHALL BE THE SAME AS FOR OTHER SIMILAR WORK.

REINFORCED CONCRETE:

- ALL CONCRETE CONSTRUCTION, INCLUDING BENDING OF BARS, SHALL COMPLY WITH ACI "BUILDING CODE REQUIREMENTS FOR REINFORCED CONCRETE" (ACI 318).
- UNLESS CALLED OUT OTHERWISE ON THE PLANS, MINIMUM REINFORCEMENT OF CONCRETE WALLS OR SLABS SHALL BE:

8" THICK OR LESS	USE #5 @ 12" EW
9" OR THICKER	USE #5 @ 12" EWEF
- ALL WALL REINFORCEMENT AT CORNERS OR JUNCTIONS OF WALLS SHALL BE CONTINUOUS, LAPPED, OR TERMINATED IN A STANDARD 90 DEGREE HOOK. LAP SPLICES SHALL CONFORM WITH NOTE 5.
- UNLESS SHOWN OTHERWISE ALL BARS SHALL BE DOWELED. DOWELS SHALL BE THE SAME SIZE AND SPACING AS THE REINFORCEMENT WHICH IS TO BE SPLICED TO THE DOWELS.
- UNLESS CALLED OUT OTHERWISE ON THE PLANS, THE LENGTH OF LAP SPLICES SHALL BE CLASS "B" WHERE NO MORE THAN 1/2 THE BARS ARE LAP SPLICED WITHIN THE LENGTH TABULATED BELOW AND CLASS "C" WHERE MORE THAN 1/2 THE BARS ARE LAP SPLICED WITHIN THE LENGTH TABULATED BELOW. ALL SPLICE LENGTHS SHALL BE IN ACCORDANCE WITH APPLICABLE TABULATED VALUES. LENGTHS ARE SHOWN IN INCHES. FOR BARS SPACED 6 INCHES ON CENTER OR FARTHER APART WITH AT LEAST 3-INCHES CLEAR FROM FACE OF MEMBER TO EDGE OF BAR, MEASURED IN DIRECTION OF SPACING, THE SPLICE LENGTH MAY BE REDUCED BY 20 PERCENT.

THE SPLICE LENGTH TABLE IS BASED ON $F_y = 60,000$ PSI.

TOP BARS*	(CLASS "B")	#4	#5	#6	#7	#8	#9	#10	#11
	(CLASS "C")	22	27	33	44	58	74	94	115
OTHER BARS	(CLASS "B")	16	20	23	32	42	53	67	82
	(CLASS "C")	20	26	31	41	54	69	88	108


*TOP BARS ARE ALL HORIZONTAL REINFORCEMENT SO PLACED THAT MORE THAN 12 INCHES OF FRESH CONCRETE IS CAST IN THE MEMBER BELOW THE BAR.

- ALL SLABS, BEAMS AND COLUMN REINFORCING BARS SHALL HAVE A MINIMUM EXTENSION OR ANCHORAGE INTO SUPPORTS IN ACCORDANCE WITH ACI 318.
- STIRRUP SUPPORT BARS SHALL BE PROVIDED BETWEEN ENDS OF TOP BARS AS REQUIRED.
- UNLESS INDICATED OTHERWISE, CONCRETE COVER OVER REINFORCEMENT SHALL BE AS FOLLOWS:

A. SURFACES NOT EXPOSED DIRECTLY TO THE GROUND, WATER, OR WEATHER AFTER FORM REMOVAL:	
CONCRETE SLABS IN BUILDINGS	3/4"
CONCRETE SLABS OVER WATER BEARING STRUCTURES	1"
CONCRETE BEAMS, GIRDERS, COLUMNS AND WALLS	1-1/2"
B. SURFACES EXPOSED DIRECTLY TO THE GROUND, WATER OR WEATHER AFTER FORM REMOVAL:	
FOR #5 BARS OR SMALLER	1-1/2"
FOR #6 BARS OR LARGER	2"
C. CONCRETE PLACED DIRECTLY AGAINST GROUND	3"
D. REINFORCEMENT SHALL BE PLACED WITHIN A TOLERANCE OF $\pm 1/4$ " OF POSITION SPECIFIED.	
- KEYWAYS AND WATER STOP SHALL END 3" BELOW THE TOP OF WALLS, UNLESS THERE IS A SLAB ON TOP OF THE WALL, IN WHICH CASE IT SHALL END AT BOTTOM OF THE SLAB. IN JOINTS WHERE WATERSTOP TERMINATES AT ADJOINING SLAB OR WALL, WATER STOP SHALL BE EMBEDDED IN ADJOINING SLAB OR WALL A MINIMUM OF 6".
- CONCRETE CURING SHALL BE IN ACCORDANCE WITH THE CONTRACT DOCUMENTS. SOME CONCRETE WORK REQUIRES WATER CURING, AS MEMBRANE CURING IS NOT ALLOWED. THE CONTRACTOR IS WARNED THAT WATER CURING IS DIFFICULT AT TIMES DUE TO WIND AND DRY CONDITIONS. THE CONTRACTOR SHALL STUDY REQUIREMENTS AND SHALL FURNISH ADEQUATE SYSTEMS TO PROVIDE WATER CURING WHERE REQUIRED. TOP OF WALLS SHALL BE KEPT VISIBLY MOIST AT ALL TIMES AND SHALL BE FLOODED NOT LESS THAN THREE TIMES DAILY.
- WATERSTOP SHALL BE PLACED IN ALL CONSTRUCTION, CONTRACTION, AND EXPANSION JOINTS IN ALL WATERBEARING SLABS AND WALLS UNLESS CALLED OUT OTHERWISE ON THE PLANS, AND ALL WALLS AND SLABS SUBJECTED TO GROUNDWATER. WATERSTOP IN THE WALLS SHALL BE CARRIED INTO SLABS AND SHALL BE SPLICED WITH THE WATER STOP IN THE SLABS.
- NO BACKFILL SHALL BE PLACED AGAINST WALLS UNTIL CONCRETE HAS REACHED 85 PERCENT OF THE SPECIFIED STRENGTH AND THE CONNECTING SLABS AND BEAMS HAVE BEEN CAST AND HAVE REACHED 85 PERCENT OF THE SPECIFIED STRENGTH.

STRUCTURAL NOTES

TYP S 387

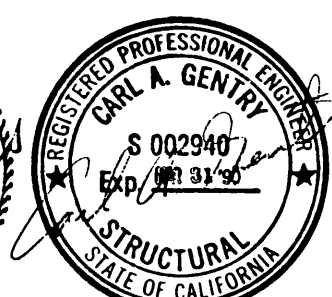

JOB NO.
3134A.10

JOHN CAROLLO ENGINEERS

PHOENIX, AZ • WALNUT CREEK, CA
FOUNTAIN VALLEY, CA • VISALIA, CA
SAN BERNARDINO, CA • TUCSON, AZ
SAN DIEGO, CA • BAKERSFIELD, CA

JOINT DETAIL

S-2

NOT TO SCALE

ON DIGESTERS 2&4
REMOVE ALL SHOTCRETE
OVERSPRAY AND
TRIM TO LINES SHOWN.

AFTER DEMOLITION OF WIRE &
GUNITE ON DIGESTERS 2&4
FILL JOINT WITH SYNTHETIC
SPONGE RUBBER EXPANSION
JOINT MATERIAL AND
BOND TO CONC. FILL JOINTS
WITH CAULKING.


NEW SHOTCRETE ON DIGESTERS 2&4
EXIST. WIRES & GUNITE ON DIGESTERS 1&3.

ON DIGESTERS 1,2,3&4 REMOVE
MORTAR & CUT CONC. WHERE REQ'D. TO
PROVIDE A 1" MIN. WIDE
JOINT FOR HEIGHT OF GROOVE PRIOR
TO TENSIONING NEW PRESTRESSING BARS.
THE JOINT SHALL BE CUT OUT SO THAT
THE WALL WILL BE FREE TO MOVE INWARD
WHEN THE PRESTRESSING BARS ARE
TENSIONED. THE EXIST. JOINT WIDTH
MAY VARY AND MAY BE WIDER
OR NARROWER THAN 1"

ON DIGESTERS 1, 2, 3 & 4
SANDBLAST AND THOROUGHLY CLEAN
JOINT IMMEDIATELY BEFORE APPLYING
SYNTHETIC RUBBER SEALING COMPOUND.


ON DIGESTERS 1, 2, 3 & 4.
BOND BREAKER TAPE

ON DIGESTERS 1,2,3&4
NO EARLIER THAN 1 WEEK AFTER ALL PRESTRESSING BANDS
HAVE BEEN STRESSED FILL JOINTS AS SHOWN WITH 1 PART
CEMENT TO 2 PARTS SAND MORTAR. THE MORTAR SHALL BE
OF TROWELABLE CONSISTENCY. FINISH TOP SURFACE TO A
SMOOTH FINISH FOR APPLICATION OF BOND BREAKER TAPE.

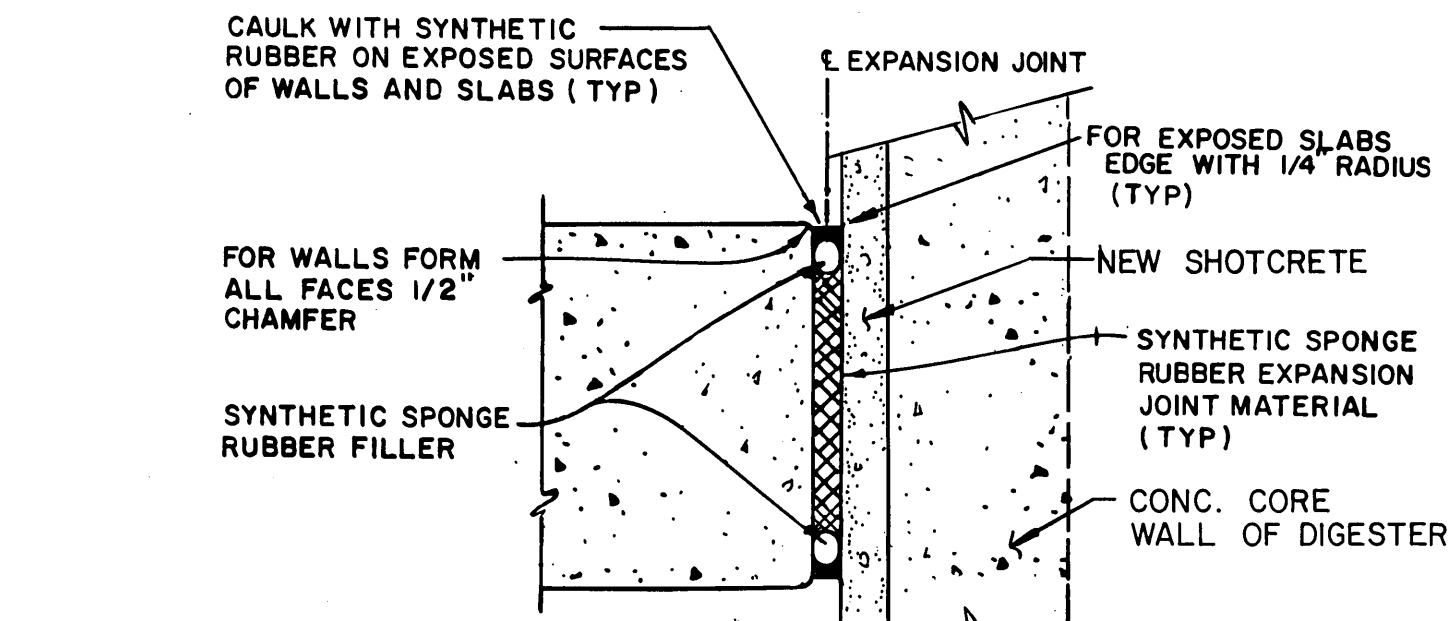

EXPANSION JOINT

NOT TO SCALE

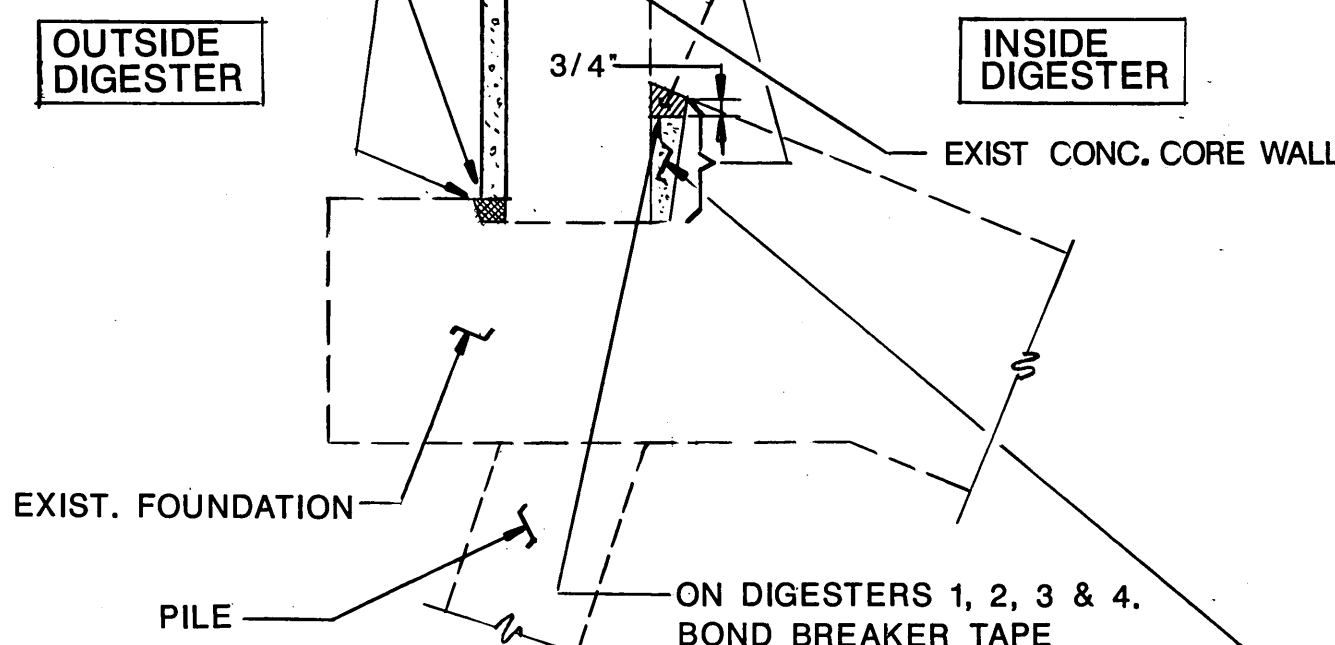


S-2

NOT TO SCALE

REMOVE SECTION OF CONCRETE
FULL WIDTH OF OVERFLOW BOX.
REMOVE ALL PRESTRESSING
WIRE IN AREA WHERE CONCRETE
IS REMOVED. COAT WITH EPOXY
BONDING AGENT AND REPAIR
WITH NON-SHRINK GROUT.
(TYP AT EACH PRESTRESSING
BAR)

OVERFLOW BOX
REMOVED, SEE
NOTE 1

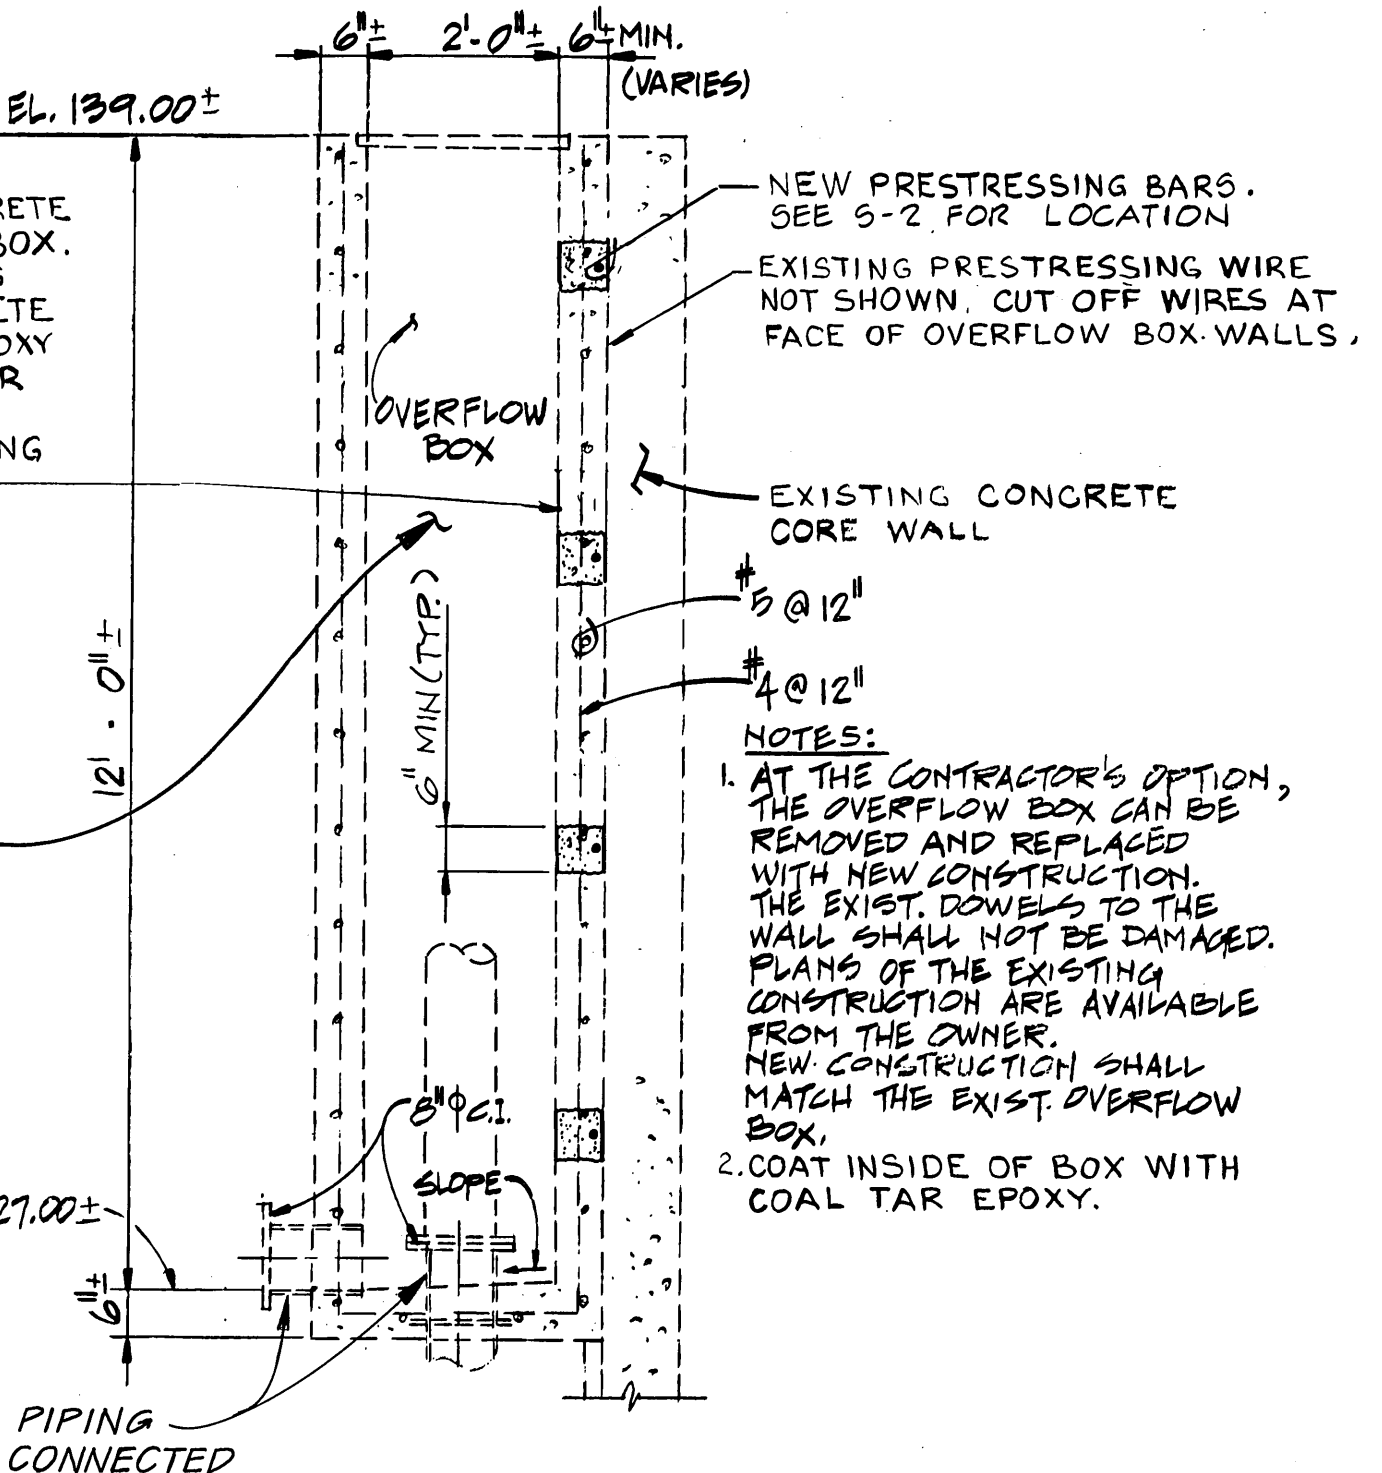


OVERFLOW BOX DETAIL

S-2

1/2" = 1' - 0"


REMOVE CONCRETE AT WALLS & SLAB
AS REQUIRED FOR PLACEMENT OF
PRESTRESSING BARS. COAT CONCRETE
WITH EPOXY BONDING AGENT AND
REPAIR WITH CONCRETE. DO NOT DAMAGE
EXISTING REINFORCING BARS.

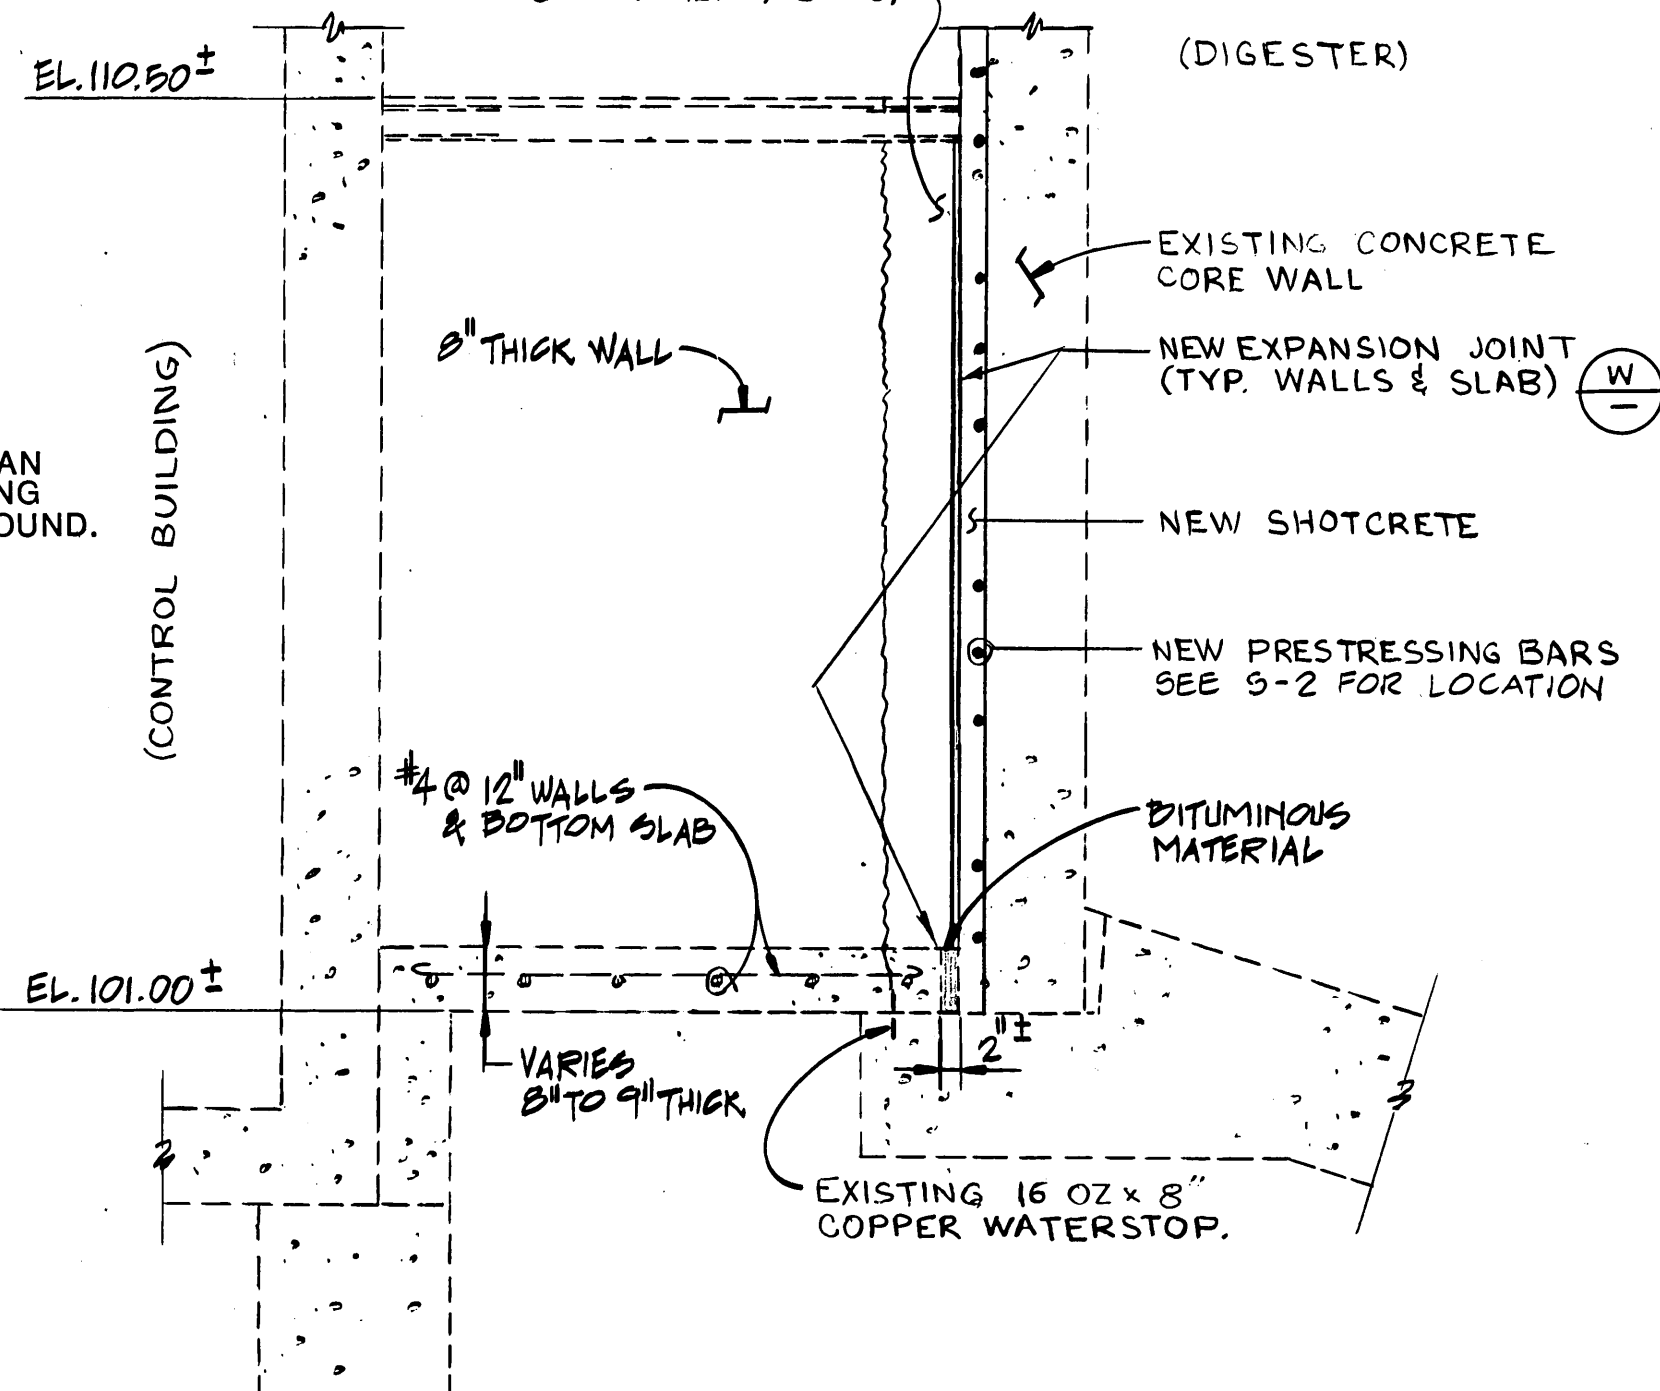

VALVE PIT DETAIL

S-2


1/2" = 1' - 0"

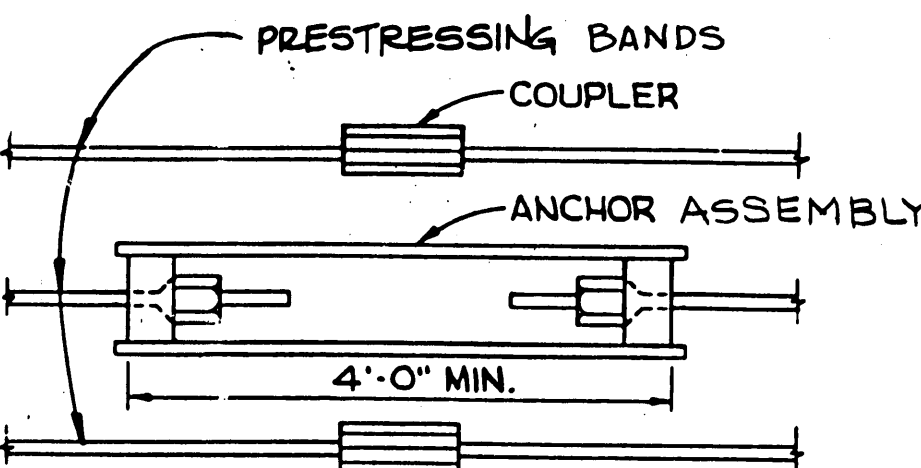

ELEVATION


NOT TO SCALE

NOTE: 8 SHOTCRETE PILASTERS SHALL
BE EQUALLY SPACED AROUND DIGESTER
TO COVER COUPLERS AND ANCHOR
ASSEMBLIES.

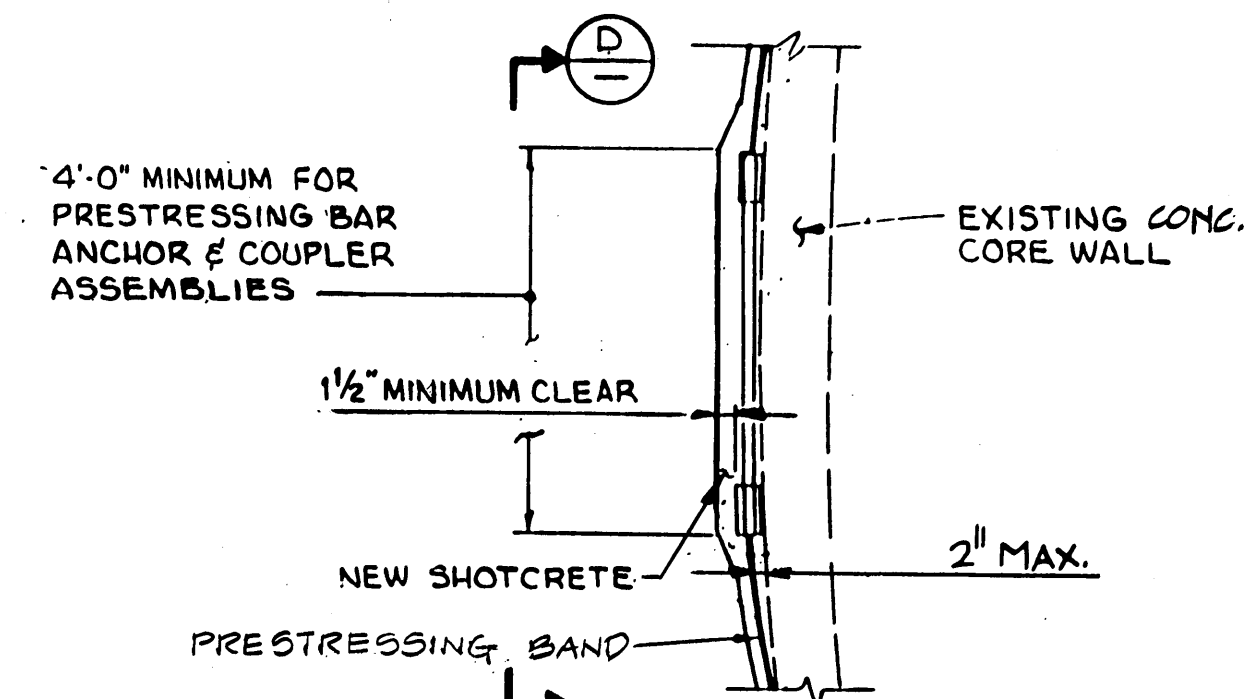

PARTIAL PLAN - PILASTER

NOT TO SCALE

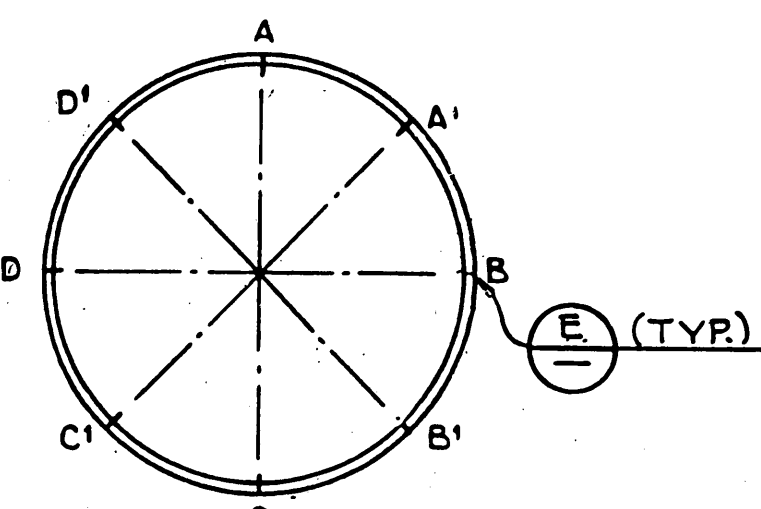

NOTE: PRESTRESSING BANDS SHALL BE STRESSED
STARTING WITH THE BOTTOM AND FINISHING
WITH TOP BAND ON THE DIGESTER WALL.
THE FIRST BAND TO BE STRESSED SHALL HAVE
ANCHORS AT POINTS A, B, C & D AND HAVE
COUPLERS AT POINTS A', B', C' & D'.
THE SECOND BAND SHALL HAVE ANCHORS AT
POINTS A', B', C' & D' AND HAVE COUPLERS
AT POINTS A, B, C & D.
THE REMAINING BANDS SHALL HAVE THEIR
ANCHORS AND COUPLERS ALTERNATE
SIMILAR TO THE FIRST TWO BANDS.

PRESTRESSING BAND STRESSING DIAGRAM

EAST BAY MUNICIPAL UTILITY DISTRICT
SPECIAL DISTRICT No. 1
OAKLAND, CALIFORNIA

STRUCTURAL DETAILS

DRAWN BY: SCALE: DATE: DRAWING No. S-3 SHEET 6 OF 8

SPECIFICATION SD-180

REPAIR OF
DIGESTERS 1, 2, 3 & 4

DESIGNED BY: CAG
DESIGN CHECKED BY: DMM
DRAWN BY: ELP/RMK
SR. PROJ. ENGR.:
APPROVED: GCD
PRINCIPAL-IN-CHARGE, R.P.E. NO. C

PROJECT ENG. R.P.E. No. C
PROJECT MGR. R.P.E. No. C
MGR. OF SUPPORT SERVICES R.P.E. No. C29111
MANAGER OF WASTEWATER R.P.E. No. 26855
DATE: 10/1/95

IN SERVICE 31 MAR 93 AS BUILT DATE 10/1/95 BY REC. APP.