

EXHIBIT F

REFERENCE MATERIAL

The documents provided may contain errors, omissions, or may be out of date.

1. Maintenance Building
 - a. 1998 Maintenance Building Original SD223A Select Drawings
 - b. 2018 Maintenance Building Evaluation and Conceptual Design TM Excerpts
 - c. 2021 Maintenance Building Photos
2. Maintenance Canopy
 - a. 1984 Maintenance Canopy Original SD156 Select Drawings
 - b. 1998 Maintenance Canopy Retrofit SD223A Drawing
 - c. 2008 Maintenance Canopy Structural Review Excerpts
 - d. 2021 Maintenance Canopy Photos
3. Fueling Station
 - a. 2003 Fueling Station equipment SD279
4. Evaluation Criteria
 - a. 2021 Evaluation Criteria and Seismic Hazard Information

Maintenance Building

EAST BAY MUNICIPAL UTILITY DISTRICT SPECIAL DISTRICT NO.1 OAKLAND, CALIFORNIA

WASTE WATER TREATMENT PLANT SPECIFICATION SD 223-A MAINTENANCE FACILITY UPGRADE AND SEISMIC IMPROVEMENTS 2020 Wake Avenue, Oakland, California

February 13, 1998

Architect

THE RATCLIFF ARCHITECTS
5856 Doyle Street
Emeryville, CA 94608
(510) 652-1972

Structural Engineer

DASSE DESIGN, INC.
33 New Montgomery, Suite 850
San Francisco, CA 94105
(415) 243-9165

Mechanical Engineer

GAYNER ENGINEERS
1133 Post Street
San Francisco, CA 94109
(415) 474-9500

Electrical Engineer

MTH Engineers
3350 Scott Boulevard, Building 11
Santa Clara, CA 95054
(408) 986-8585

Civil Engineer

SANDIS HUMBER JONES
605 Castro Street
Mountain View, CA 94041
(415) 969-6900

DRAWING INDEX

ELECTRICAL DRAWINGS
E1.0 Legends, Abbreviations, General Notes and Drawing Index
E2.1 Electrical Site Plan - Power and Signal
E2.2 Enlarged Electrical Plans
E2.3 Electrical Site Plan - Lighting
E3.1 Ground Floor Plan - Lighting
E3.2 Mezzanine Plan - Lighting
E4.1 Ground Floor Plan - Power
E4.2 Mezzanine Plan - Power
E5.1 Ground Floor Plan - Signal and Communication
E5.2 Mezzanine Plan - Signal and Communication
E6.1 Single Line Diagram and Feeder Schedule
E6.2 Misc. Wiring Diagrams
E7.1 Lighting Fixture Schedule and Control Diagrams
E7.2 Panel Schedule
E7.3 Panel Schedule
E8.1 Electrical Details
E8.2 Electrical Details
E8.3 Electrical Details
E9.0 Title 24- Lighting Compliance

DRAWING INDEX

T-1 Cover Sheet
T-2 Administration, General Notes
T0.1 Title 24 CEC Compliance
CIVIL DRAWINGS
C-1 Topographic Survey
C-2 Demolition Plan
C-3 Site/ Horizontal Control Plan
C-4 Grading and Drainage Plan
C-5 Water, Storm Drain and Sanitary Sewer Plan
C-6 Details
ARCHITECTURAL DRAWINGS
A1.1 Site Plan
A1.2 Enlarged Shed Plan
A1.3 Roof Plan and Elevations at Shed
A1.4 Wall Section, Details & Schedule-Shed
A1.5 Site Details
A2.1 Ground Floor Plan
A2.2 Mezzanine Plan
A2.3 Roof Plan
A2.4 Schedules
A2.5 Schedules (Wall, Window)
A2.6 Existing Building Plan
A3.1 Building Sections
A3.2 Exterior Elevations
A3.3 Wall Sections
A3.4 Wall Sections
A3.5 Wall Sections
A3.6 Detailed Elevations
A4.1 Detailed Plans
A5.1 Interior Elevations
A5.2 Interior Elevations
A5.3 Interior Elevations
A6.1 Reflected Ceiling Plan - Ground Plan
A6.2 Reflected Ceiling Plan - Mezzanine Plan and High Bay
A6.3 Reflected Ceiling Plan - Existing Building
A7.1 Stair Plans, Sections and Details
A8.1 Exterior Details
A8.2 Exterior Details
A8.3 Exterior Details
A9.1 Interior Details
A9.2 Interior Details
A9.3 Interior Details
A10.1 Ground Floor Finish Plan
A10.2 Mezzanine Finish Plan
A11.0 Existing Building - Building Plan
A11.1 Existing Building Move Location Plan
A11.2 Ground Floor Move Plan
A11.3 Mezzanine Ground Move Plan
STRUCTURAL DRAWINGS
S1.1 General Notes, Abbreviations Symbols, Drawing Index
S2.1 Foundation Plan
S2.2 Mezzanine Floor Framing Plan
S2.3 Roof Framing Plan
S2.4 Roof Framing Plan Existing Maintenance Building
S3.1 Panel Elevations
S3.2 Panel Elevations
S3.3 Panel Elevations
S3.4 Panel Elevations
S5.1 Typical Concrete Details
S5.2 Footing Details
S5.3 Typical Concrete Details
S5.4 Wall Details
S5.5 Masonry Details
S7.1 Typical Steel Details
S7.2 Typical Steel Details
S7.3 Braced Frame Details
S7.4 Typical Steel Details
S7.5 Typical Steel Details
MECHANICAL DRAWINGS
M0.1 Legends, Symbols and General Notes
M0.2 Schedules
M0.3 Schedules
M1.1 Site Plan
M2.1A Partial Ground Floor Plan
M2.1B Partial Ground Floor Plan
M2.1C Partial Ground Floor Plan
M2.1D Partial Ground Floor Plan
M2.2 Roof Plan
M3.1 Partial Mezzanine Floor Plans
M4.1 Enlarged Plan and Sections
M4.2 Sections
M4.3 Sections
M5.1 Diagrams
M6.1 Details
M6.2 Details
M6.3 Details
M6.4 Details
M6.5 Details
M7.1 Control Diagrams
M7.2 Control Diagrams
M7.3 Control Diagrams
PLUMBING DRAWINGS
P0.1 Legend, Abbreviations and Schedules
P1.1 Site Plan - Plumbing
P1.2 Gas Site Plan and Details
P2.1A Ground Floor Plan Underslab Plumbing
P2.1B Ground Floor Plan Above Slab Plumbing
P2.2 Mezzanine Plan-Toilet Rm. Plans
P3.1 Plumbing Diagrams
P6.1 Plumbing Details
IF SHEET IS LESS THAN 30" X 42"
IT IS A REDUCED PRINT
SCALE REDUCED ACCORDINGLY

CODE SUMMARY

BUILDING CODES: 1994 UBC and 1995 Calif. Building Code
UPC, UMC, NEC, UFC
CONSTRUCTION TYPE: TYPE V-N (MIN. REQ'D. BY AREA BLDG TO BE NON-COMBUSTIBLE CONSTR PER EBMUD REQ.)
SEPARATION ON (4) SIDES
OCCUPANCY GROUPS: B: OFFICE
S1: MODERATE-HAZARD STORAGE
F2: LOW-HAZARD INDUSTRIAL
A3: ASSEMBLY
H4: WELDING SHOP
BUILDING AREA:
Office Area: 4,397 S.F.
Storage Area: 5,009 S.F.
Industrial Area: 11,318 S.F.
Assembly Area: 1,672 S.F.
Hazardous Area: 361 S.F.
NOTE: Building Areas are approximate. See Drawings for actual areas.

EAST BAY MUNICIPAL UTILITY DISTRICT
SPECIAL DISTRICT No. 1
OAKLAND, CALIFORNIA


MAINTENANCE FACILITY SD 223-A
WASTE WATER TREATMENT PLANT
TRA PROJECT NO. 96007.02

COVER SHEET

PROJECT NO. 96007.02
PROJECT SUPERVISOR
R.P.E. No.
DATE 13 FEB. 1998
DRAWING No. T-1
SHEET OF

SPECIFICATION NO.

The Ratcliff Architects 5856 DOYLE STREET EMERYVILLE, CA 94608 (510) 652-1972	DESIGNED BY	J.L.W.
	DRAWN BY	J.L.W.
18DEC2812 3 7/98/98 1 3/31/98	IN SERVICE RECORD DRAWING	SD223A
	PLAN CHECK COMMENTS	PLAN CHECK AND ADDENDUM NO. 1
NO.	DATE	REVISION
	BY	REV. APP.

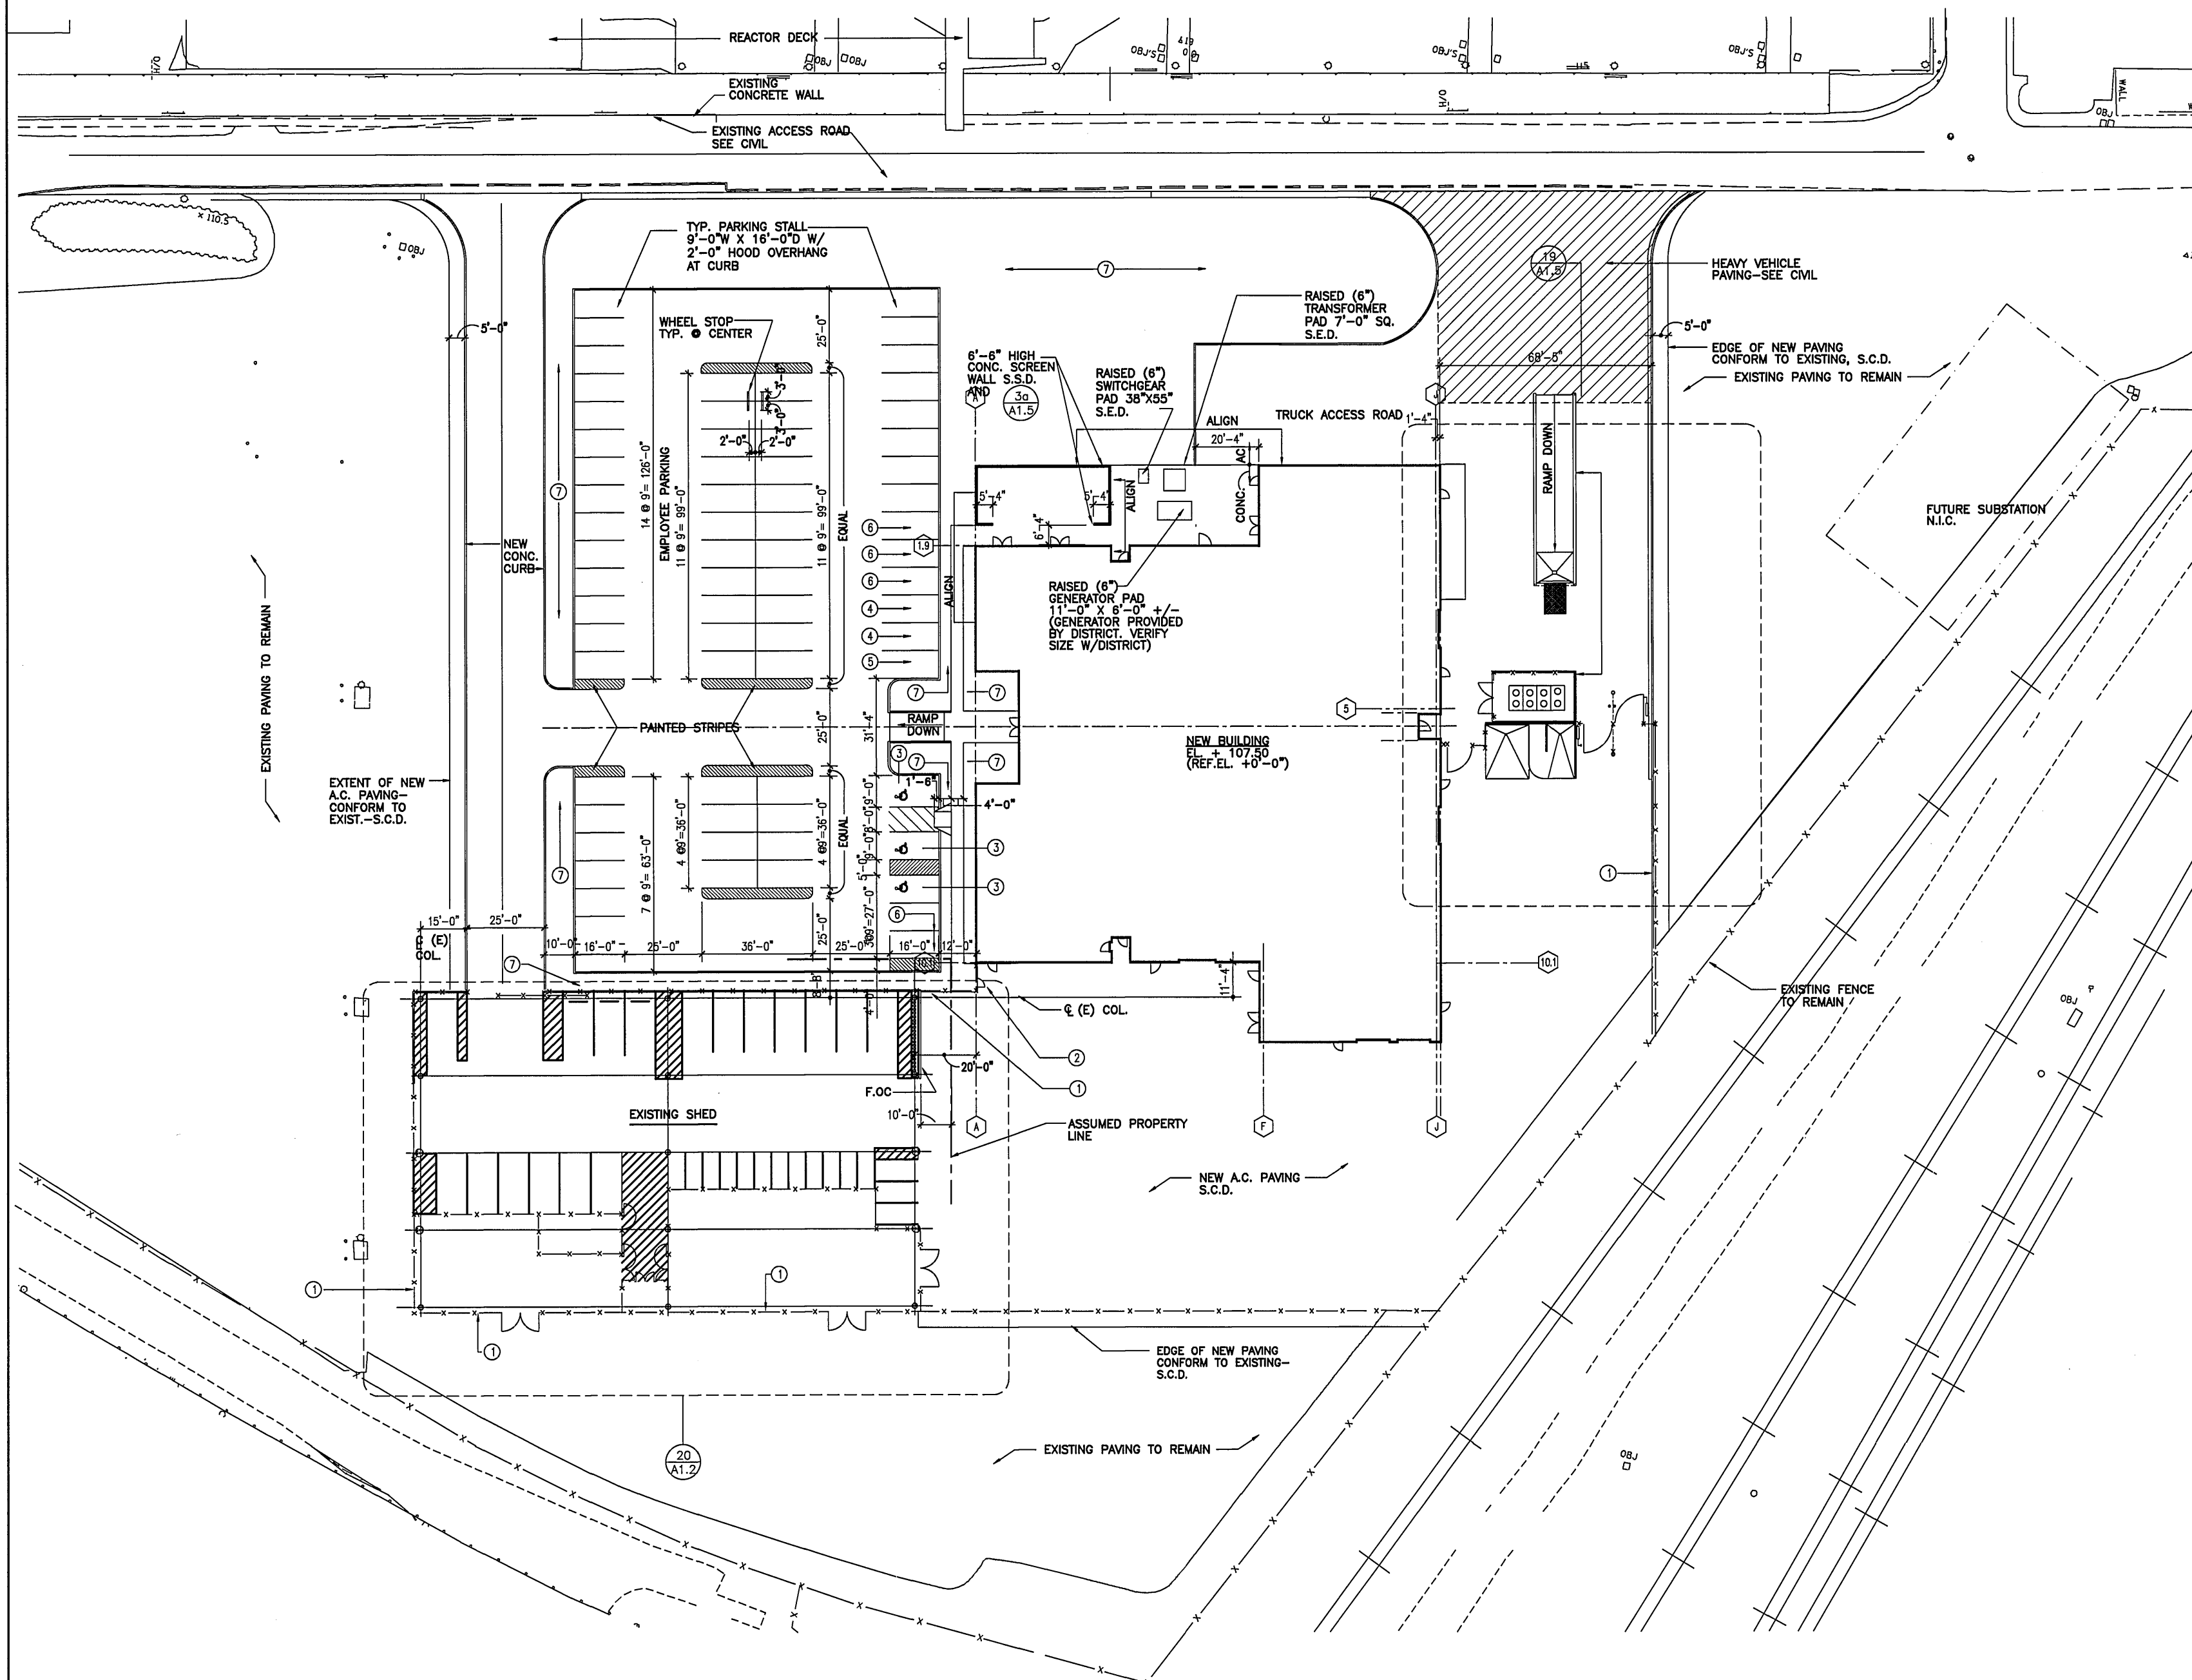

PARKING SUMMARY

67 FULL SIZE SPACES
2 HANDICAP SPACES
1 HC VAN SPACE

70 SPACES

KEY NOTES

- ① 6'-0" H CHAIN LINK FENCE W/ 3 STRANDS BARBED WIRE ABOVE - SEE 8/A1.5
- ② 3'-0" X 6'-0" CHAINLINK GATE
- ③ A.C. PARKING (ONE TO BE VAN ACCESSIBLE) - PROVIDE SIGNAGE AS REQ'D. BY CODE
- ④ PAVEMENT SIGNAGE TO READ: 'DISTRICT VEHICLES ONLY'
- ⑤ PAVEMENT SIGNAGE TO READ: 'PLANT MAINTENANCE SUPERINTENDENT'
- ⑥ PAVEMENT SIGNAGE TO READ: 'VISITOR'
- ⑦ 6" MIN. TOPSOIL GRADED AS REQUIRED, S.C.D.

IF SHEET IS LESS THAN 30" X 42"
IT IS A REDUCED PRINT
SCALE REDUCED ACCORDINGLY

EAST BAY MUNICIPAL UTILITY DISTRICT
SPECIAL DISTRICT No. 1
OAKLAND, CALIFORNIA


MAINTENANCE FACILITY SD 223 - A
WASTE WATER TREATMENT PLANT
TRA PROJECT NO. 96007.02

SITE PLAN

FACTORY
SCALE 1" = 20'-0"
DATE 13 FEB. 1998

DRAWING No.
A11
SHEET OF

SPECIFICATION NO.

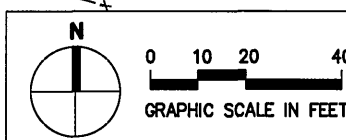


The
Radcliff
Architects

DATE 3/21/98
PLAN CHECK AND APPROVAL NO. 1

DESIGNED BY CH	DESIGN CHECKED BY SH	DRAWN BY CH, CH	SR. PROJ. ENGR. WH	APPROVED	BY	RED.	APP.	PRINCIPAL-OR-EQUAL, R.P.E. NO. 0
18DEC2012	18DEC2012	18DEC2012	18DEC2012	18DEC2012	18DEC2012	18DEC2012	18DEC2012	18DEC2012
1	2	3	4	5	6	7	8	9

PROJECT NO.	PROJECT SUPERVISOR
R.P.E. No.	R.P.E. No.

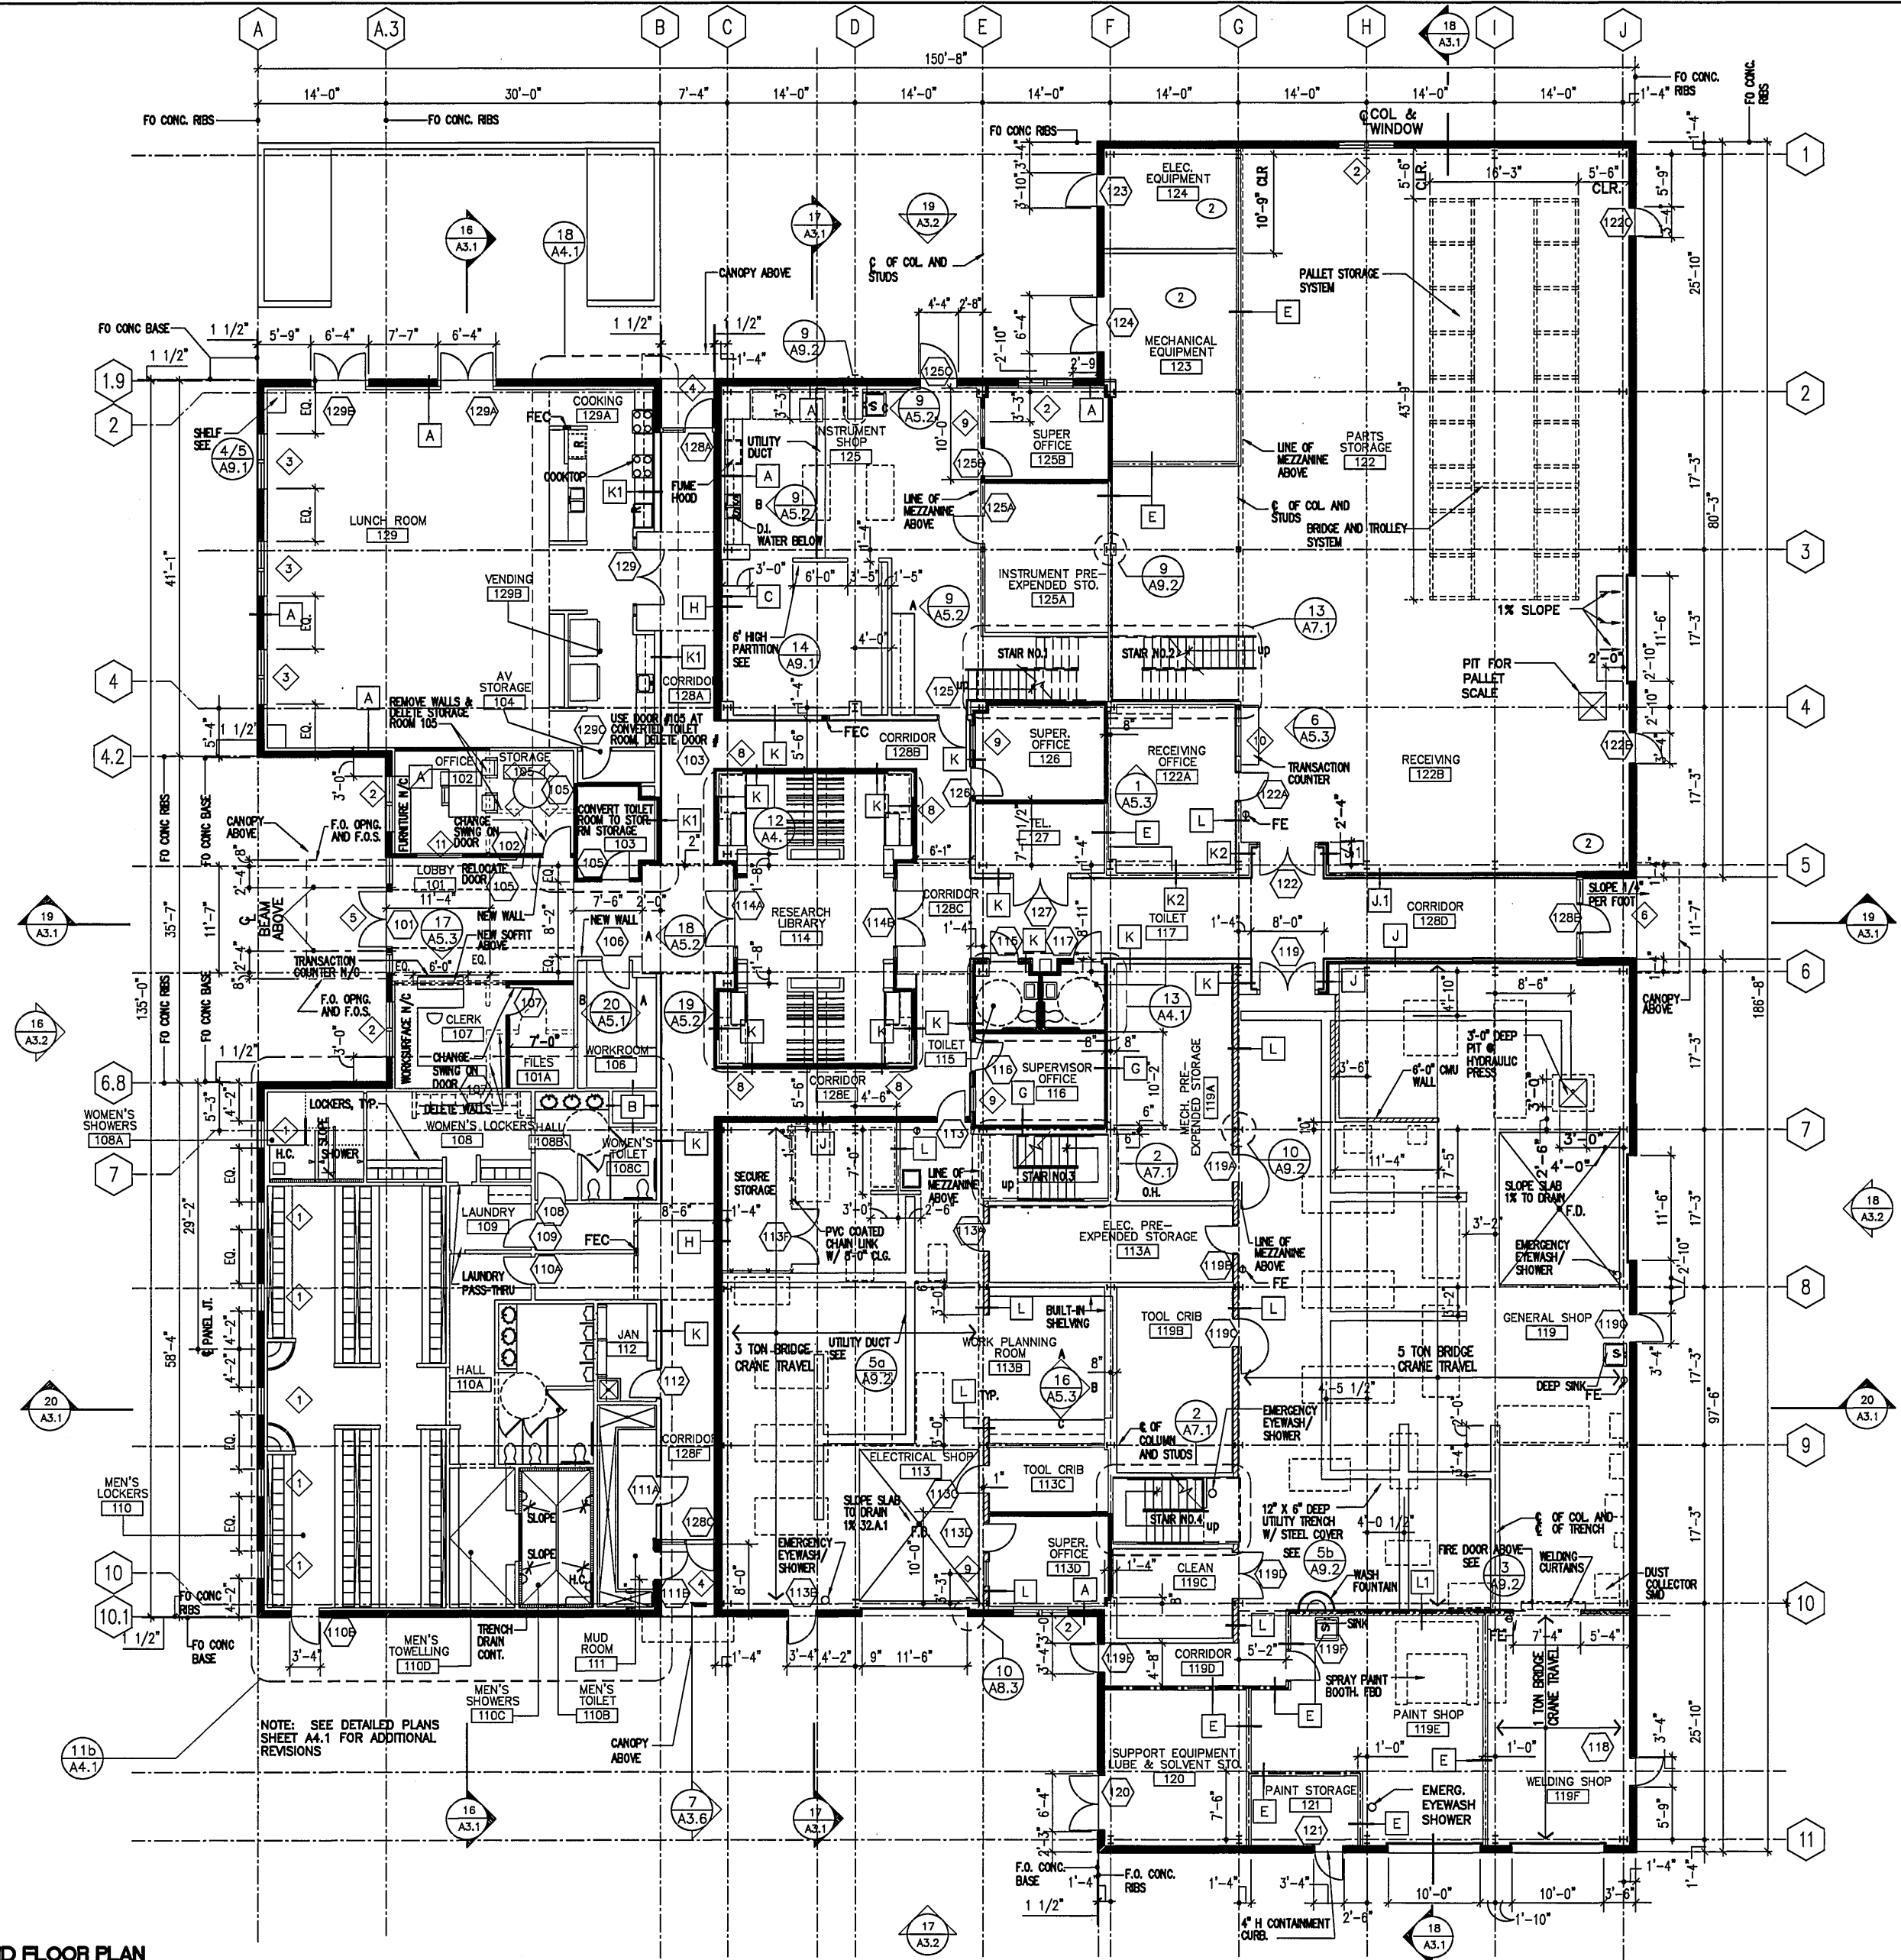

- SHEET NOTES**
- 1 PARTITION TYPE "P" IS TYPICAL - SEE A2.5 FOR ADDITIONAL WALL TYPES. PARTITION TYPES ARE NOTED ON PLANS AND CONTINUE UNTIL A DIRECTION CHANGE OCCURS IN THE WALL, U.O.N. WHERE TWO PARTITION TYPES ARE KEYS TO THE SAME PARTITION, TRANSITION OCCURS AT INTERSECTING PARTITION.
 - 2 SEE DRAWINGS OF OTHER DISCIPLINES FOR REQUIREMENTS IN THESE SPACES. (i.e. DRAINS, HOUSEKEEPING PADS, ETC.)
 - 3 DASHED OBJECTS ON THIS DRAWING INDICATE EQUIPMENT LOCATIONS. SEE A11.0 THRU A11.3 FOR ADDITIONAL INFORMATION.

- WALL LEGEND**
- CONC. WALL SSD
 - CMU WALL SSD
 - 1 HOUR RATED PARTITION
 - SOUND INSULATED PARTITION


IF SHEET IS LESS THAN 30" X 42"
IT IS A REDUCED PRINT
SCALE ACCORDINGLY

EAST BAY MUNICIPAL UTILITY DISTRICT
SPECIAL DISTRICT No. 1
OAKLAND, CALIFORNIA

MAINTENANCE FACILITY SD 223 - A
WASTE WATER TREATMENT PLANT
TRA PROJECT NO. 96007.02

GROUND FLOOR PLAN	
FACILITY	DRAWING No. A21
SCALE 1/8" = 1'-0"	SHEET OF
DATE 13 FEB. 1998	SPECIFICATION NO.


20 **GROUND FLOOR PLAN**
1/8" = 1'-0"

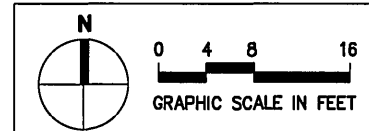

The
Ratcliff
Architects

DESIGNED BY	PROJECT NO.
DESIGN CHECKED BY	R.P.Z. No.
DRAWN BY	
IN. PROJ. ENGR.	
APPROVED	
PRINCIPAL-IN-CHARGE, R.P.Z. No.	

PROJECT NO.	180DEC2812
R.P.Z. No.	SD223A
DATE	3/31/98
REVISION	PLAN CHECK AND ADDENDUM NO.1

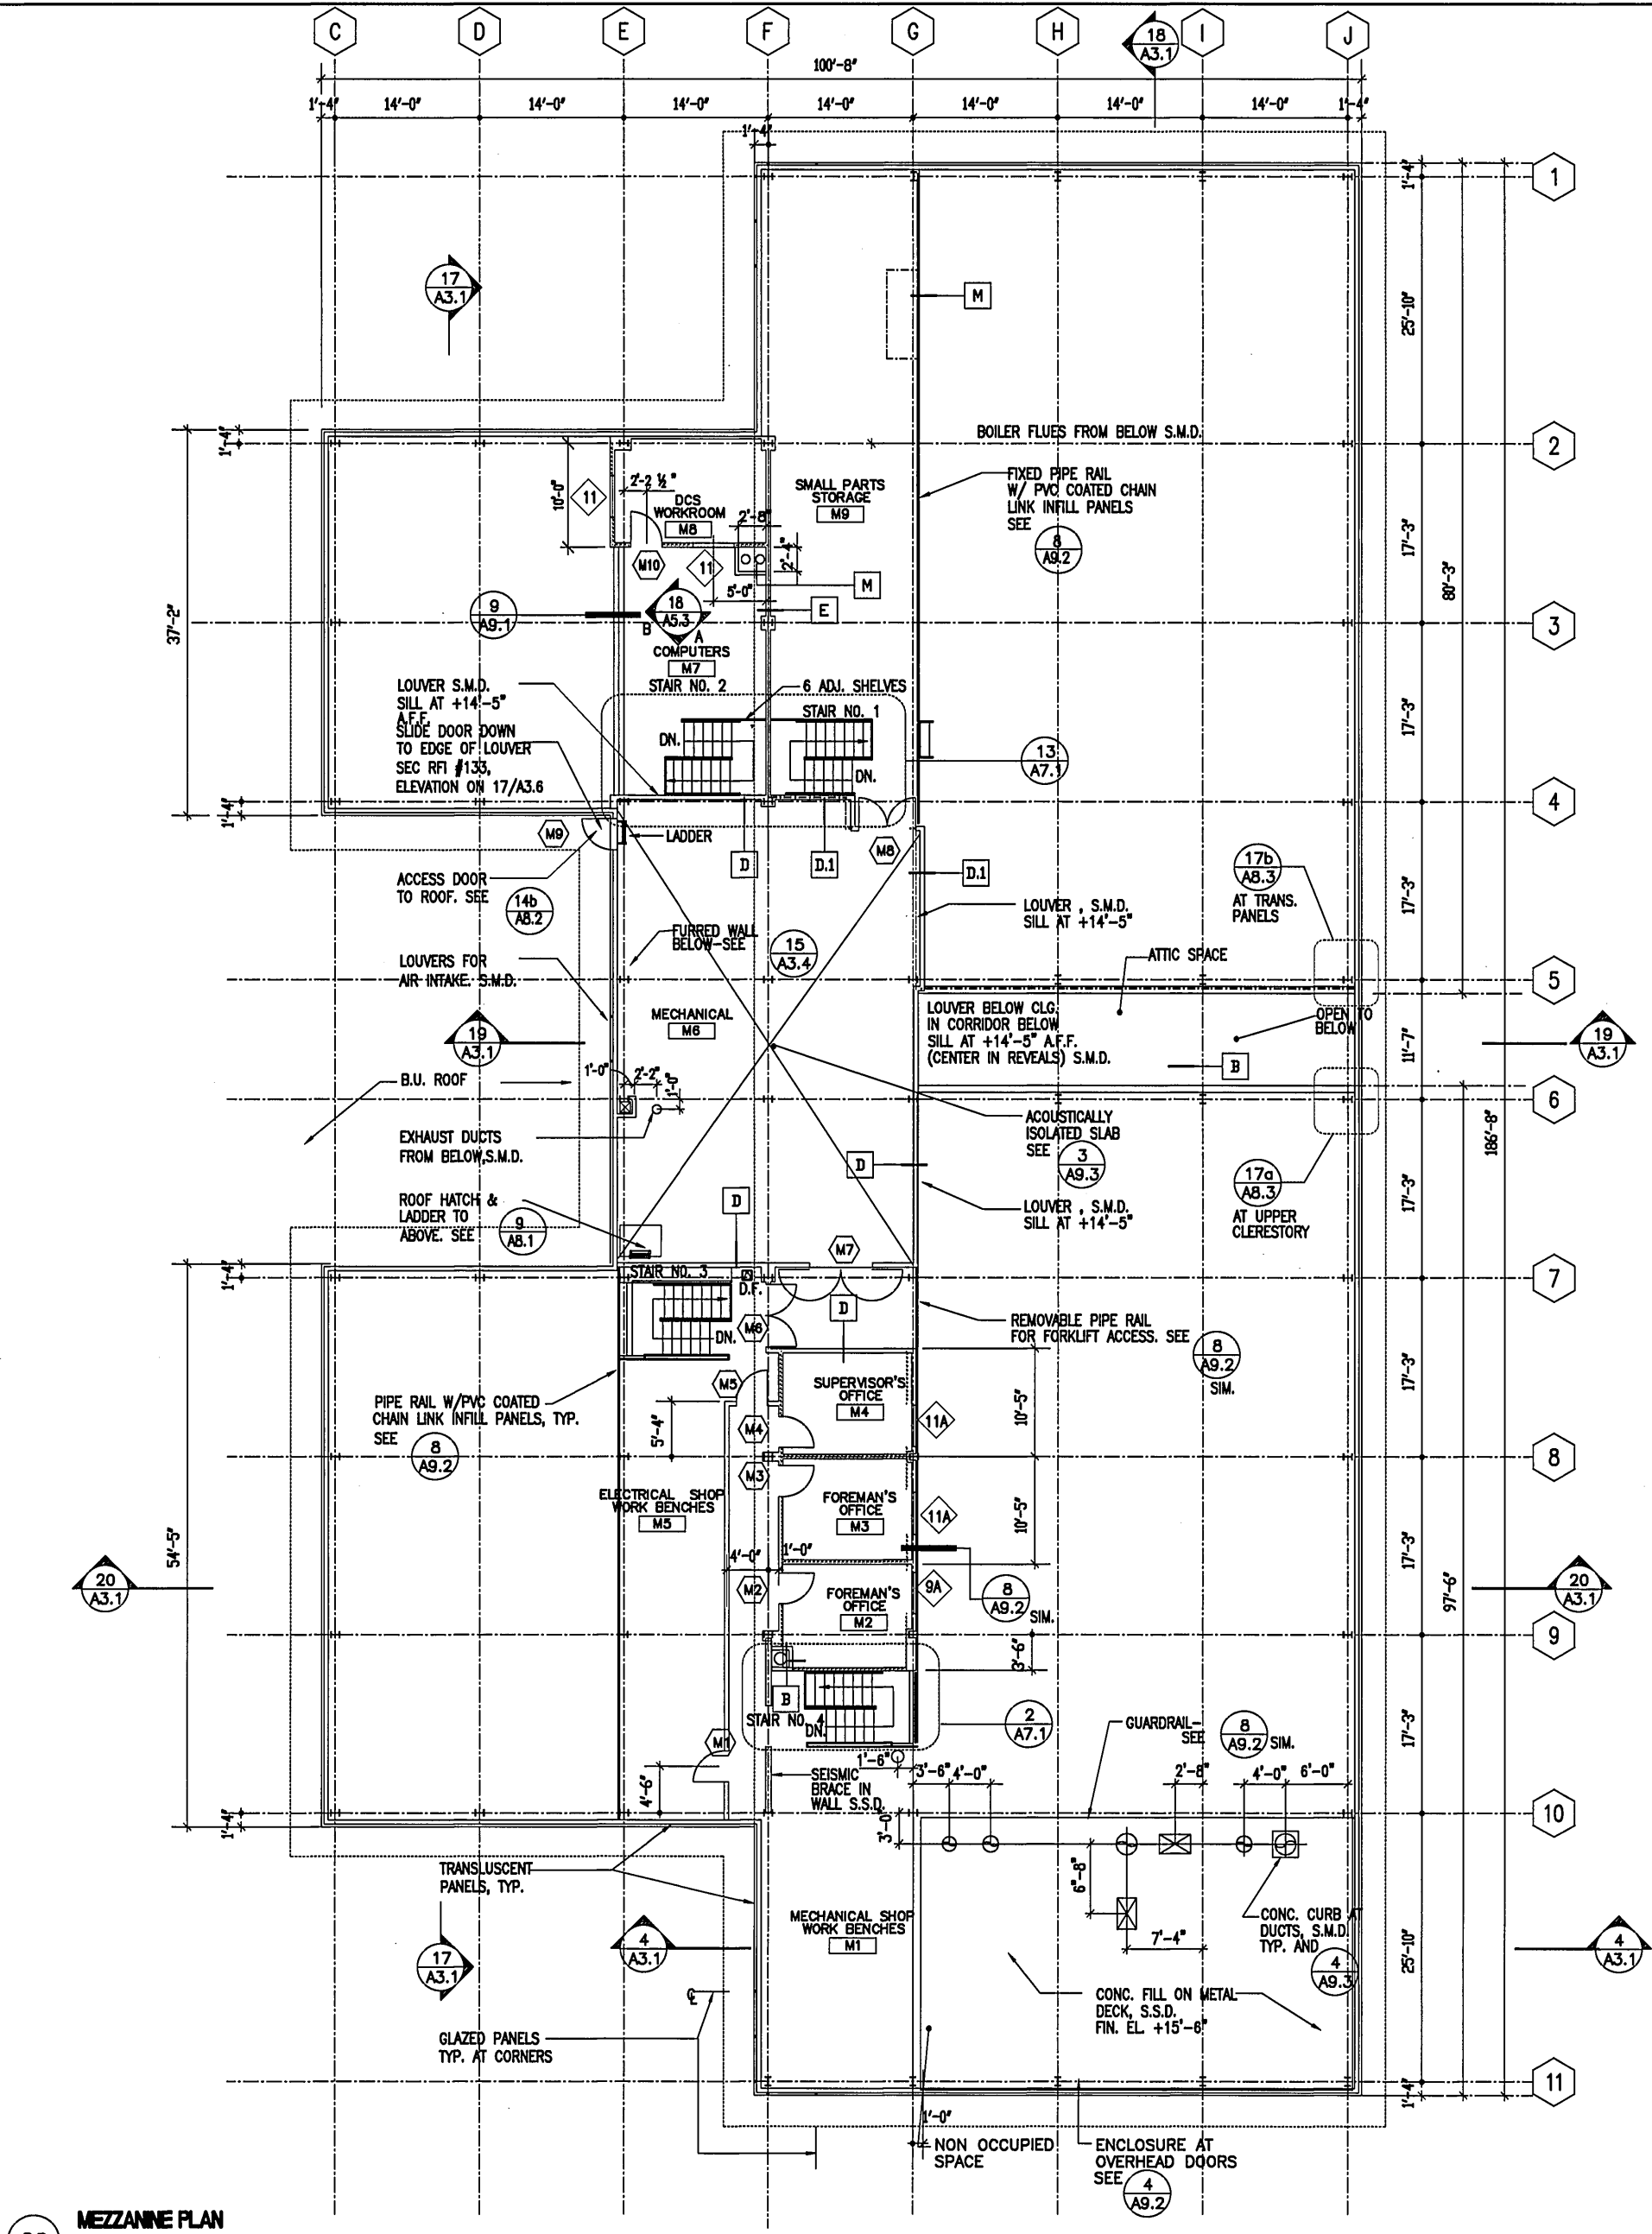

20 MEZZANINE PLAN

SHEET NOTES

- 1 PARTITION TYPE "F" IS TYPICAL - SEE A2.5 FOR ADDITIONAL WALL TYPES. PARTITION TYPES ARE NOTED ON PLANS AND CONTINUE UNTIL A DIRECTION CHANGE OCCURS IN THE WALL, U.O.N. WHERE TWO PARTITION TYPES ARE KEYED TO THE SAME PARTITION, TRANSITION OCCURS AT INTERSECTING PARTITION.
- 2 SEE DRAWINGS OF OTHER DISCIPLINES FOR REQUIREMENTS IN THESE SPACES. (i.e. DRAINS, HOUSEKEEPING PADS, ETC.)

- WALL LEGEND:**
- ===== = CONC. WALL SSD
 - ===== = CMU WALL SSD
 - ===== = 1 HOUR RATED PARTITION
 - ===== = SOUND INSULATED PARTITION

IF SHEET IS LESS THAN 30" X 42"
IT IS A REDUCED PRINT
SCALE REDUCED ACCORDINGLY


EAST BAY MUNICIPAL UTILITY DISTRICT
SPECIAL DISTRICT No. 1
OAKLAND, CALIFORNIA

MAINTENANCE FACILITY SD 223 - A
WASTE WATER TREATMENT PLANT
TRA PROJECT NO. 96007.02



MEZZANINE PLAN

FACILITY
SCALE 1/8" = 1'-0"
DATE 13 FEB. 1998


DRAWING NO. A22
SHEET OF
SPECIFICATION NO.

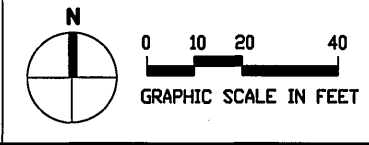

DESIGNED BY JV	PROJECT NO.
DESIGN CHECKED BY JH	DATE
DRAWN BY GB	DATE
IN CHARGE BY JH	DATE
APPROVED	DATE
PRINCIPAL-IN-CHARGE, R.P.E., REG.	DATE

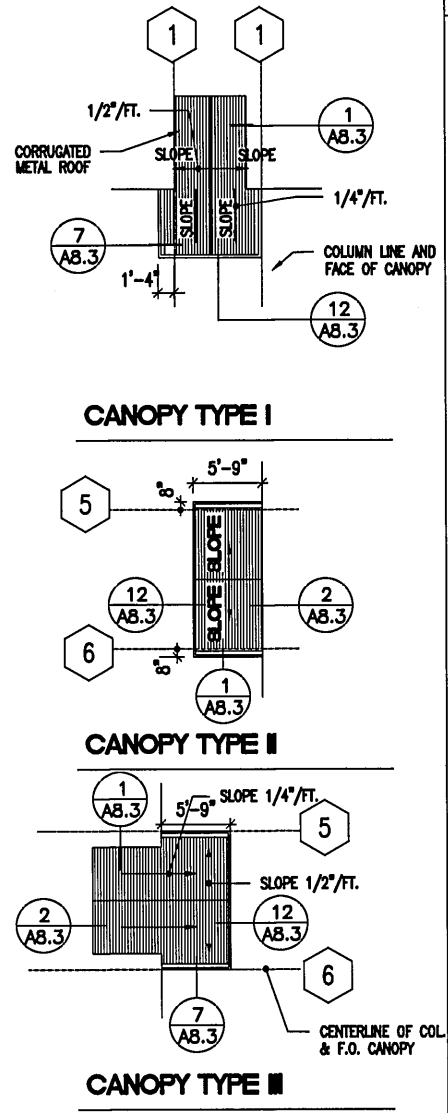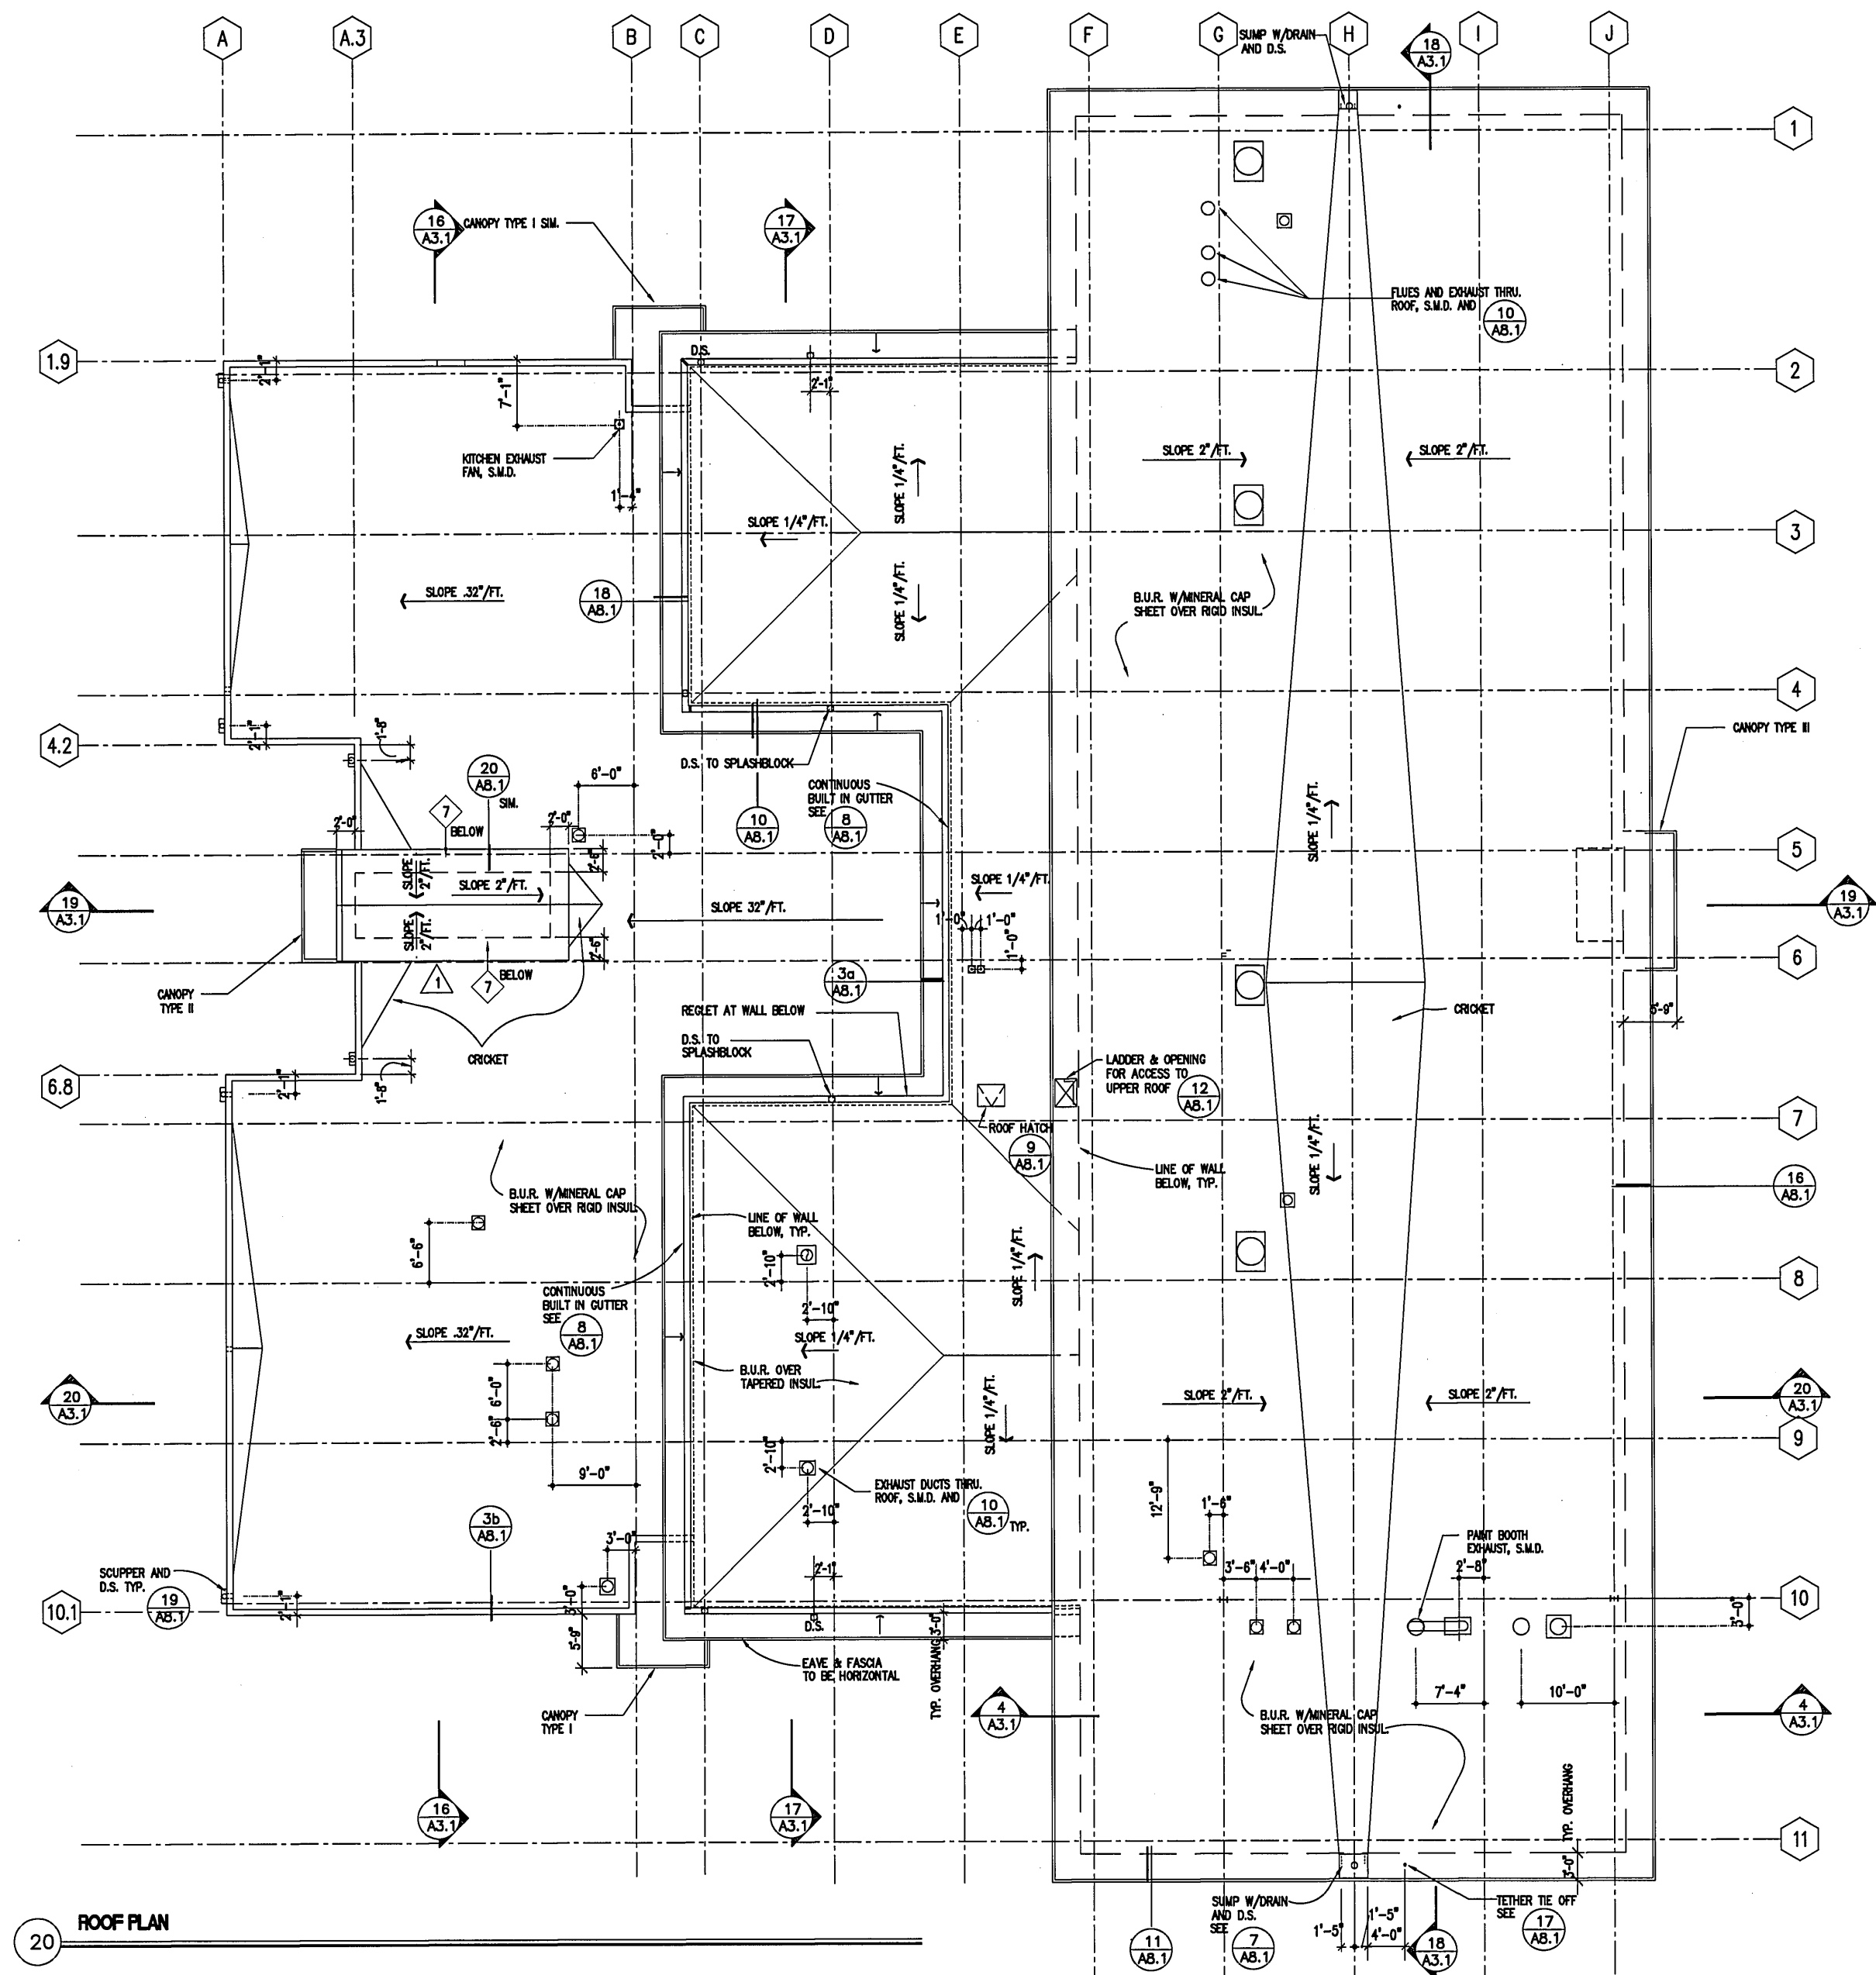

20 ROOF PLAN

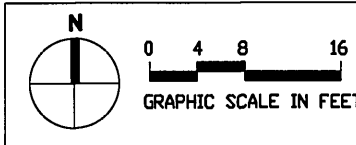

NO.	DATE	REVISION	BY	REC.	APP.
1	3/29/98	PLAN CHECK AND REVISION NO. 1			
2	4/14/98	BY SERVICES			
3	10/02/2012	RECORD DRAWING			

PROJECT NO.	SD223A
PROJECT SUPERVISOR	
DATE	13 FEB. 1998


IF SHEET IS LESS THAN 30" X 42"
IT IS A REDUCED PRINT
SCALE REDUCED ACCORDINGLY

EAST BAY MUNICIPAL UTILITY DISTRICT
SPECIAL DISTRICT NO. 1
OAKLAND, CALIFORNIA


MAINTENANCE FACILITY SD 223 - A
WASTE WATER TREATMENT PLANT
TRA PROJECT NO. 96007.02

ROOF PLAN


FACILITY	DRAWING NO.
SCALE 1/8" = 1'-0"	A23
DATE 13 FEB. 1998	SHEET
	OF
	SPECIFICATION NO.

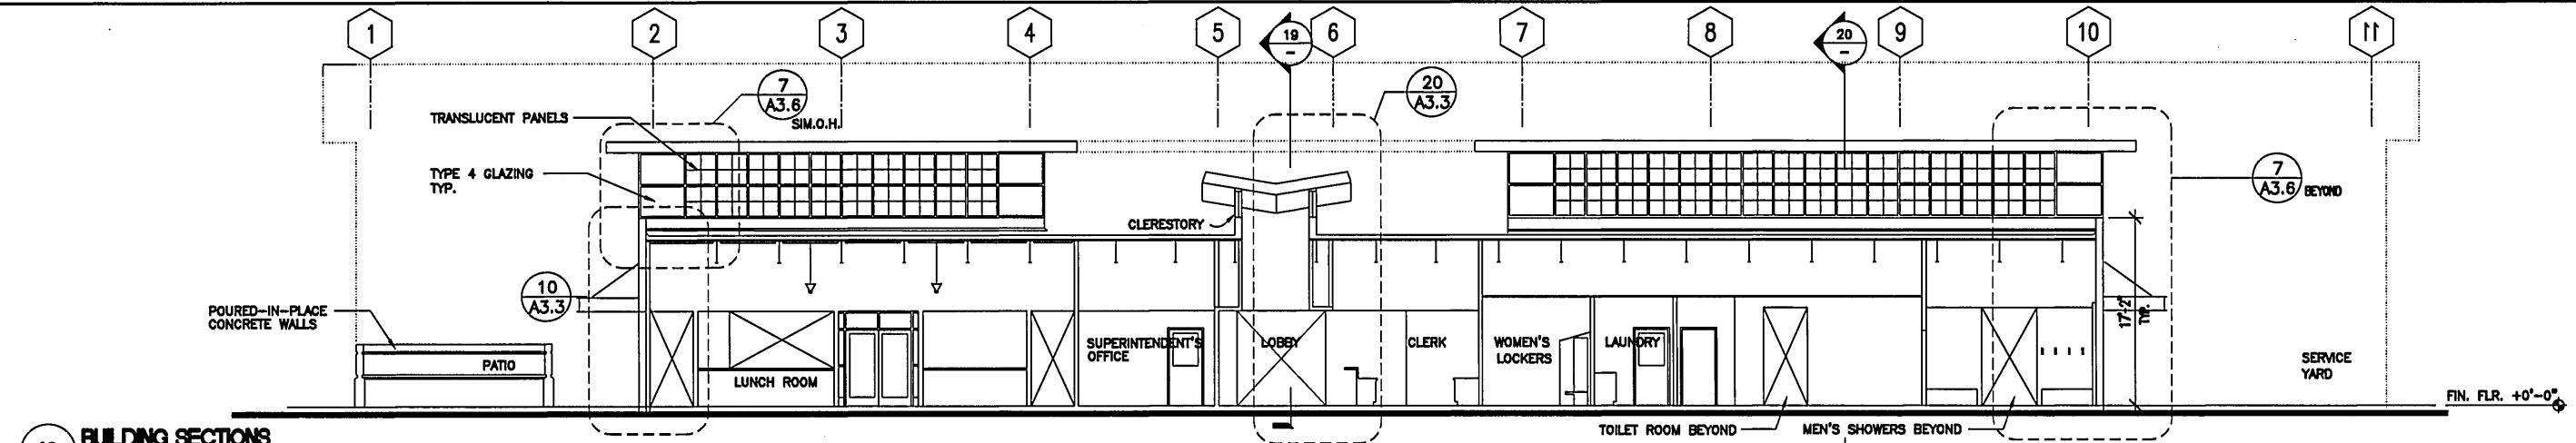


16 BUILDING SECTIONS
1/8"=1'-0"

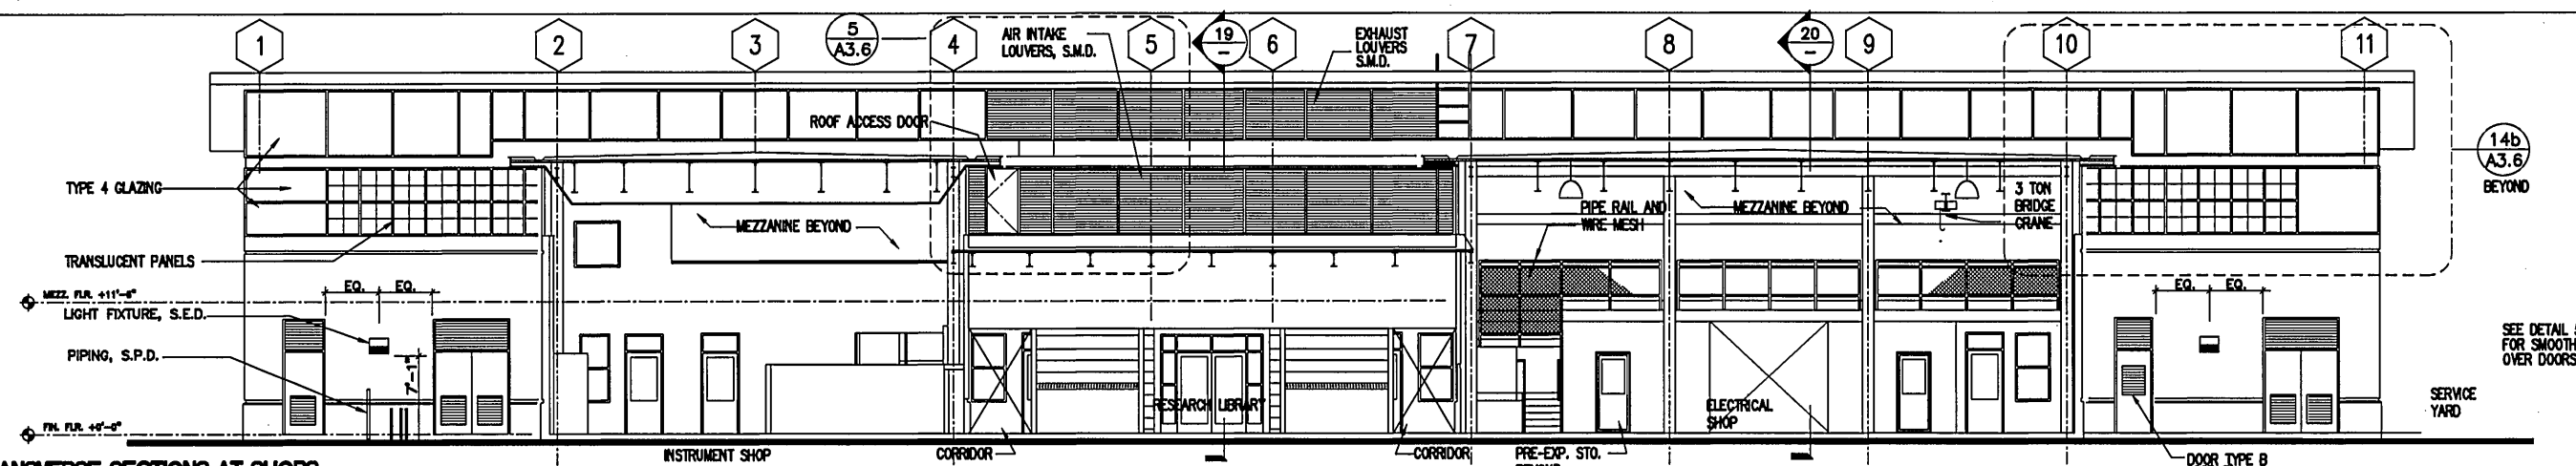


17 TRANSVERSE SECTIONS AT SHOPS
1/8"=1'-0"

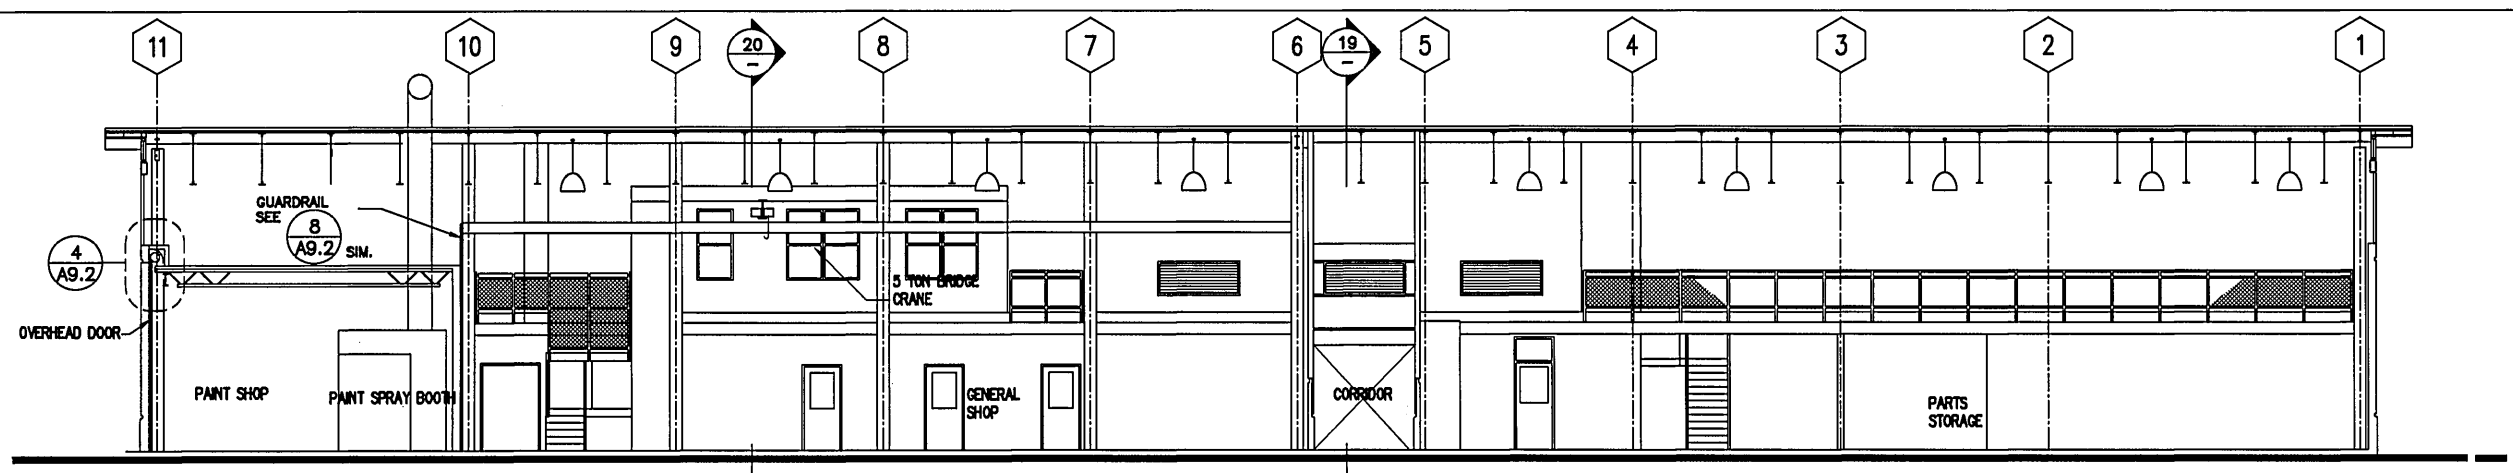


18 TRANSVERSE SECTION AT GENERAL SHOP AND PARTS STORAGE
1/8"=1'-0"

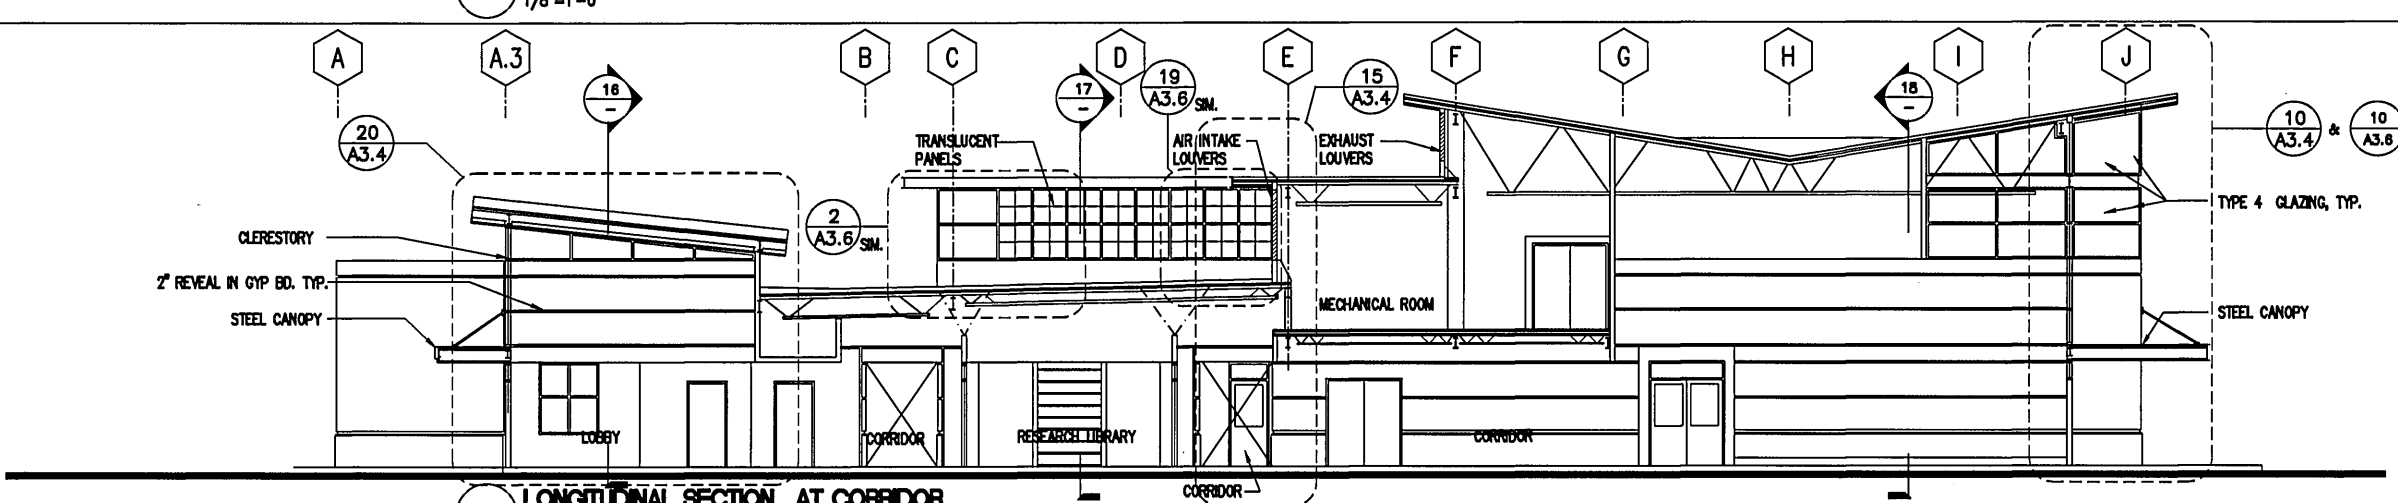

19 LONGITUDINAL SECTION AT CORRIDOR
1/8"=1'-0"

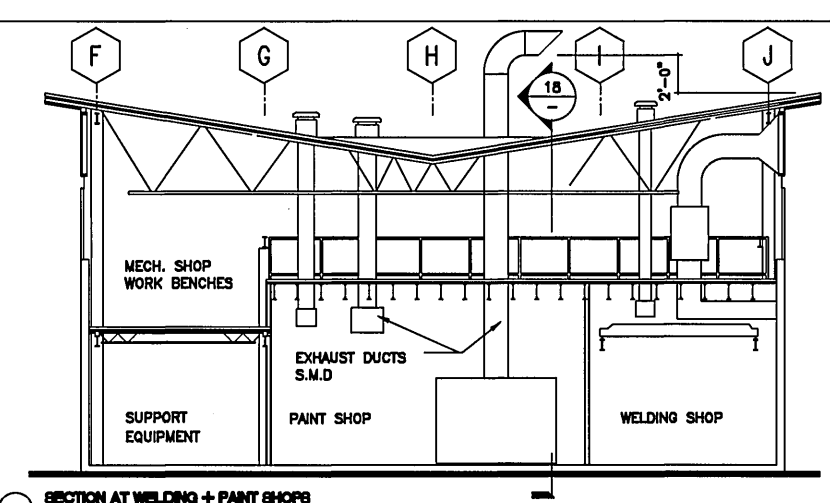

20 SECTION AT WELDING + PAINT SHOPS
1/8"=1'-0"

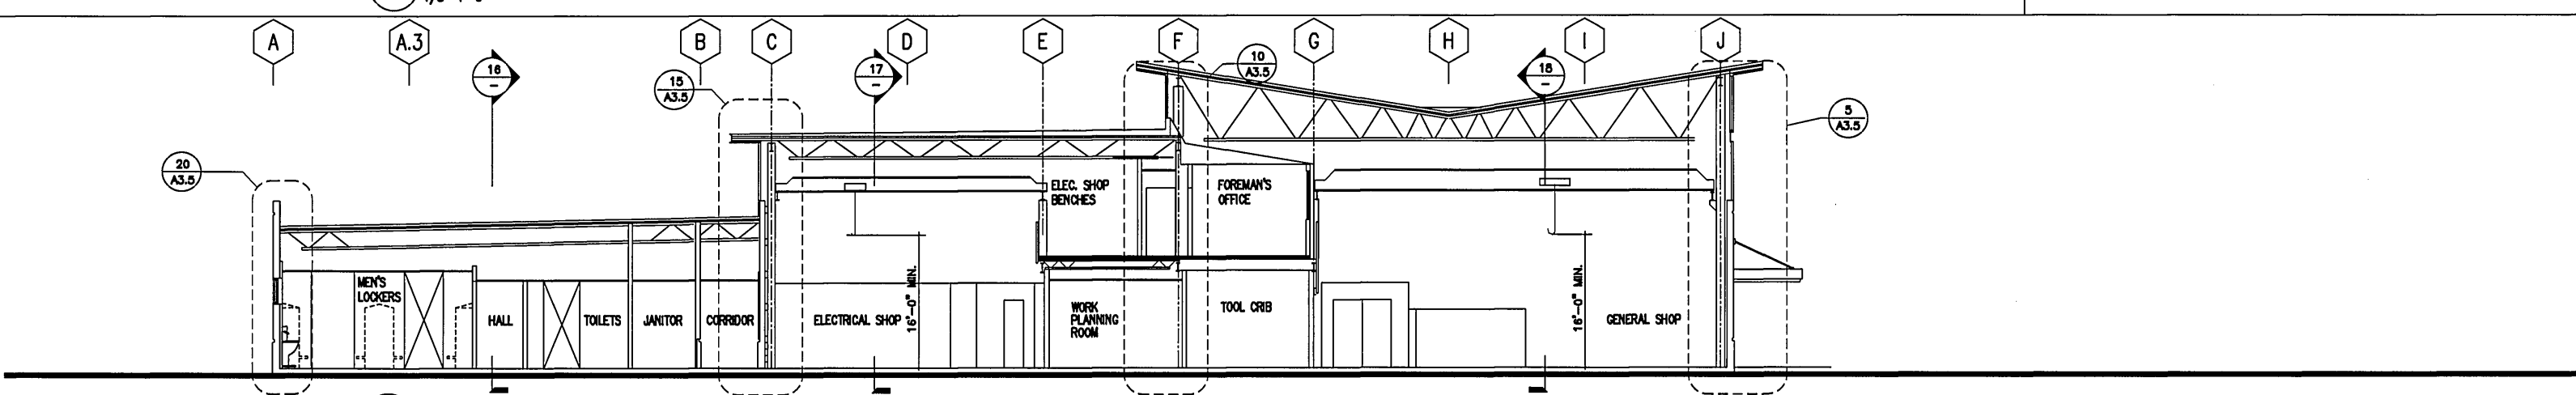

20 LONGITUDINAL SECTION AT SHOPS
1/8"=1'-0"

- SHEET NOTES**
1. SEE DETAILED ELEVATIONS SHT. A3.6 FOR CLERESTORY DELINEATION
 2. SEE 9/A3.3 FOR TYPICAL PANEL REVEALS
 3. DUCTWORK SHOWN IS FOR CLARITY OF INTENT. SEE MECHANICAL DRAWINGS FOR ADDITIONAL DUCTWORK AND NOTES. SEE REFLECTED CEILING PLANS FOR LOCATION CRITERIA FOR DUCTS AND DIFFUSERS.


IF SHEET IS LESS THAN 30" X 42"
IT IS A REDUCED PRINT
SCALE REDUCED ACCORDINGLY

EAST BAY MUNICIPAL UTILITY DISTRICT
SPECIAL DISTRICT No. 1
OAKLAND, CALIFORNIA

MAINTENANCE FACILITY SD 223 - A
WASTE WATER TREATMENT PLANT
TRA PROJECT NO. 96007.02

BUILDING SECTIONS





FACILITY	DRAWING No.
SCALE 1/8" = 1'-0"	A3.1
DATE 13 FEB. 1998	SHEET OF
SPECIFICATION No.	

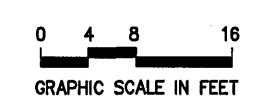

The Ratcliff Architects

DESIGNED BY DR	DESIGN CHECKED BY DR	DRAWN BY AN OS	APPROVED
1/DEC/2012	1/DEC/2012	1/DEC/2012	1/DEC/2012
1	1	1	1
DATE	DATE	DATE	DATE
1/DEC/2012	1/DEC/2012	1/DEC/2012	1/DEC/2012
PLAN CHECK AND APPROVAL NO. 1	REVISION	BY	RECD.
1	1	1	1
DATE	DATE	DATE	DATE
1/DEC/2012	1/DEC/2012	1/DEC/2012	1/DEC/2012
PLAN CHECK AND APPROVAL NO. 1	REVISION	BY	RECD.
1	1	1	1
DATE	DATE	DATE	DATE
1/DEC/2012	1/DEC/2012	1/DEC/2012	1/DEC/2012

PROJECT MGR.	R.P.E. No.
PROJECT SUPERVISOR	R.P.E. No.
DESIGNED BY DR	R.P.E. No.
DESIGN CHECKED BY DR	R.P.E. No.
DRAWN BY AN OS	R.P.E. No.
APPROVED	R.P.E. No.
1/DEC/2012	1/DEC/2012
1	1
DATE	DATE
1/DEC/2012	1/DEC/2012

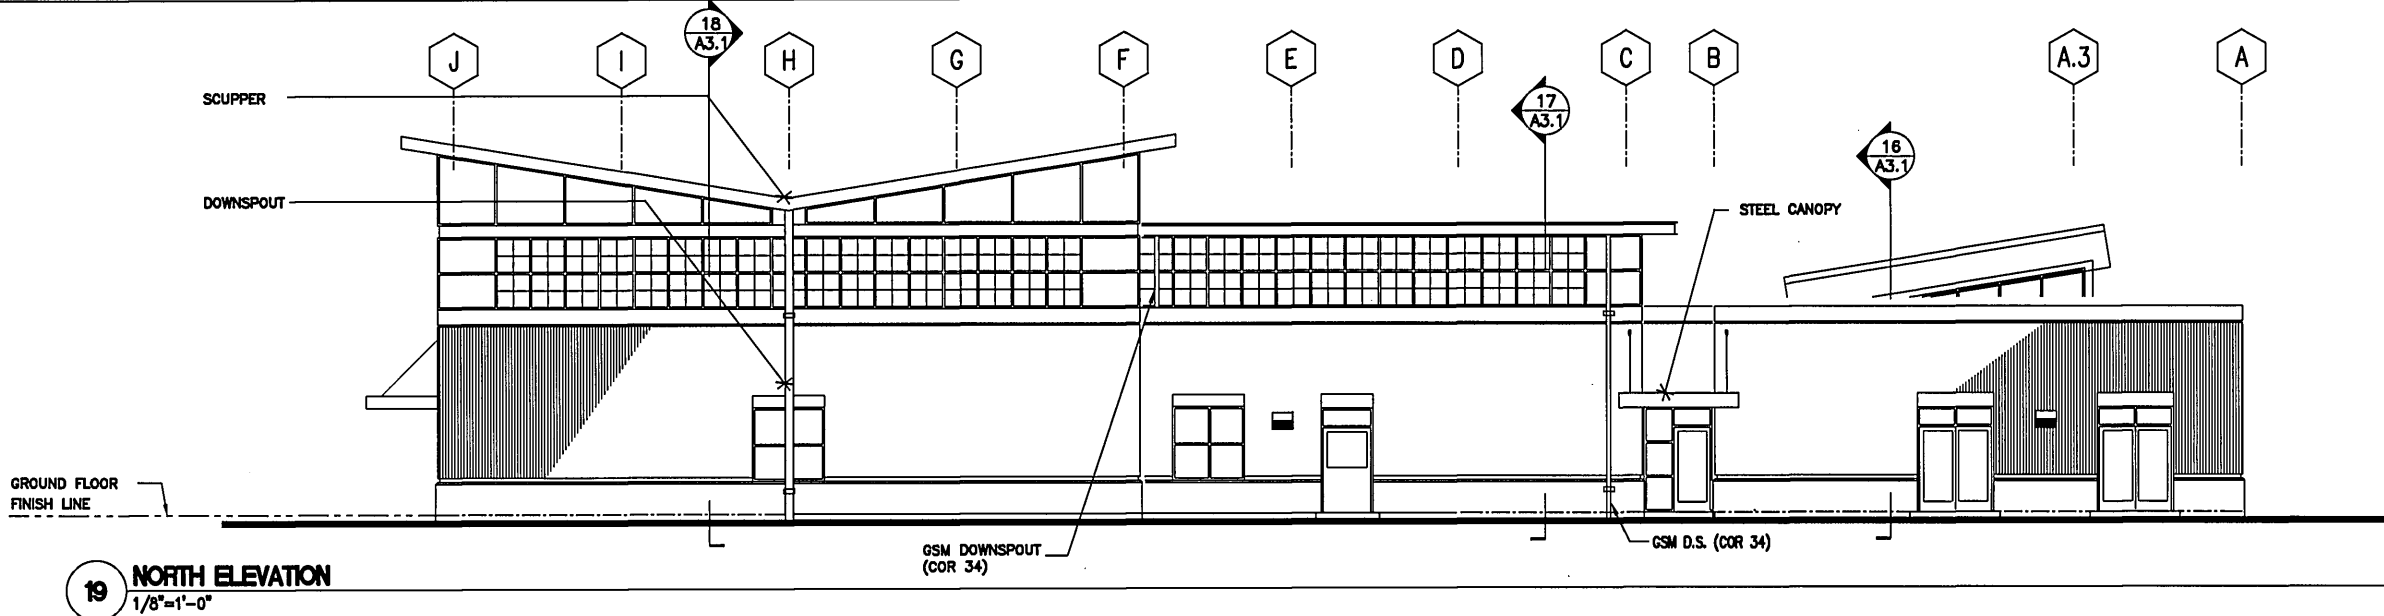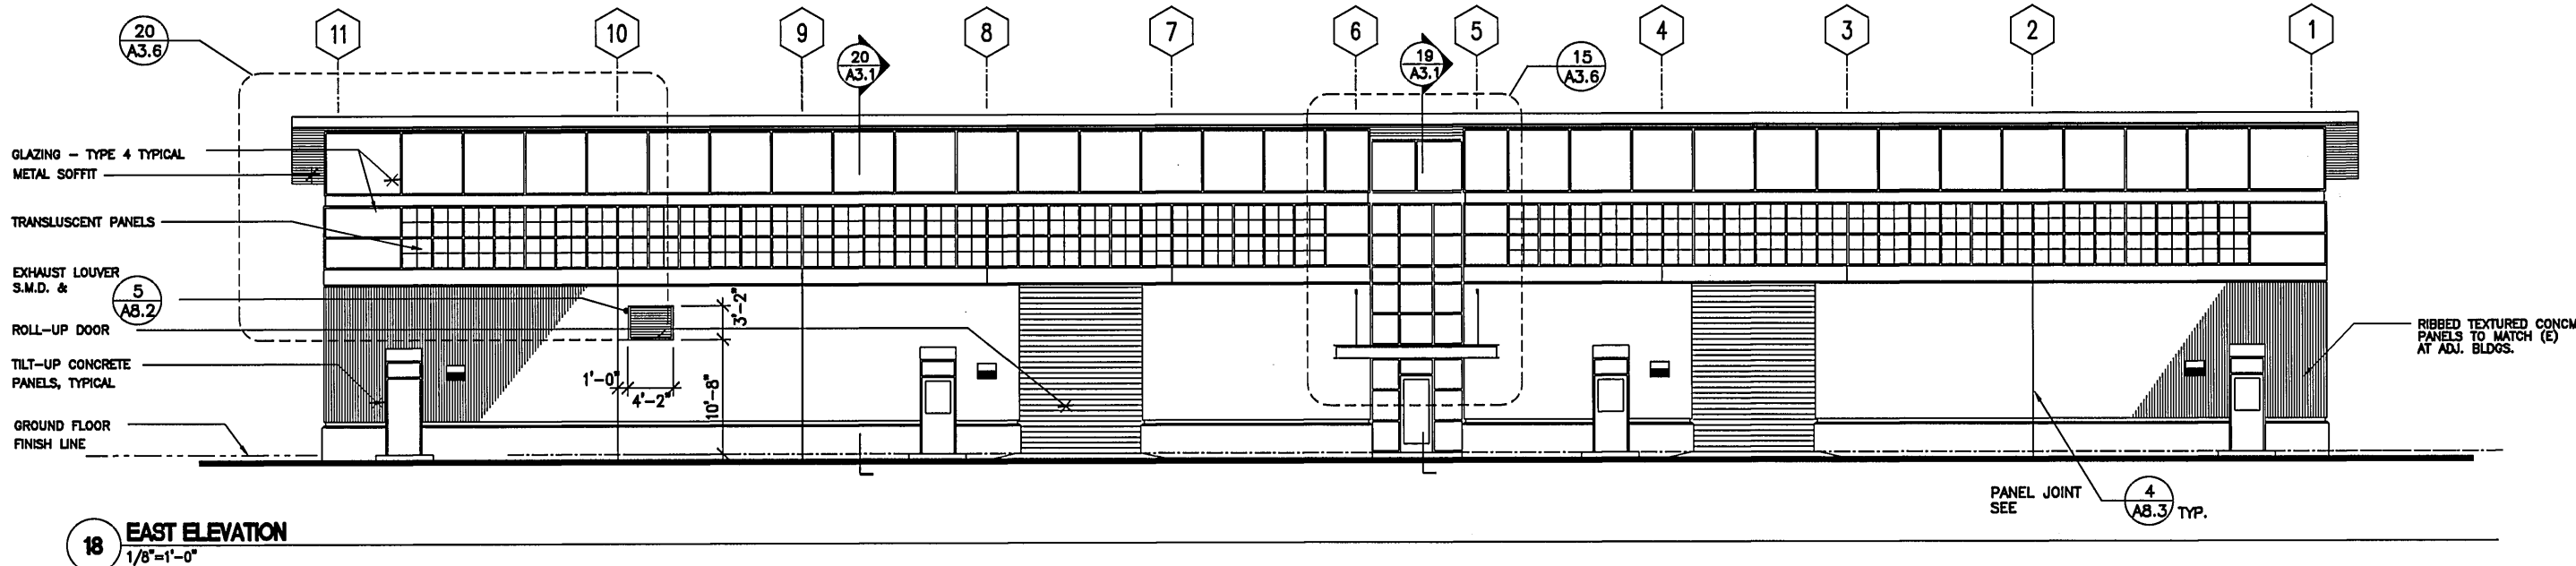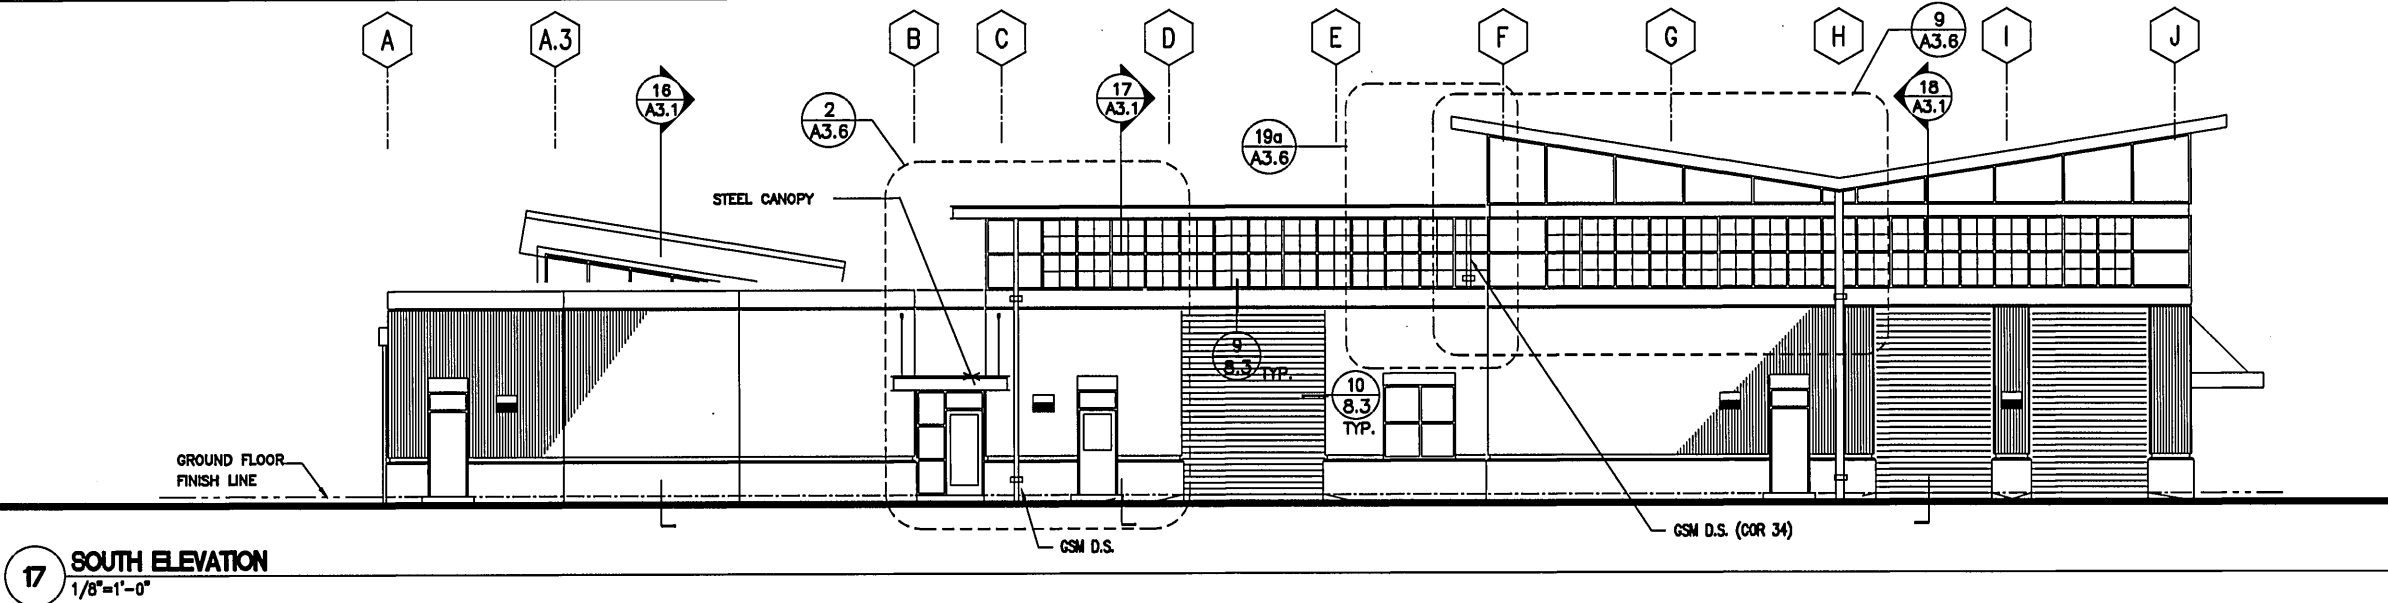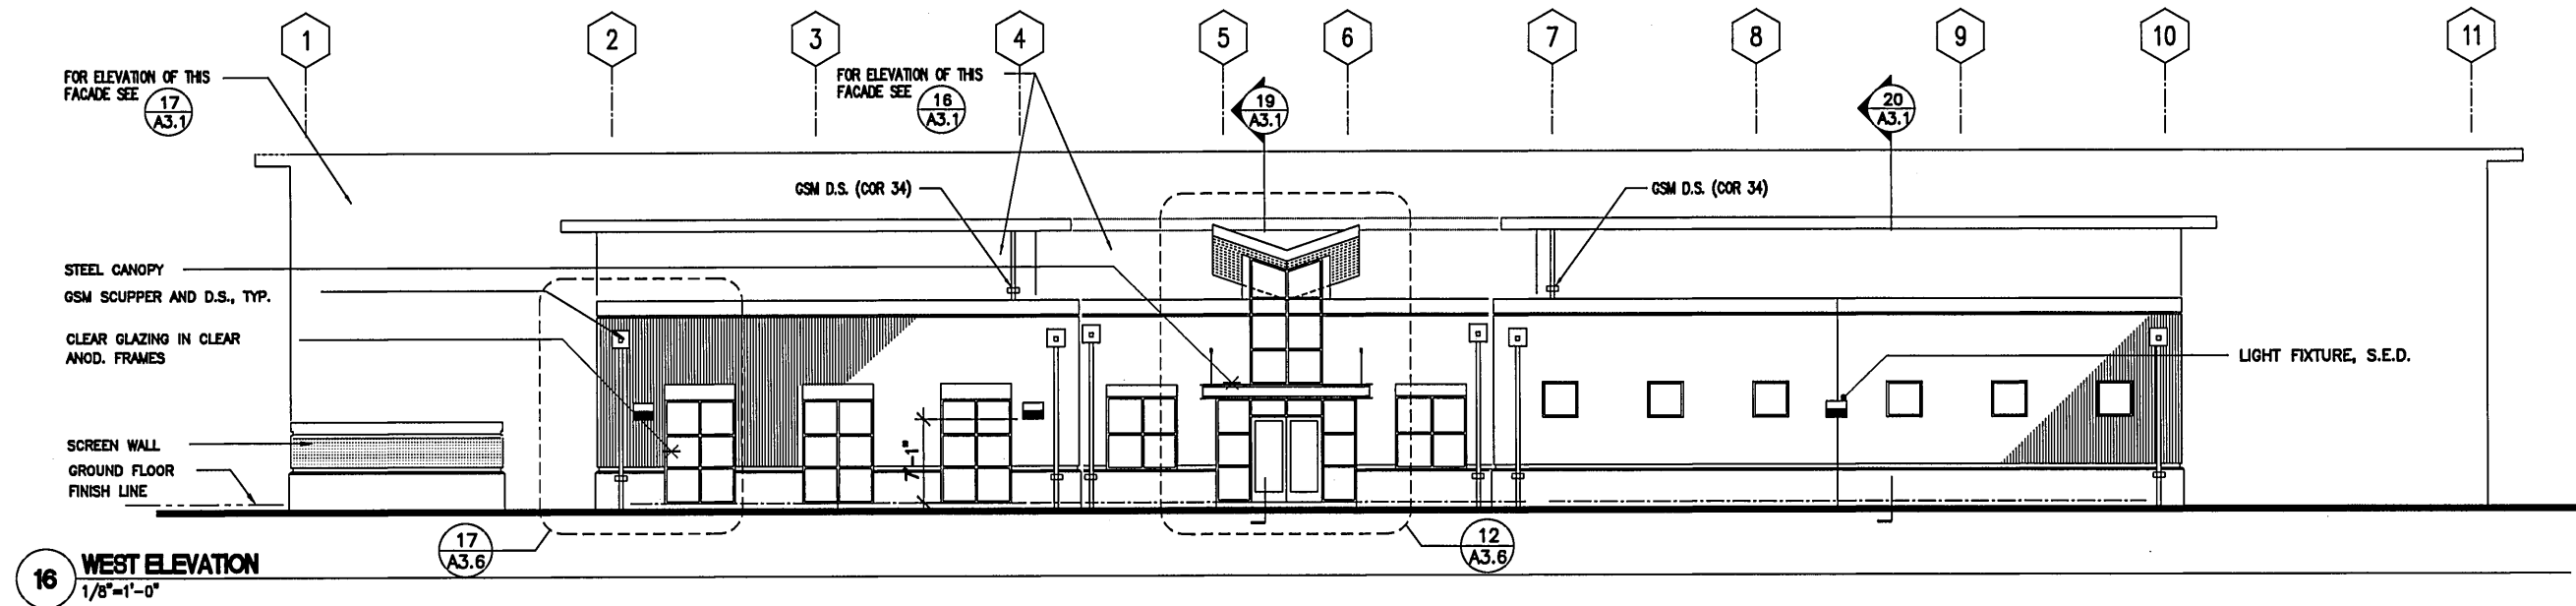

NOTE:
FINISH COLOR FOR ALL STEEL CHANNELS
SHALL MATCH "DEX-O-TEX 211 GREEN."

FINISH COLOR FOR ALL EXTERIOR HOLLOW
METAL DOORS AND OVERHEAD ROLLUP
DOORS SHALL BE "SHERWIN WILLIAMS" 2086
"GATE WAY GRAY".

FINISH OF HIGH ROOF FASCIA SHALL BE
"WHITE" TO MATCH KALWALL.

FINISH OF METAL SOFFIT SHALL BE
"SNOW DRAFT WHITE".

FINISH OF CANOPY SOFFIT LIGHT FIXTURES
SHALL BE WHITE.

SHEET NOTES

1. SEE DETAILED ELEVATIONS SHT. A3.6
FOR CLERESTORY DELINEATION
2. SEE 5/A3.3 FOR TYPICAL PANEL REVEALS

IF SHEET IS LESS THAN 30" X 42"
IT IS A REDUCED PRINT
SCALE REDUCED ACCORDINGLY

EAST BAY MUNICIPAL UTILITY DISTRICT
SPECIAL DISTRICT No. 1
OAKLAND, CALIFORNIA

MAINTENANCE FACILITY SD 223 - A
WASTE WATER TREATMENT PLANT
TRA PROJECT NO. 96007.02

EXTERIOR ELEVATIONS

FACILITY
SCALE 1/8" = 1'-0"
DATE 13 FEB.1998

DRAWING No.
A32
SHEET OF

SPECIFICATION NO.

0 4 8 16
GRAPHIC SCALE IN FEET

The Ratcliff
Architects


DESIGNED BY DW	PROJECT MAN. R.P.E. 1A
DESIGN CHECKED BY BH	
DRAWN BY AJ/M	
SR. PROJ. ENGR. 1A	
APPROVED	
BY	APP.
PRINCIPAL-IN-CHARGE, R.P.E. NO.0	

PROJECT MAN. R.P.E. 1A
PROJECT SUPERVISOR R.P.E. 1A


DRAWING INDEX

- S1.1 GENERAL NOTES, ABBREVIATIONS, SYMBOLS, DRAWING INDEX
- S2.1 FOUNDATION PLAN
- S2.2 MEZZANINE FLOOR FRAMING PLAN
- S2.3 ROOF FRAMING PLAN
- S2.4 ROOF FRAMING PLAN - EXISTING MAINTENANCE BLDG.
- S2.5 ROOF FRAMING PLAN/DETAILS - EXISTING SHED
- S3.1 PANEL ELEVATIONS
- S3.2 PANEL ELEVATIONS
- S3.3 PANEL ELEVATIONS
- S3.4 PANEL ELEVATIONS
- S5.1 TYPICAL CONCRETE DETAILS
- S5.2 TYPICAL FOOTING DETAILS
- S5.3 TYPICAL CONCRETE DETAILS
- S5.4 WALL DETAILS
- S5.5 MASONRY DETAILS
- S7.1 TYPICAL STEEL DETAILS
- S7.2 TYPICAL STEEL DETAILS
- S7.3 STEEL BRACED FRAME DETAILS
- S7.4 TYPICAL STEEL DETAILS
- S7.5 TYPICAL STEEL DETAILS


- 100% SUBMITTAL
- IF THIS SHEET IS LESS THAN 30" X 42",
IT IS A REDUCED PRINT
SCALE ACCORDINGLY
- EAST BAY MUNICIPAL UTILITY DISTRICT
SPECIAL DISTRICT NO. 1
OAKLAND, CALIFORNIA
- MAINTENANCE FACILITY, SD 2
- REGISTERED PROFESSIONAL ENGINEER
JOSEPH R. SUYODAN
No. 2185
Exp. 12-31-01

- | | | |
|---|---|-----------------------|
|  | MAINTENANCE FACILITY - SD 2
WASTE WATER TREATMENT PLANT
TRA PROJECT NO. 96007.02 | |
| | GENERAL NOTES, ABBREVIATIONS,
SYMBOLS, DRAWING INDEX | |
| PROVIDOR | FACILITY
SCALE | DRAWING No. SL |

- | | | |
|-----------------|--------------|-------|
| DATE | 23 MAR. 1998 | SHEET |
| SPECIFICATION N | | |

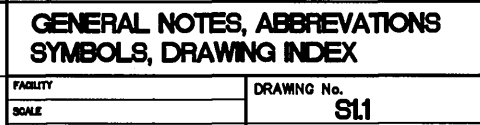


FILE: F:\96MIS\2\Structure\96IS511.dwg.DWG 02/10/98 at 11:43
XREF: 61651-tbl.dwg

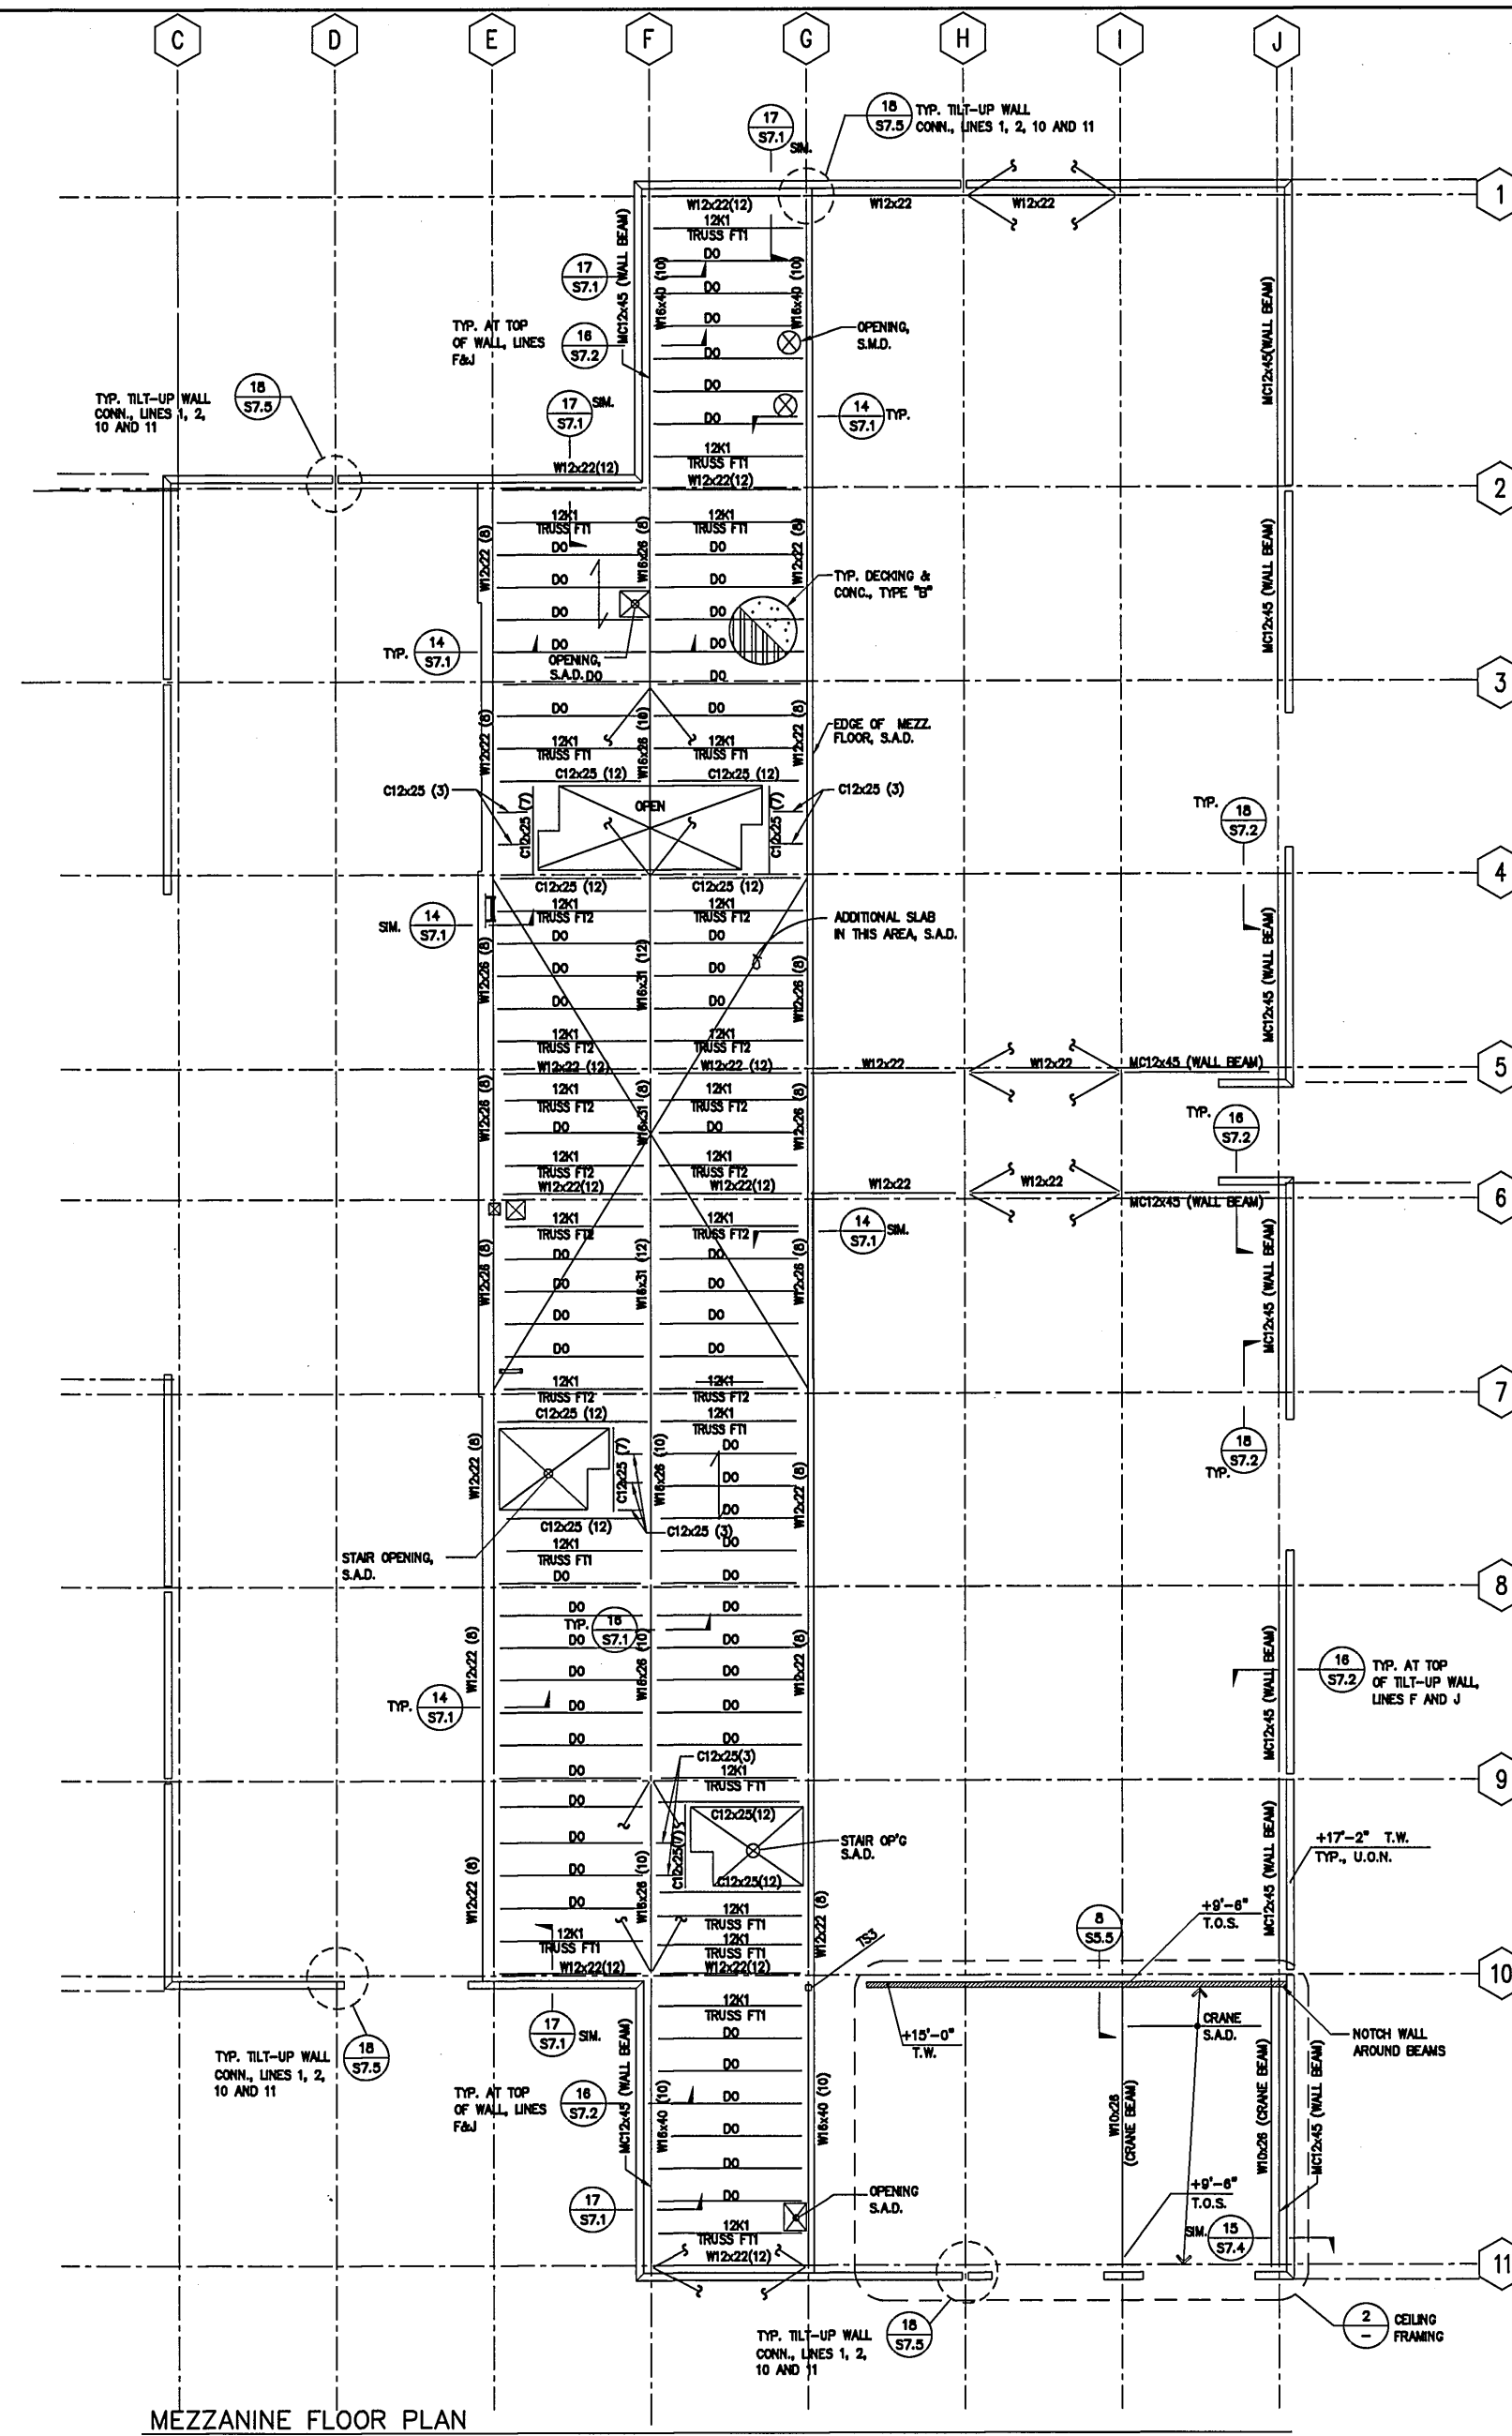


MEZZANINE FLOOR PLAN

1/8"=1'-0"

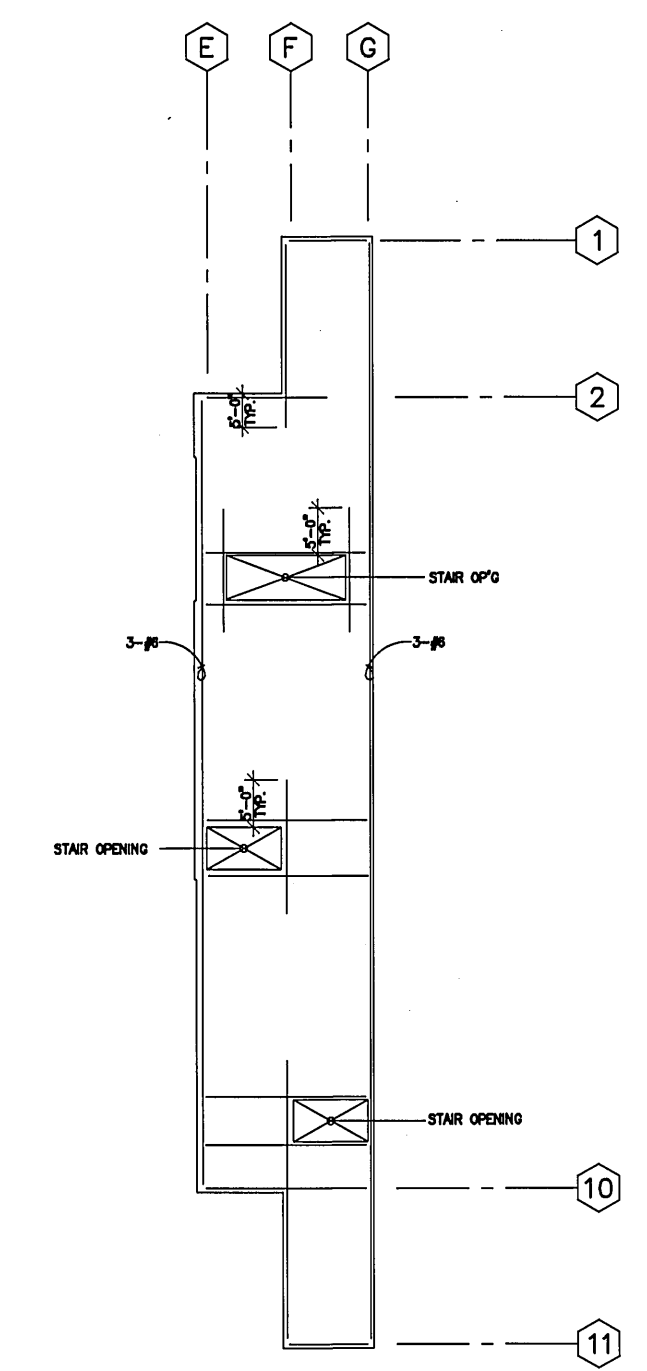

- NOTES:
- ALL REIN. BARS SHOWN ARE 2-#5, U.O.N.
 - ALL BARS SHALL BE LOCATED IN THE MIDDLE OF THE SLAB.

1 MEZZANINE FLOOR-ADDED REINFORCING PLAN N.T.S.

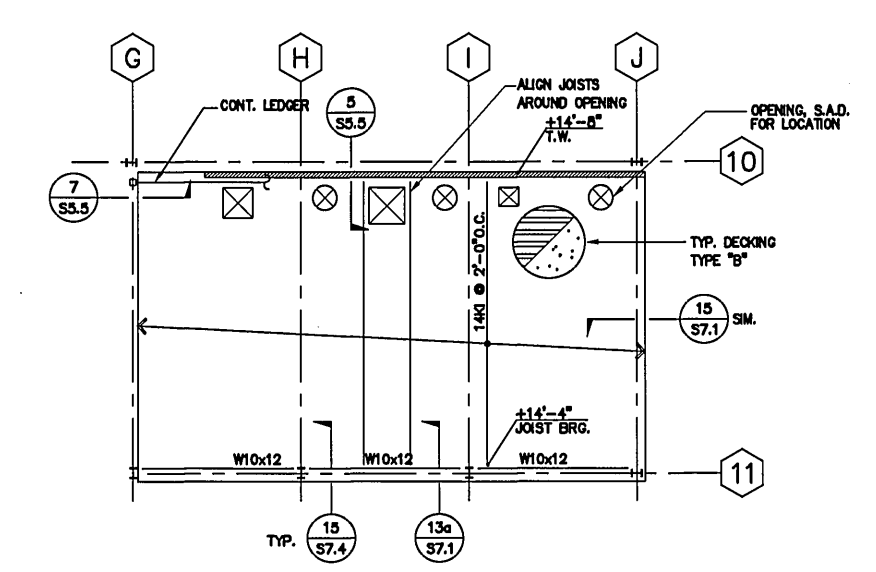

2 CEILING FRAMING AT WELDING AND PAINT SHOPS 1/8"=1'-0"

- MEZZANINE FRAMING NOTES
- SEE GENERAL NOTES AND TYPICAL DETAILS ON SHEET S1.1, S7.1 AND S7.2.
 - ELEVATION TO TOP OF CONCRETE (T.O.C.) IS GIVEN WITH RESPECT TO NOMINAL FIRST FLOOR ELEVATION +0'-0" AND SHOWN THUS: +11'-8".
 - THE TOPS OF THE STEEL JOISTS OCCUR BELOW THE TYPICAL TOP OF CONCRETE DECK. THE TOPS OF STEEL BEAMS OCCUR IMMEDIATELY BELOW THE STEEL JOISTS, UNLESS OTHERWISE NOTED. ELEVATIONS TO TOP OF STEEL (T.O.S.), WHERE GIVEN, ARE WITH RESPECT TO NOMINAL FIRST FLOOR ELEVATION +0'-0" AND SHOWN THUS: T.O.S. EL. +10'-11", U.O.N..
 - STEEL DECK DIRECTION IS DENOTED THUS: AND IS PERPENDICULAR TO SUPPORTING FRAMING MEMBERS. SEE DETAIL 3/S2.1 FOR DECK PROPERTIES AND WELDING.
 - STEEL JOISTS SHALL BE EQUALLY SPACED IN BAYS U.O.N.
 - SEE DRAWINGS OTHER THAN STRUCTURAL FOR DEPRESSIONS, CURBS, MECHANICAL, ELECTRICAL, AND SHAFT OPENINGS, ETC.
 - MARKS (12) ETC. DENOTE NUMBER OF SHEAR STUDS AT TOP FLANGE OF THE STEEL BEAM OR GIRDER. SEE NOTES AND DETAILS SHEET S7.1.
 - MARKS "FT1" ETC. INDICATE STEEL BAR JOISTS. SEE JOIST SCHEDULE ON SHEET S7.2.
 - FOR ADDITIONAL REINFORCING BARS (CHORD BARS) AT SLAB, SEE DETAIL 1/S2.2.
 - FOR STEEL JOIST NOTES AND LOADING CRITERIA, SEE 3/S2.2.
 - MARKS "DO" APPLY TO BEAM/JOIST SIZES, ELEVATIONS AND CONNECTIONS, U.O.N.



100% SUBMITTAL


IF THIS SHEET IS LESS THAN 30" X 42", IT IS A REDUCED PRINT SCALE ACCORDINGLY

EAST BAY MUNICIPAL UTILITY DISTRICT
SPECIAL DISTRICT No. 1
OAKLAND, CALIFORNIA

MAINTENANCE FACILITY SD 223
WASTE WATER TREATMENT PLANT
TRA PROJECT NO. 98007.02

MEZZANINE FRAMING PLAN

FACILITY	DRAWING No.
SCALE AS NOTED	822
DATE 23 MAR. 1998	SHEET
	OF
	SPECIFICATION NO.

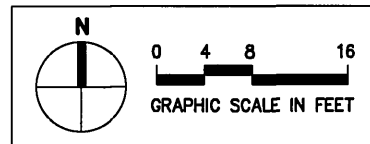


DASSE DESIGN INC.
STRUCTURAL ENGINEERS
25 West Montgomery Ave., Suite 200
Oakland, CA 94612-1000
415/433-0000 - Fax 415/433-0000


The Ratcliff Architects
ARCHITECTS
1000 SHAW BLVD.
OAKLAND, CA 94612
(415) 882-1010

DESIGNED BY	JUV
DESIGN CHECKED BY	JUV
DRAWN BY	HTC
IN CHARGE	JUV
APPROVED	
DATE	3/20/98
REVISION	
BY	REL
APP.	REL
PRINCIPAL-IN-CHARGE, R.P.E. No. 0	

PROJECT NO.	SD 223A
R.P.E. No.	
PROJECT SUPERVISOR	
R.P.E. No.	

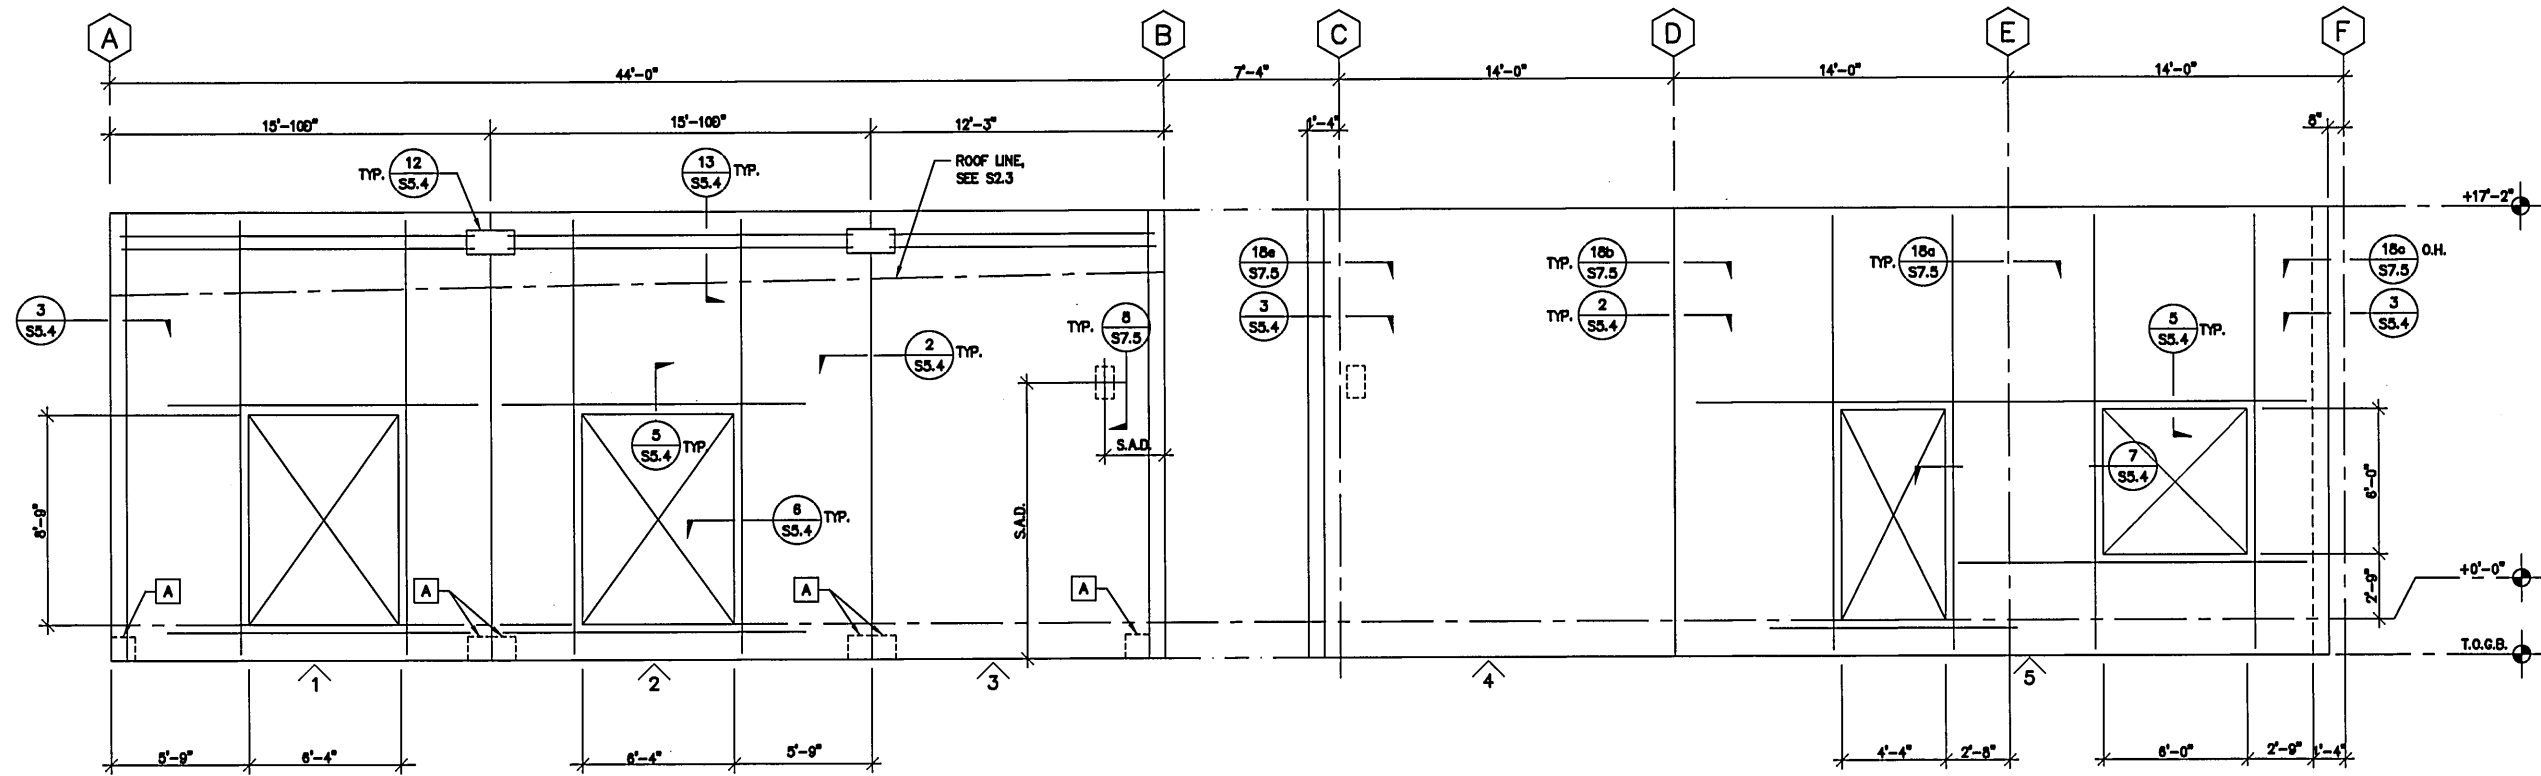


1 ELEVATION AT LINE 1.9

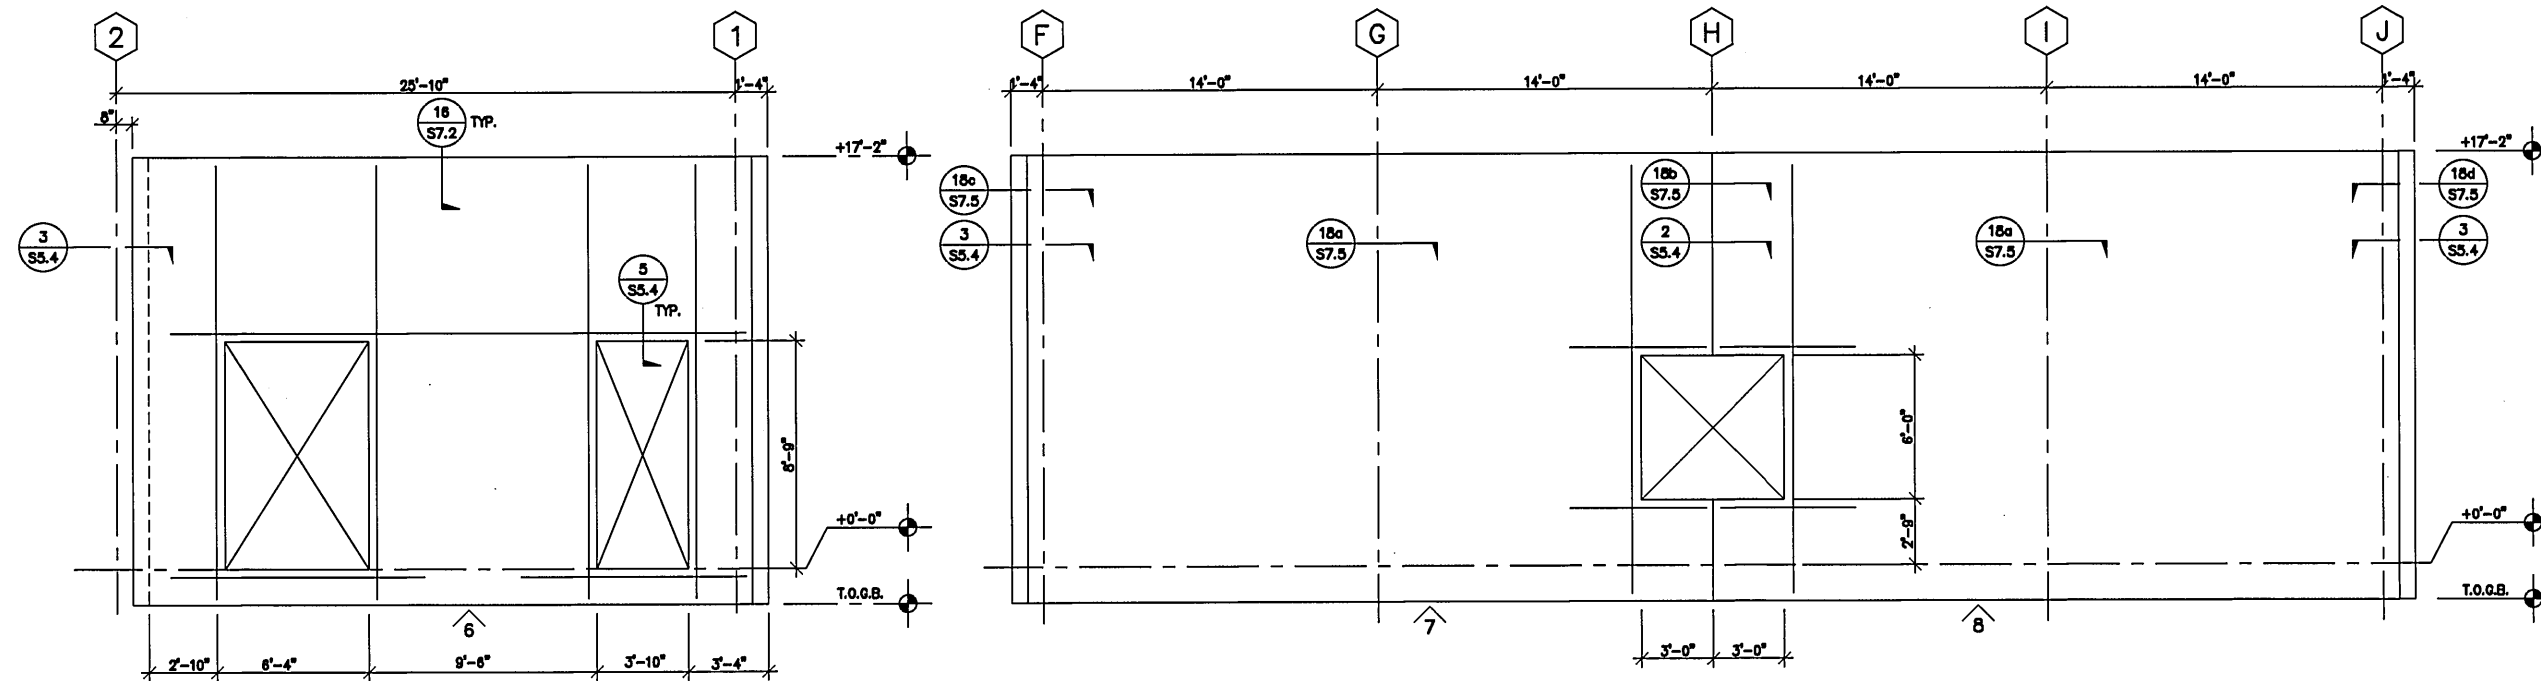


2 ELEVATION AT LINE F

3 ELEVATION AT LINE 1

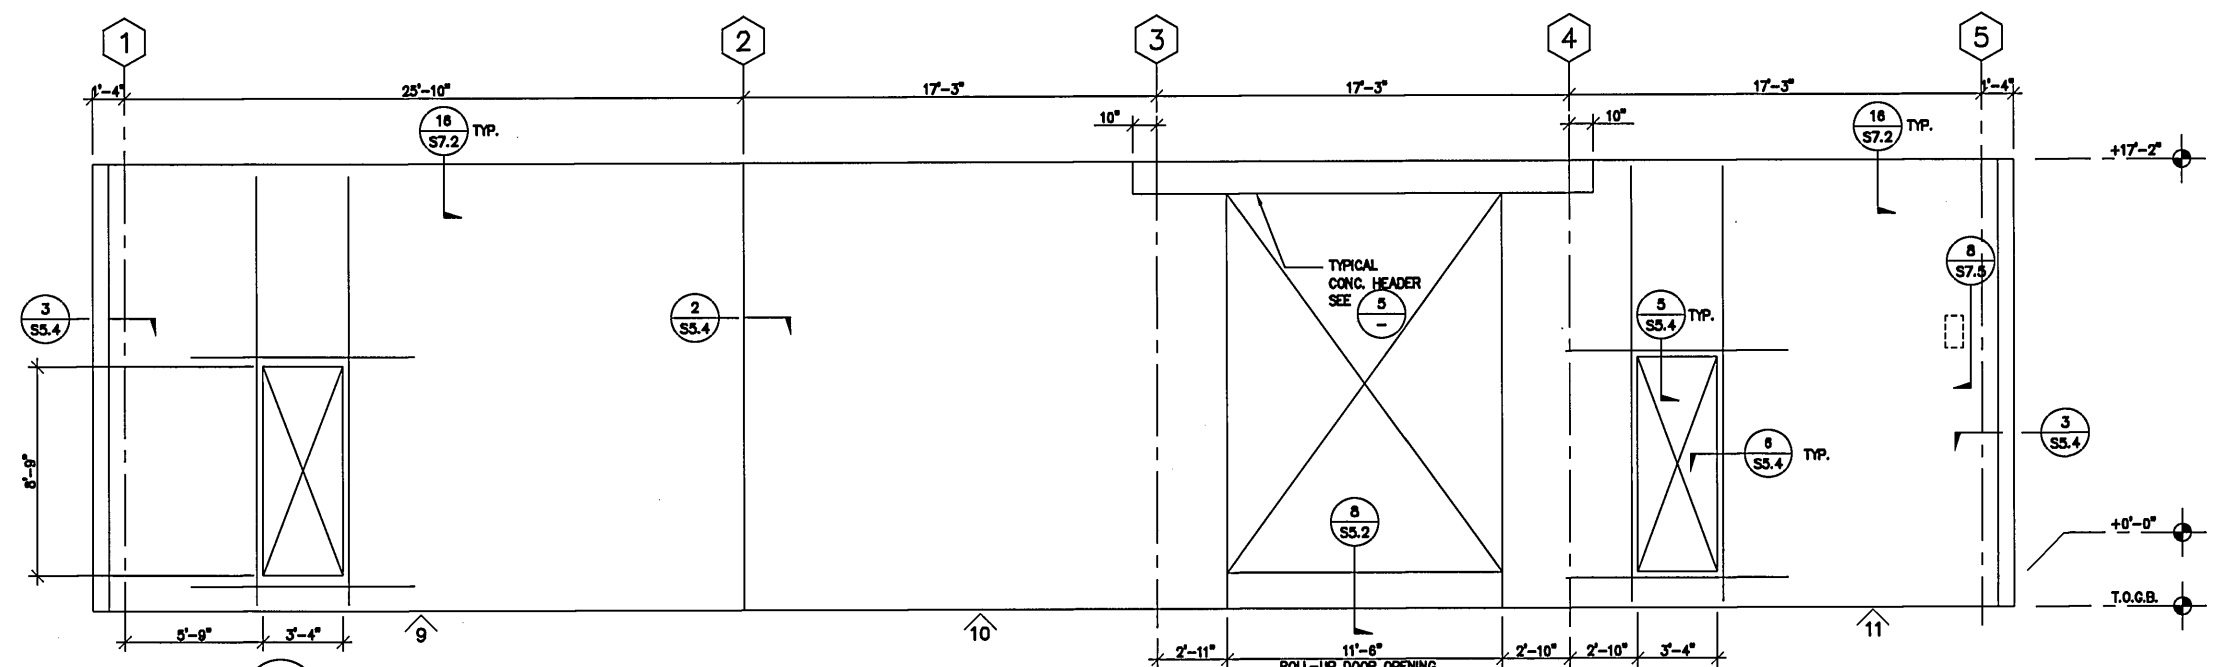

4 ELEVATION AT LINE J

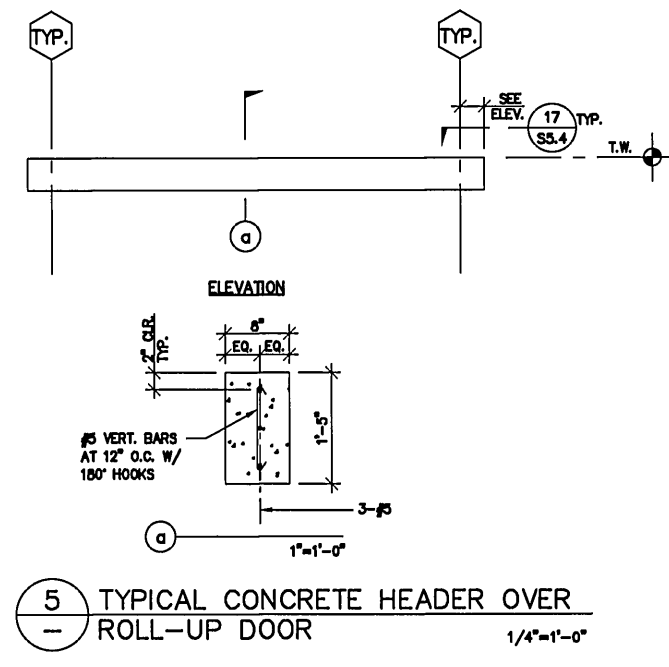

5 TYPICAL CONCRETE HEADER OVER ROLL-UP DOOR

- PRECAST PANEL NOTES**
- SEE GENERAL NOTES ON SHEET S1.1.
 - ⌘ DENOTES PANEL DESIGNATION "X"; SEE FOUNDATION PLANS FOR PANEL LOCATION.
 - ALL REINFORCEMENT SHOWN IN PANEL ELEVATIONS IS IN ADDITION TO TYPICAL PANEL REINFORCEMENT, USE 2-#5 U.O.N.
 - ALL PANELS ARE VIEWED FROM INSIDE OF BUILDING. PANELS ARE CAST OUTSIDE FACE DOWN.
 - ALL VERTICAL PANEL EDGES SHALL HAVE 2-#5 TRIM BARS PER DETAIL 2/SS.4 U.O.N.
 - PROVIDE (1) #5 X 5'-0" DIAGONAL REINFORCING BARS AT ALL CORNERS OF ALL OPENINGS PER DETAIL 4/SS.4.
 - PROVIDE PANEL CHORD BARS PER DETAIL 12/SS.4. DO NOT CONNECT PANELS AT CHORD CONNECTIONS UNTIL 28 DAYS AFTER CONCRETE IS CAST.
 - SEE DETAIL 4/SS.2 FOR TYPICAL PANEL DETAILS.
 - SEE DETAIL 1/SS.4 FOR TYPICAL PANEL REINFORCEMENT PLACEMENT.
 - SEE ROOF FRAMING PLAN FOR ROOF FRAMING TO PRECAST PANEL CONNECTION DETAILS.
 - PANEL DIMENSIONS ON ELEVATIONS ARE NOMINAL. PROVIDE 3/4" GAP BETWEEN ADJACENT PANELS UNLESS OTHERWISE NOTED.
 - ARCHITECTURAL FEATURES SUCH AS REVEALS, SCUPPERS, AND MECHANICAL FEATURES, SUCH AS EXHAUST DUCTS, ETC. ARE NOT SHOWN ON STRUCTURAL ELEVATIONS. REFER TO OTHER DRAWINGS FOR COMPLETE INFORMATION.
 - IN ADDITION TO REINFORCEMENT SHOWN AND NOTED, THE CONTRACTOR SHALL PROVIDE ADDITIONAL REINFORCEMENT, ANCHORAGES, INSERTS, LIFTING DEVICES AND ALL OTHER MATERIALS NECESSARY FOR PANEL ERECTION.
 - DESIGN CALCULATIONS FOR PANEL ERECTION SHALL BE PREPARED BY A LICENSED CALIFORNIA STRUCTURAL ENGINEER AND SUBMITTED TO THE DISTRICT FOR REVIEW PRIOR TO PANEL FABRICATION. THE CONTRACTOR IS RESPONSIBLE FOR THE DESIGN OF WALL PANELS FOR ERECTION.
 - SUBMIT SHOP DRAWINGS AND CALCULATIONS TO THE DISTRICT FOR REVIEW PRIOR TO PANEL FABRICATION. SHOP DRAWINGS SHALL SHOW PENETRATION REQUIREMENTS OF ALL TRADES, ALL REINFORCING, ANCHORAGES, INSERTS, LIFTING DEVICES AND ALL OTHER FEATURES NECESSARY FOR ERECTION. ALL SHOP DRAWINGS AND CALCULATIONS SHALL BE STAMPED AND SIGNED BY THE ENGINEER.
 - SIZES AND LOCATIONS OF WALL OPENINGS AND PENETRATIONS ARE PROVIDED ON THE STRUCTURAL DRAWINGS FOR INFORMATION ONLY AND ARE NOT COMPLETE AS TO SIZE, NUMBER AND LOCATION. THE CONTRACTOR SHALL COORDINATE THE OPENINGS AND PENETRATIONS REQUIRED OF ALL TRADES AND SHALL VERIFY ALL DIMENSIONS WITH ARCHITECTURAL, MECHANICAL, ELECTRICAL AND PLUMBING DRAWINGS.
 - THE CONTRACTOR SHALL PROVIDE BRACES AND CONNECTIONS TO SAFELY SUPPORT THE PANELS UNTIL THE STRUCTURE, INCLUDING THE ROOF DIAPHRAGM, IS ADEQUATELY SELF SUPPORTED FOR ALL LOADINGS.
 - AVOID PLACEMENT OF PANEL JOINTS OVER CONTROL JOINTS AND COLUMN BLOCKOUTS.
 - ALL DIMEDS, PLATES, TUBES, ETC. WHICH WILL BE EXPOSED TO WEATHER SHALL BE HOT-DIPPED GALVANIZED.
 - BOND BREAKING AGENT SHALL BE "BURKE SUPER BOND BREAKER" OR EQUAL PRODUCT SUBSTITUTED PER SPEC SECTION 01340. BOND BREAKER SHALL NOT RESTRICT THE PLACEMENT OF FINISH MATERIALS OR PAINT ON TREATED SURFACES.
 - FILL IN ALL PITS, HOLES AND POCKETS WITH GROUT AND RUN SMOOTH WITH BURLAP TO REMOVE ALL FINS AND RIDGES.
 - USE PLASTIC TIPPED CHAIRS FOR SUPPORT OF REINFORCING.
 - "A" INDICATES PANEL HOLD-DOWN, SEE 2/SS.2.

PRECAST PANEL NOTES



100% SUBMITTAL

IF THIS SHEET IS LESS THAN 30" X 42", IT IS A REDUCED PRINT SCALE ACCORDINGLY

EAST BAY MUNICIPAL UTILITY DISTRICT
SPECIAL DISTRICT No. 1
OAKLAND, CALIFORNIA


MAINTENANCE FACILITY SD 223
WASTE WATER TREATMENT PLANT
TRA PROJECT NO. 96007.02

PANEL ELEVATIONS

DATE	23 MAR 1998	DRAWING No.	831
SHEET	23	SHEET	OF

SPECIFICATION NO.

FILE: F:\0816502\Draw\0816502.DWG 02/09/98 at 22:00
XREF: ...16502-1B1.DWG

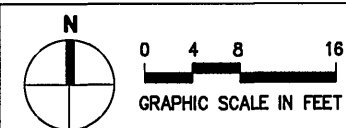



DASSE DESIGN INC.
STRUCTURAL ENGINEERS
3333 International Blvd., Suite 200
Oakland, CA 94612-1070
(415) 555-1070

The Ratcliff Architects
ARCHITECTS
1000 BAY STREET
OAKLAND, CA 94612
(415) 555-1070

DESIGNED BY	JOW	PROJECT MGR.	R.P.E. No.
DESIGN CHECKED BY	JOW		
DRAWN BY	MTD		
SR. PROJ. ENGR.	JOW		
APPROVED	J.L.V.		
DATE	02/09/98	REVISION	BY
NO.	1	DATE	02/09/98

PROJECT SUPERVISOR	R.P.E. No.
DATE	23 MAR 1998



REF: 61651-TB1.DWG

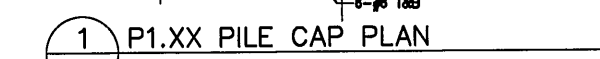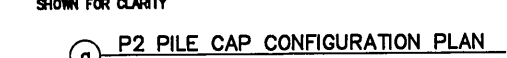


- 19 GRADE BEAM SCHEDULE




10 GRADE BEAM REINFORCEMENT

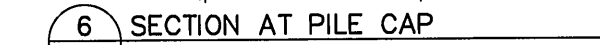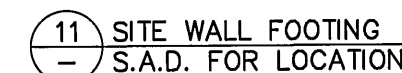

6 SECTION AT PILE CAP

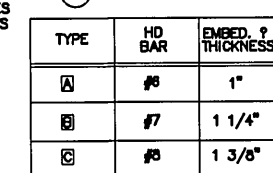

7 PANEL HOLD-DOWN DETAIL

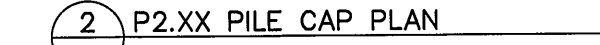


2 P2.XX PILE CAP PLAN




3 PRECAST PRESTRESSED PILE



8 FOOTING AT PANEL OPENING

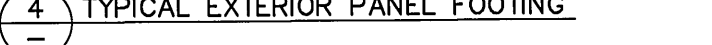

4 TYPICAL EXTERIOR PANEL FOOTING

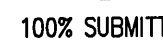


**EAST BAY MUNICIPAL UTILITY DISTRICT
SPECIAL DISTRICT No. 1
OAKLAND, CALIFORNIA**

FOOTING DETAILS


FOOTING DETAIL

DATE 23 MAR. 1998	SHEET 1
SPECIFICATION NO.	


[illegible]

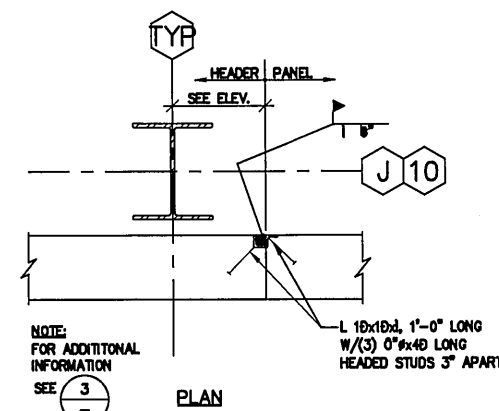


17 HEADER TO PANEL CONNECTION

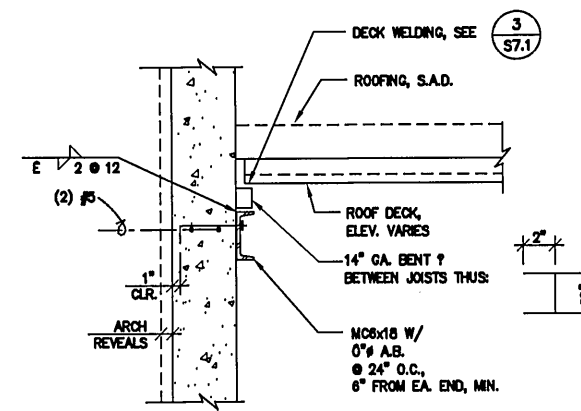


13 STEEL DECK TO WALL CONNECTION

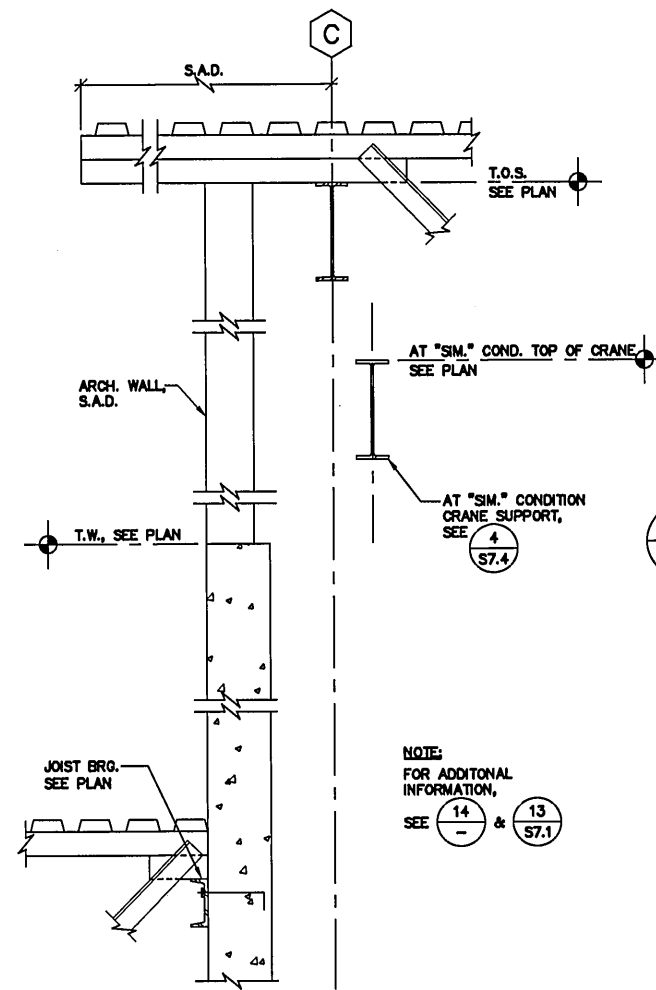


5 HEAD DETAIL

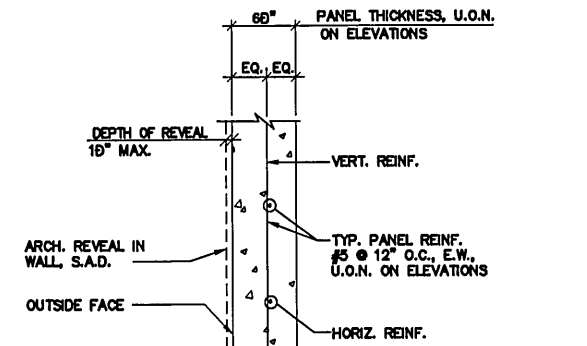


1 TYPICAL PANEL REINFORCING

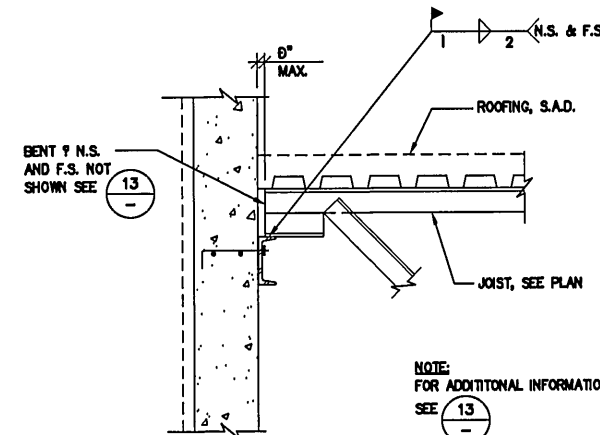


13 JOIST TO WALL CONNECTION

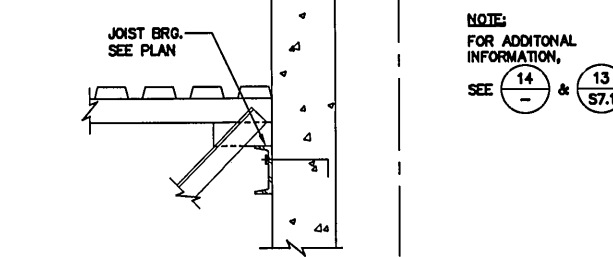


10 JAMB DETAIL

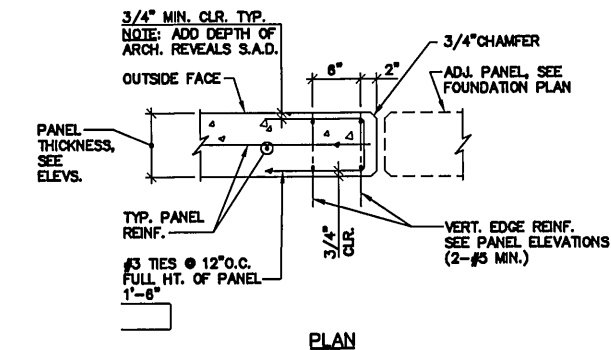


2 TYPICAL PANEL EDGE

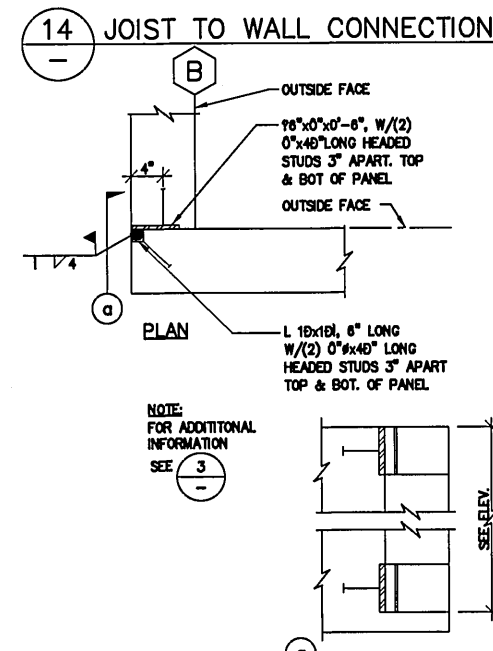


14 JOIST TO WALL CONNECTION

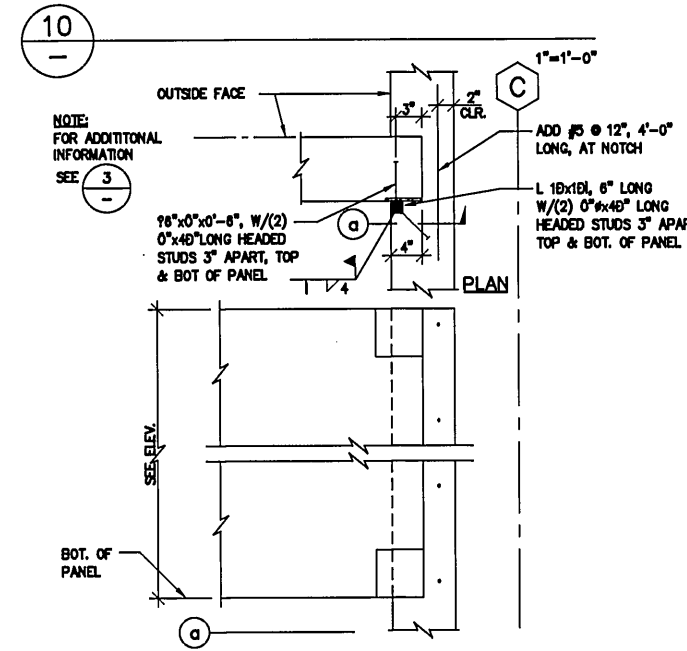


12 PANEL CONNECTION OVER DOOR

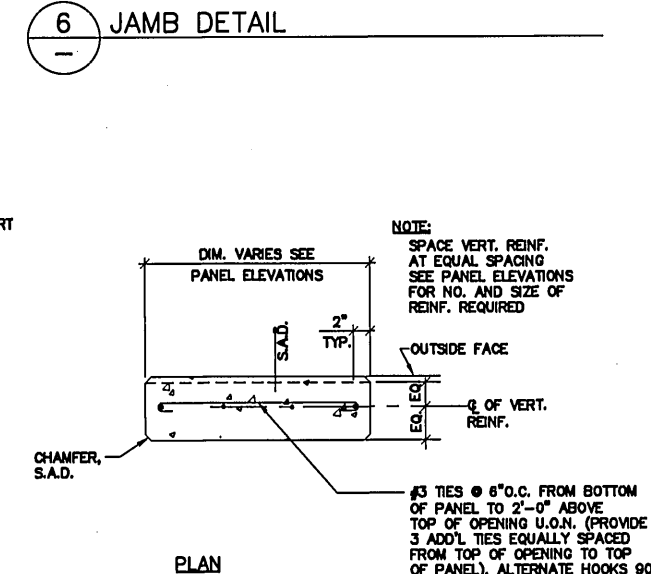


6 JAMB DETAIL

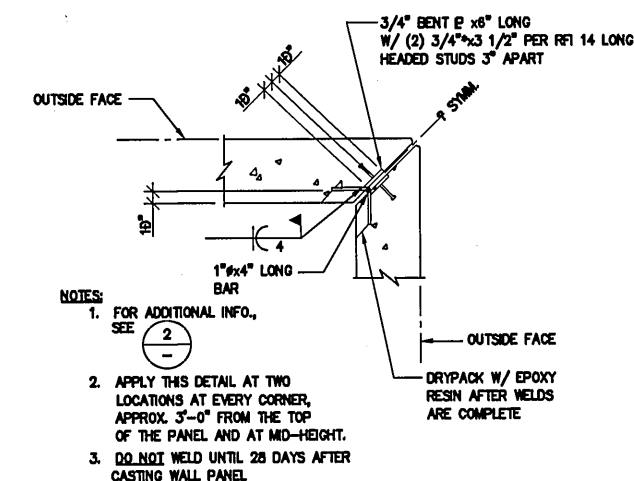


3 PLAN AT MITERED CORNER

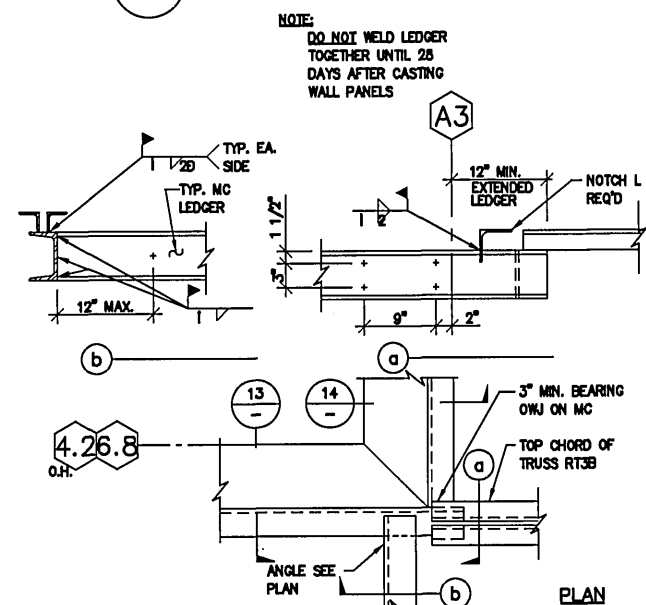

16 RE-ENTRY CORNER TIE

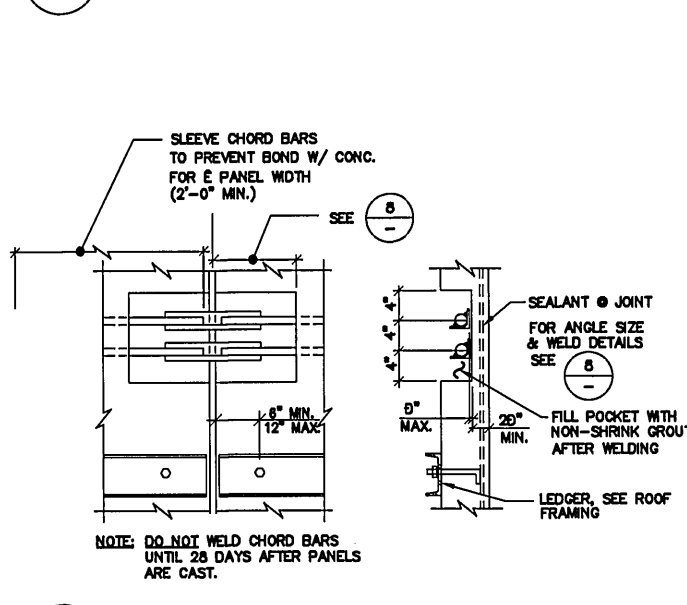


12 TOP CHORD BAR SPLICE

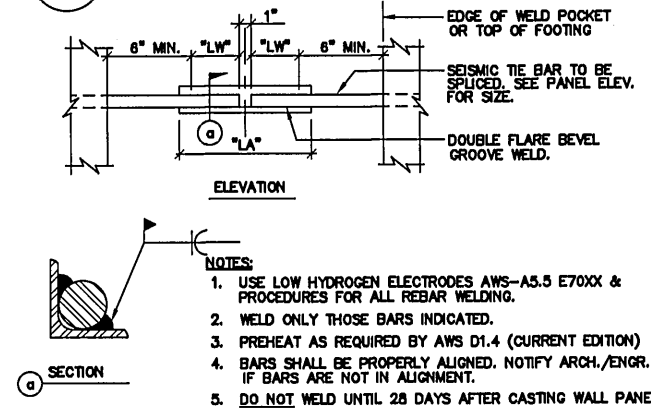

SCHEDULE

BAR SIZE	ANGLE SIZE	LENGTH OF WELD	LENGTH OF ANGLE
#5	1 1/2\" x 1 1/2\"	4"	1 1/2"
#7	2\" x 2"	4"	1 1/2"
#8	2\" x 2"	6"	1 1/2"

7 WELDED BAR SPLICE DETAIL

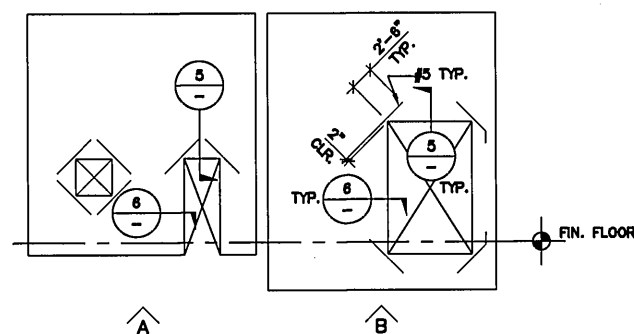

4 OPENING REINFORCEMENT DETAIL



100% SUBMITTAL


IF THIS SHEET IS LESS THAN 30" X 42", IT IS A REDUCED PRINT SCALE ACCORDINGLY

EAST BAY MUNICIPAL UTILITY DISTRICT
SPECIAL DISTRICT No. 1
OAKLAND, CALIFORNIA

MAINTENANCE FACILITY SD 223
WASTE WATER TREATMENT PLANT
TRA PROJECT NO. 96007.02


WALL DETAILS

FACILITY
SCALE NONE
DATE 23 MAR. 1998
DRAWING No. **S54**
SHEET OF
SPECIFICATION NO.

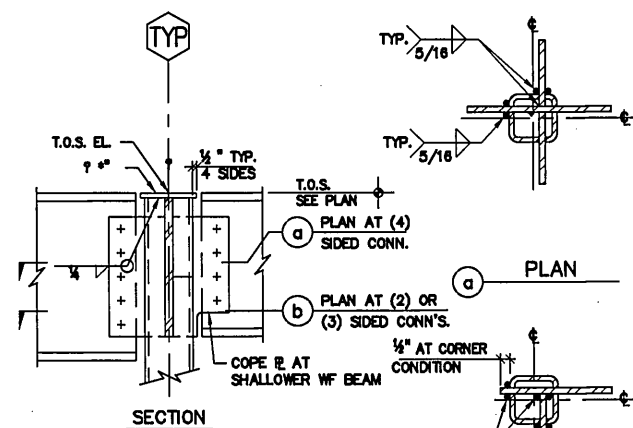


- NOTES:
- SEE 11 FOR DETAILS & DIMENSIONS NOT SHOWN.
 - SLOT TS FOR KNIFE PLATES NOT SHOWN.


17 BEAM TO TS COLUMN CONNECTION

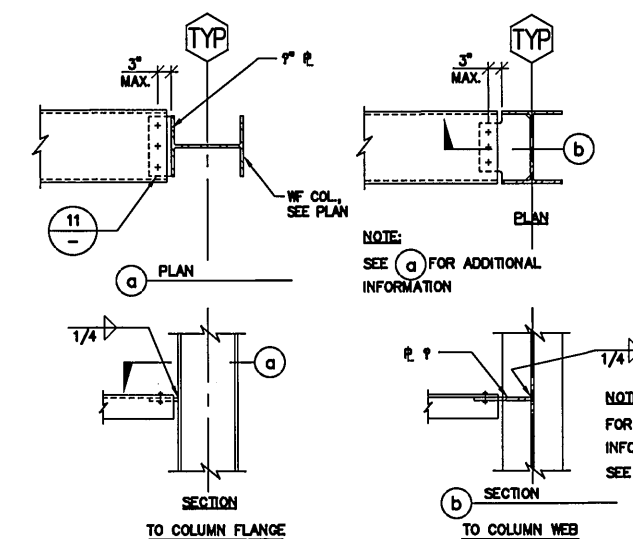

18 FLAT CHANNEL TO WF COLUMN
3/4"=1'-0"

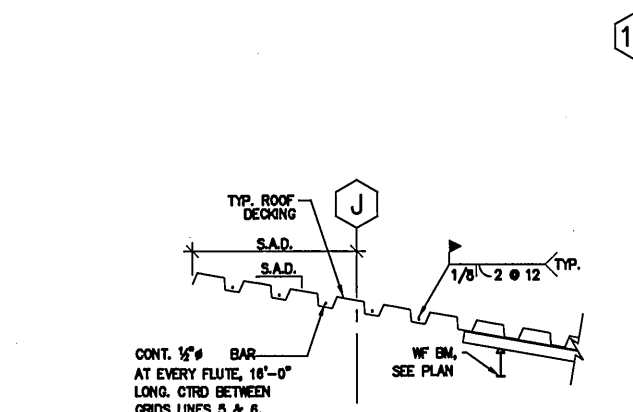


19 3/4"=1'-0"

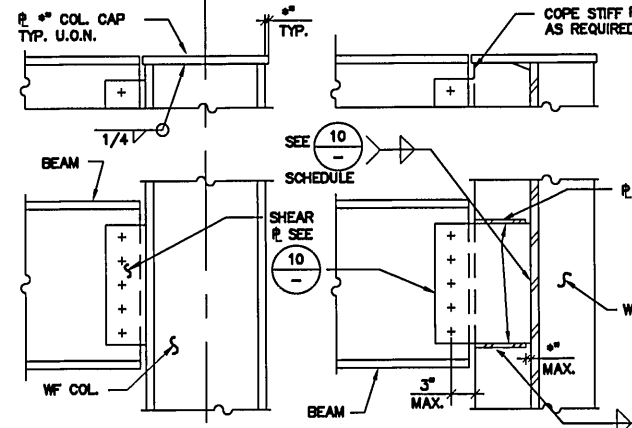


- NOTES:
- SEE 11 FOR DETAILS & DIMENSIONS NOT SHOWN.
 - SLOT TS FOR KNIFE PLATES NOT SHOWN.


13 BEAM TO COLUMN CONNECTION

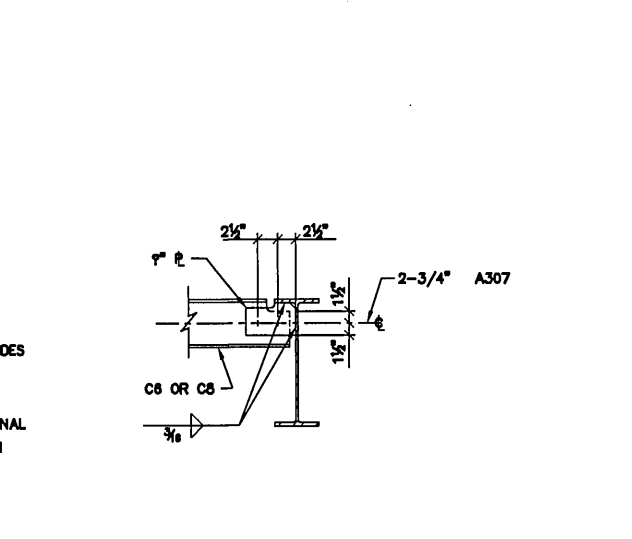


14 CHANNEL CONNECTION AT WF BEAM

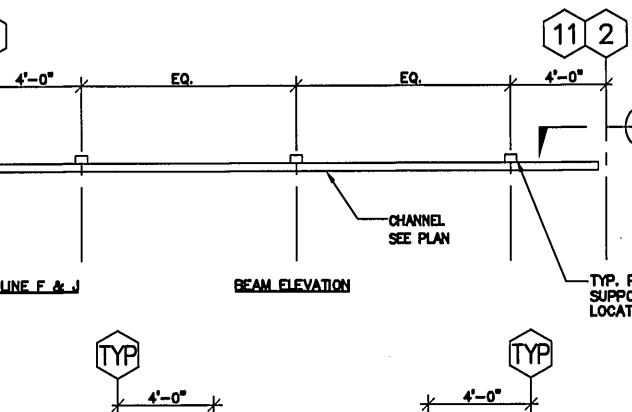


15 3/4"=1'-0"

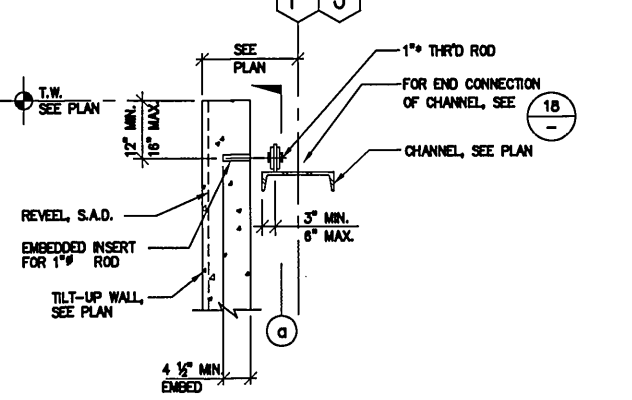

16 3/4"=1'-0"

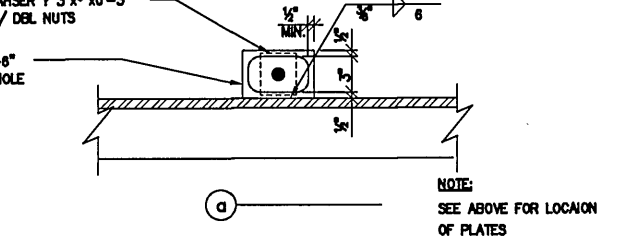

17 3/4"=1'-0"

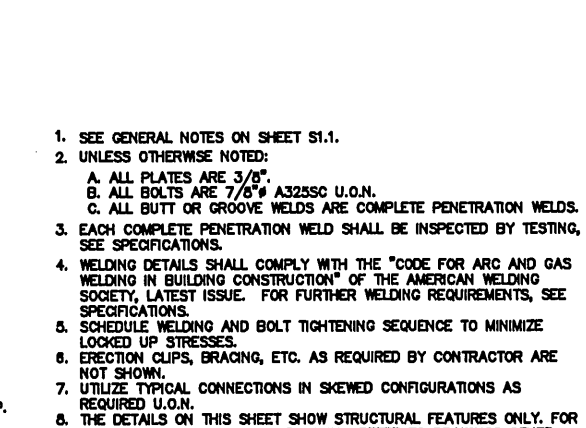


- NOTES:
- SEE GENERAL NOTES ON SHEET 11.1.
 - UNLESS OTHERWISE NOTED:
 - A. ALL PLATES ARE 3/8"
 - B. ALL BOLTS ARE 7/8" A325SSC U.O.N.
 - C. ALL BUTT OR GROOVE WELDS ARE COMPLETE PENETRATION WELDS. SEE SPECIFICATIONS.
 - D. WELDING DETAILS SHALL COMPLY WITH THE "CODE FOR ARC AND GAS WELDING IN BUILDING CONSTRUCTION" OF THE AMERICAN WELDING SOCIETY, LATEST ISSUE. FOR FURTHER WELDING REQUIREMENTS, SEE SPECIFICATIONS.
 - E. SCHEDULE WELDING AND BOLT TIGHTENING SEQUENCE TO MINIMIZE LOOKED UP STRESSES.
 - F. ERECTION CLIPS, BRACING, ETC. AS REQUIRED BY CONTRACTOR ARE NOT SHOWN.
 - G. UTILIZE TYPICAL CONNECTIONS IN SKEWED CONFIGURATIONS AS REQUIRED U.O.N.
 - H. THE DETAILS ON THIS SHEET SHOW STRUCTURAL FEATURES ONLY. FOR DETAILS AND DIMENSIONS NOT SHOWN, REFER TO DRAWINGS OTHER THAN STRUCTURAL.

9 STRUCTURAL STEEL NOTES


DEPTH OR SIZE OF BEAM	NO. OF BOLTS (2)	SHEAR PLATE	WELD (1) SIZE
6" x 8" 10" CS, MC8	2 (3)	1/2"	1/4"
12" x 14" C12, MC12	3	3/4"	3/8"
18" x 24" C18, MC18	4	1"	1/2"
24" x 36" C24, MC24	6	1 1/2"	3/4"

- NOTES:
- USE COMPLETE PENETRATION WELDS AT ALL SKEWED CONNECTIONS WHERE ALSO PRE-QUALIFIED FILLET WELDS ARE NOT POSSIBLE
 - USE 1" A325SSC BOLT WHERE DENOTED ON FRAMING PLANS THUS:
 - USE 3/4" A325SSC BOLT AT WF&B BEAMS


10 BEAM CONNECTION SCHEDULE

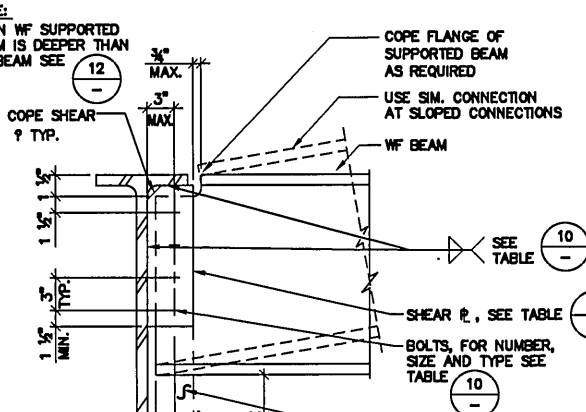

11 BEAM TO BEAM CONNECTION

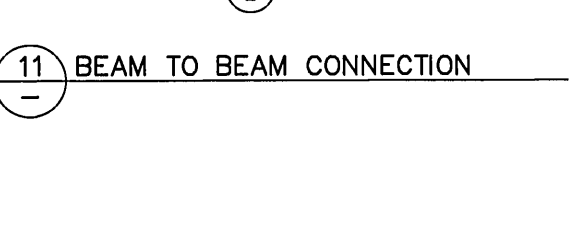

12 BEAM TO SHALLOWER BEAM CONNECTION

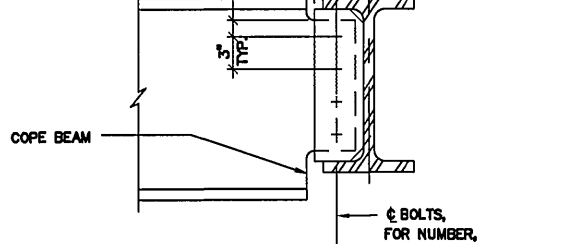


13 3/4"=1'-0"

14 3/4"=1'-0"

15 3/4"=1'-0"


16 3/4"=1'-0"

17 3/4"=1'-0"

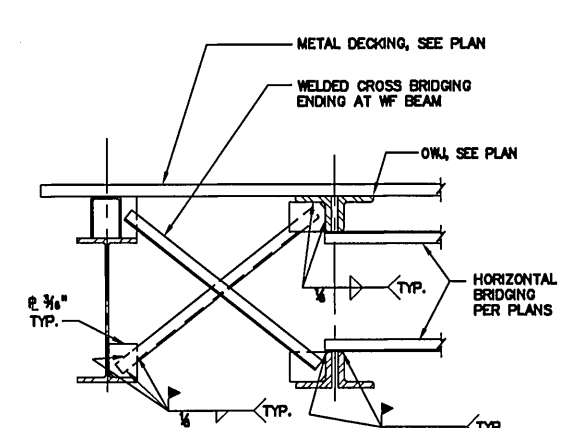


- NOTES:
- SEE GENERAL NOTES ON SHEET 11.1.
 - UNLESS OTHERWISE NOTED:
 - A. ALL PLATES ARE 3/8"
 - B. ALL BOLTS ARE 7/8" A325SSC U.O.N.
 - C. ALL BUTT OR GROOVE WELDS ARE COMPLETE PENETRATION WELDS. SEE SPECIFICATIONS.
 - D. WELDING DETAILS SHALL COMPLY WITH THE "CODE FOR ARC AND GAS WELDING IN BUILDING CONSTRUCTION" OF THE AMERICAN WELDING SOCIETY, LATEST ISSUE. FOR FURTHER WELDING REQUIREMENTS, SEE SPECIFICATIONS.
 - E. SCHEDULE WELDING AND BOLT TIGHTENING SEQUENCE TO MINIMIZE LOOKED UP STRESSES.
 - F. ERECTION CLIPS, BRACING, ETC. AS REQUIRED BY CONTRACTOR ARE NOT SHOWN.
 - G. UTILIZE TYPICAL CONNECTIONS IN SKEWED CONFIGURATIONS AS REQUIRED U.O.N.
 - H. THE DETAILS ON THIS SHEET SHOW STRUCTURAL FEATURES ONLY. FOR DETAILS AND DIMENSIONS NOT SHOWN, REFER TO DRAWINGS OTHER THAN STRUCTURAL.


5 OWJ BRIDGING CONNECTION

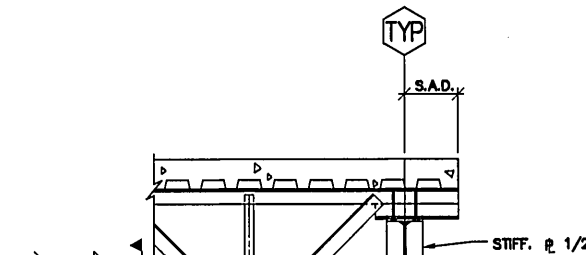


6 BEAM BRACE TO JOIST

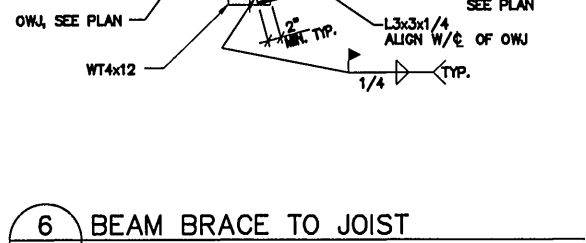


7 JOIST TO WF BEAM CONNECTION AT FLOOR

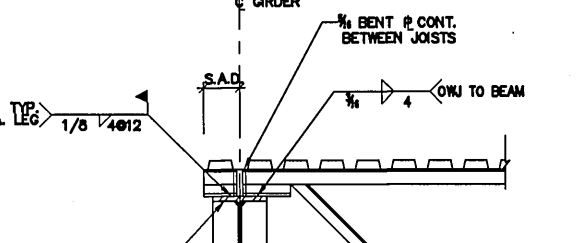


8 FLOOR JOIST BRIDGING

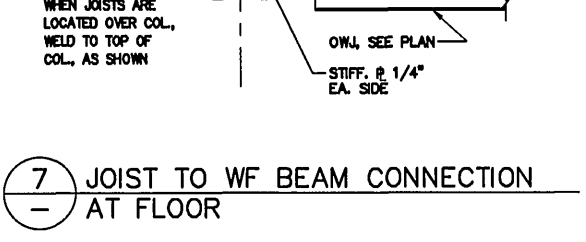

9 3/4"=1'-0"

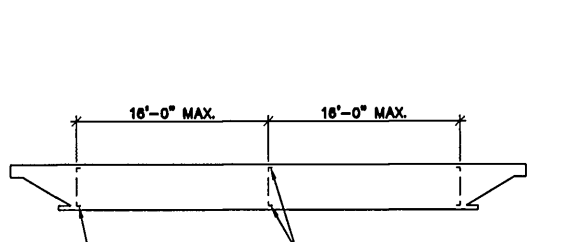


10 3/4"=1'-0"

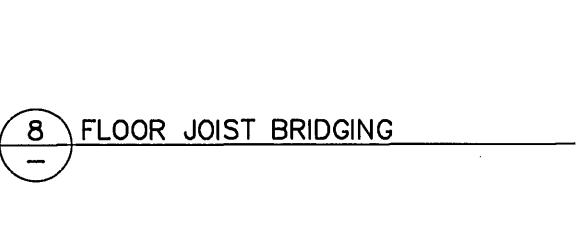

11 3/4"=1'-0"


12 3/4"=1'-0"

13 3/4"=1'-0"

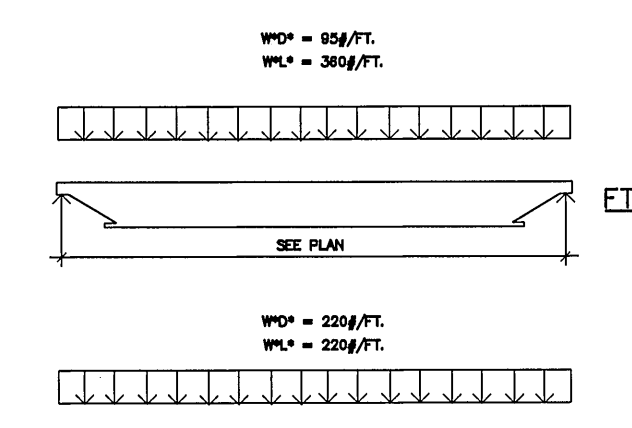


- NOTES:
- SEE GENERAL NOTES ON SHEET 11.1.
 - UNLESS OTHERWISE NOTED:
 - A. ALL PLATES ARE 3/8"
 - B. ALL BOLTS ARE 7/8" A325SSC U.O.N.
 - C. ALL BUTT OR GROOVE WELDS ARE COMPLETE PENETRATION WELDS. SEE SPECIFICATIONS.
 - D. WELDING DETAILS SHALL COMPLY WITH THE "CODE FOR ARC AND GAS WELDING IN BUILDING CONSTRUCTION" OF THE AMERICAN WELDING SOCIETY, LATEST ISSUE. FOR FURTHER WELDING REQUIREMENTS, SEE SPECIFICATIONS.
 - E. SCHEDULE WELDING AND BOLT TIGHTENING SEQUENCE TO MINIMIZE LOOKED UP STRESSES.
 - F. ERECTION CLIPS, BRACING, ETC. AS REQUIRED BY CONTRACTOR ARE NOT SHOWN.
 - G. UTILIZE TYPICAL CONNECTIONS IN SKEWED CONFIGURATIONS AS REQUIRED U.O.N.
 - H. THE DETAILS ON THIS SHEET SHOW STRUCTURAL FEATURES ONLY. FOR DETAILS AND DIMENSIONS NOT SHOWN, REFER TO DRAWINGS OTHER THAN STRUCTURAL.


14 STEEL JOIST NOTES AND LOADING CRITERIA

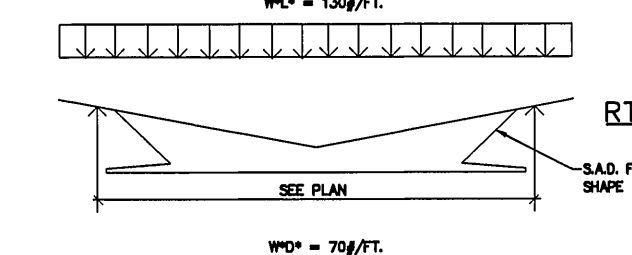


15 3/4"=1'-0"

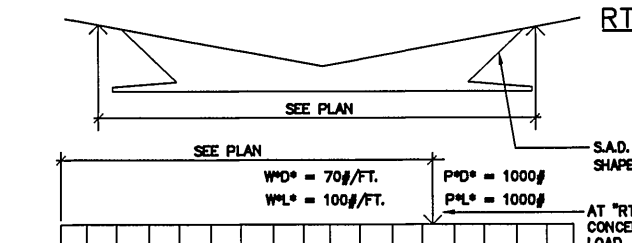


16 3/4"=1'-0"

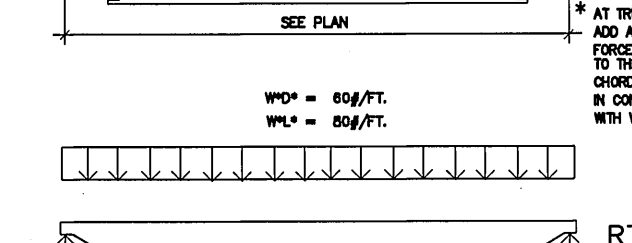


17 3/4"=1'-0"

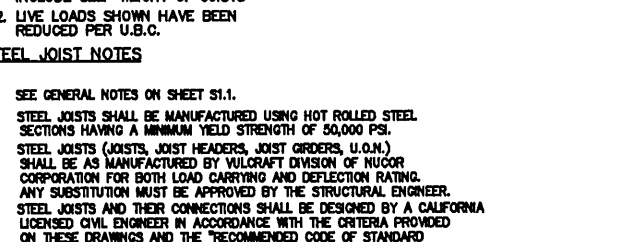

18 3/4"=1'-0"

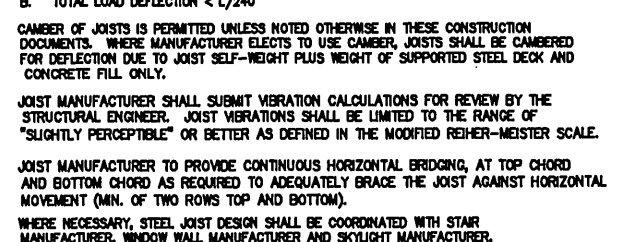


19 3/4"=1'-0"

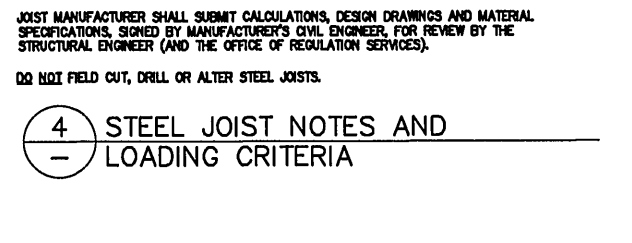

20 3/4"=1'-0"

21 3/4"=1'-0"

22 3/4"=1'-0"

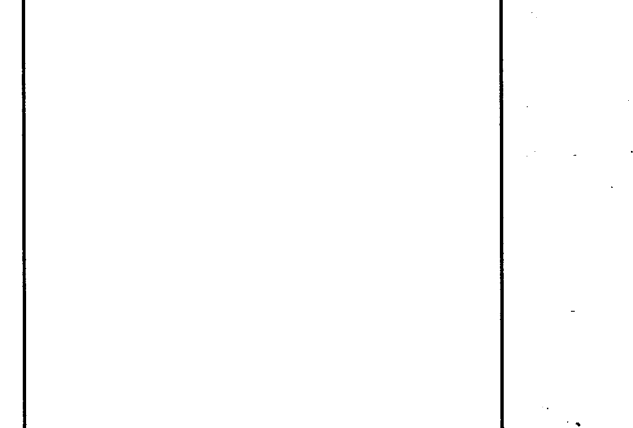

- NOTES:
- SEE GENERAL NOTES ON SHEET 11.1.
 - UNLESS OTHERWISE NOTED:
 - A. ALL PLATES ARE 3/8"
 - B. ALL BOLTS ARE 7/8" A325SSC U.O.N.
 - C. ALL BUTT OR GROOVE WELDS ARE COMPLETE PENETRATION WELDS. SEE SPECIFICATIONS.
 - D. WELDING DETAILS SHALL COMPLY WITH THE "CODE FOR ARC AND GAS WELDING IN BUILDING CONSTRUCTION" OF THE AMERICAN WELDING SOCIETY, LATEST ISSUE. FOR FURTHER WELDING REQUIREMENTS, SEE SPECIFICATIONS.
 - E. SCHEDULE WELDING AND BOLT TIGHTENING SEQUENCE TO MINIMIZE LOOKED UP STRESSES.
 - F. ERECTION CLIPS, BRACING, ETC. AS REQUIRED BY CONTRACTOR ARE NOT SHOWN.
 - G. UTILIZE TYPICAL CONNECTIONS IN SKEWED CONFIGURATIONS AS REQUIRED U.O.N.
 - H. THE DETAILS ON THIS SHEET SHOW STRUCTURAL FEATURES ONLY. FOR DETAILS AND DIMENSIONS NOT SHOWN, REFER TO DRAWINGS OTHER THAN STRUCTURAL.

23 STEEL JOIST NOTES AND LOADING CRITERIA



24 3/4"=1'-0"



25 3/4"=1'-0"




26 3/4"=1'-0"



27 3/4"=1'-0"




28 3/4"=1'-0"

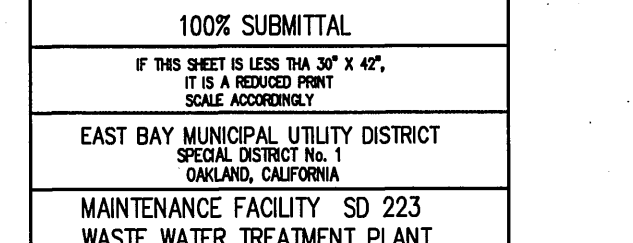


29 3/4"=1'-0"

30 3/4"=1'-0"


31 3/4"=1'-0"

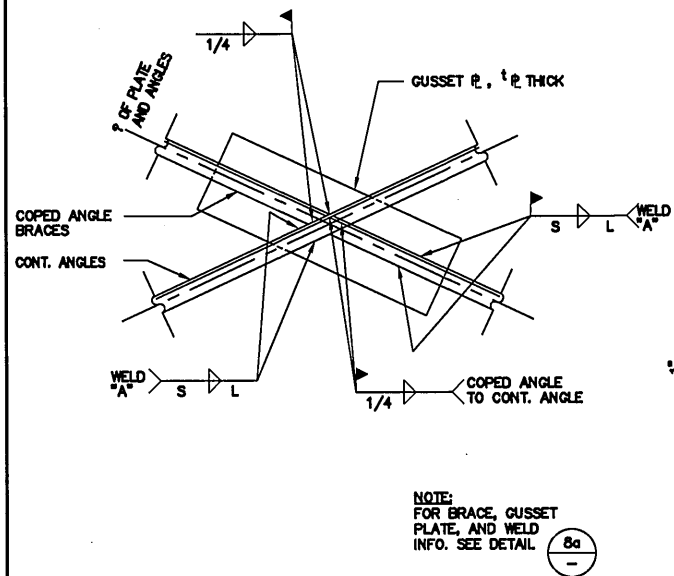


17 BRACE INTERSECTION

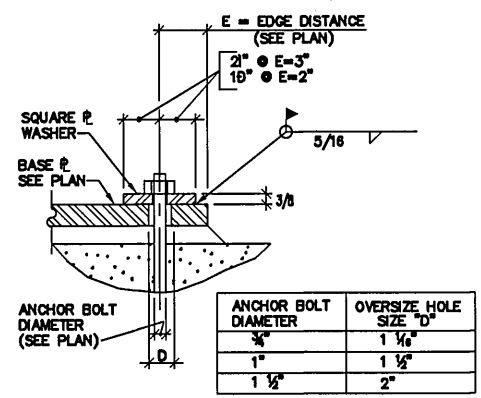


18 OVERSIZED HOLE WITH WELD WASHER

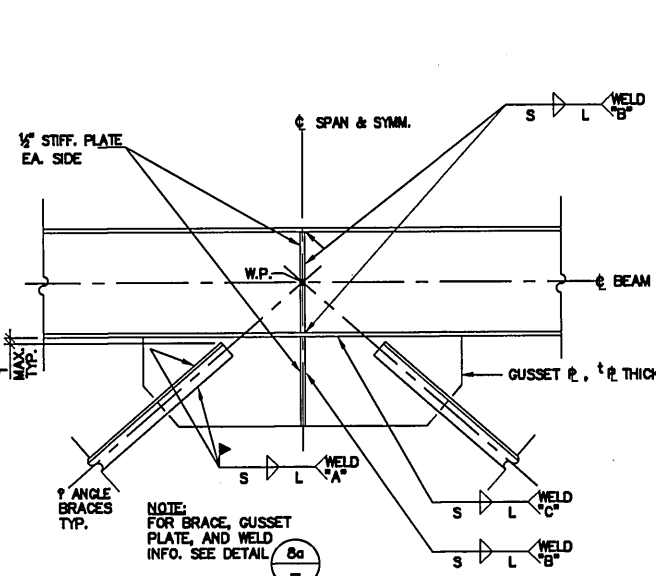


13 ANGLE BRACE CONNECTION TO WF BEAM AT MIDSPAN

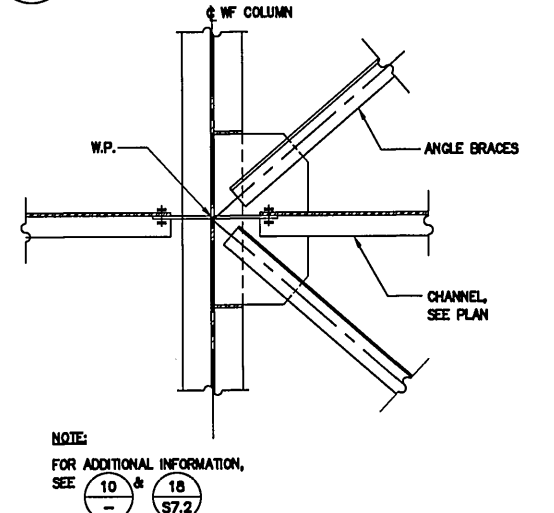


14 ANGLE BRACE CONNECTION TO CHANNEL AND WF COLUMN

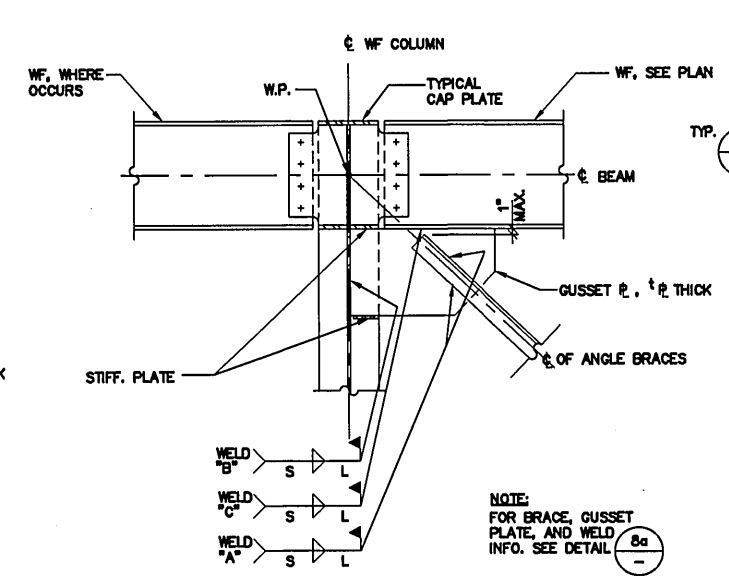


9 ANGLE BRACE CONNECTION TO WF BEAM AND WF COLUMN

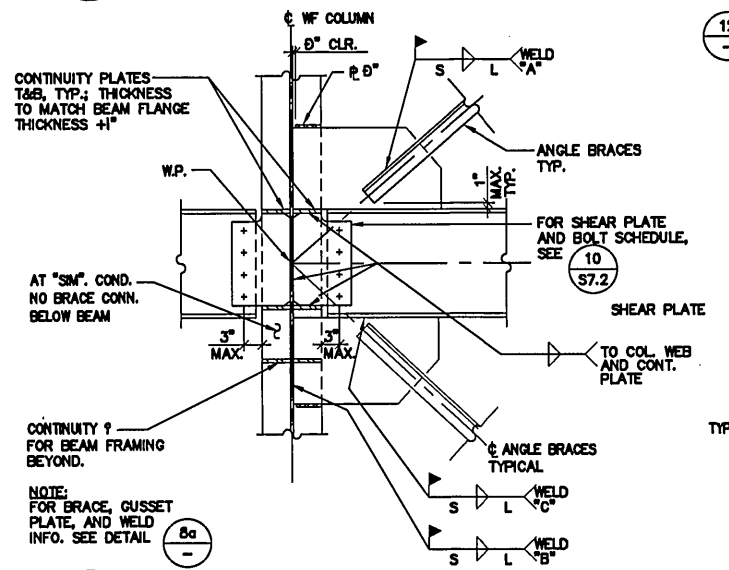


10 ANGLE BRACE CONNECTION TO WF BEAM AND WF COLUMN

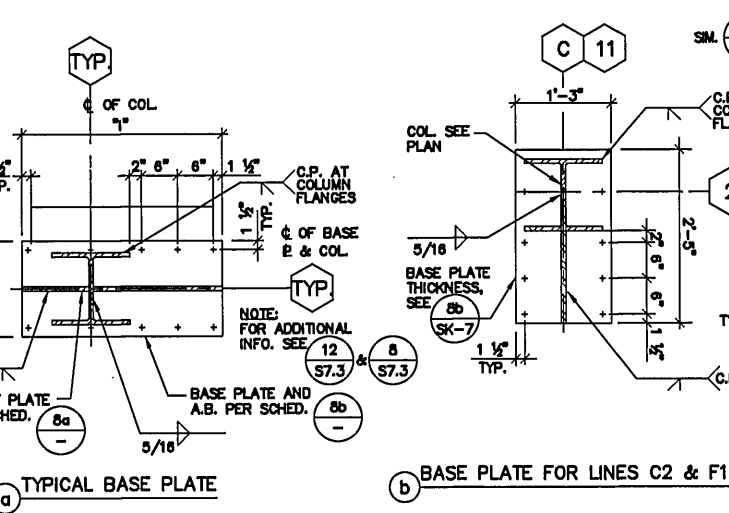


15 WF COLUMN BASE PLATE

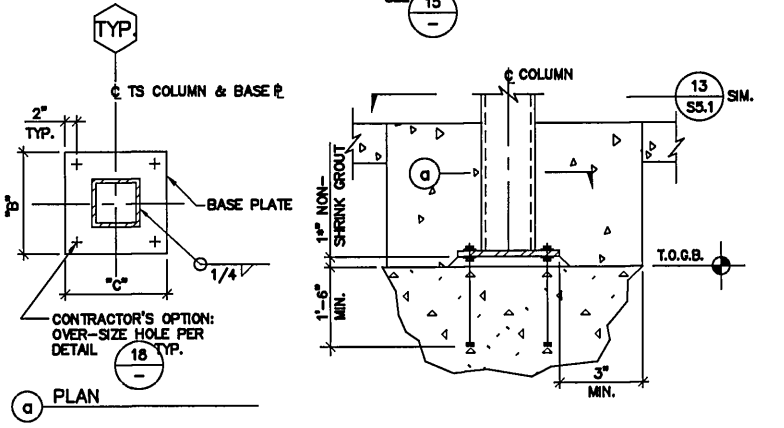


16 TS COLUMN BASE PLATE

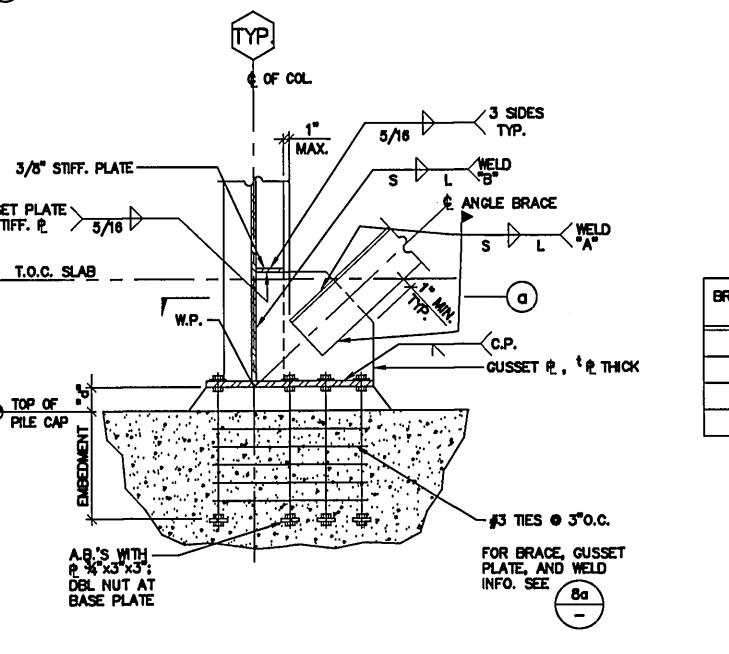


12 BRACE ANCHORAGE AT WF COLUMN

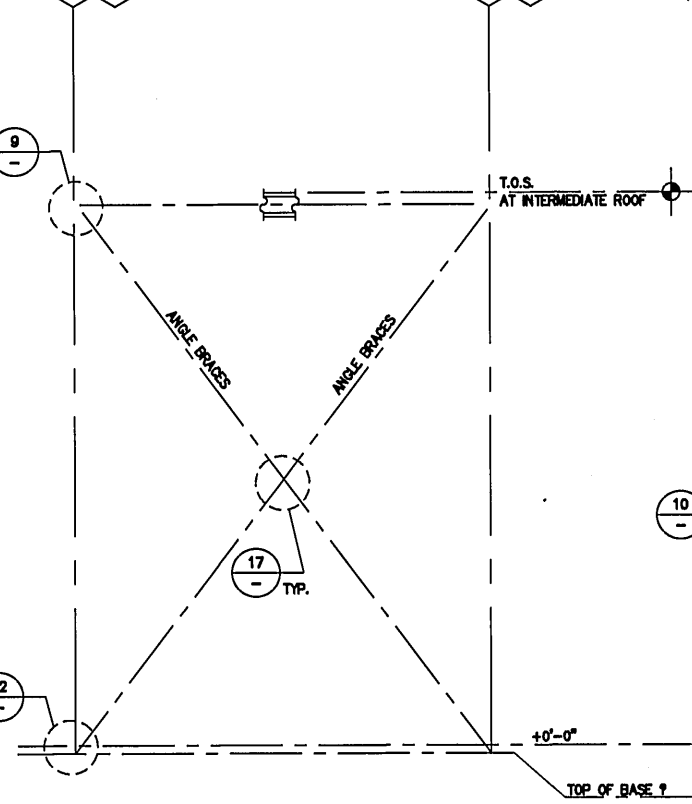


CROSSED BRACED FRAMED ELEVATION [BF-1]

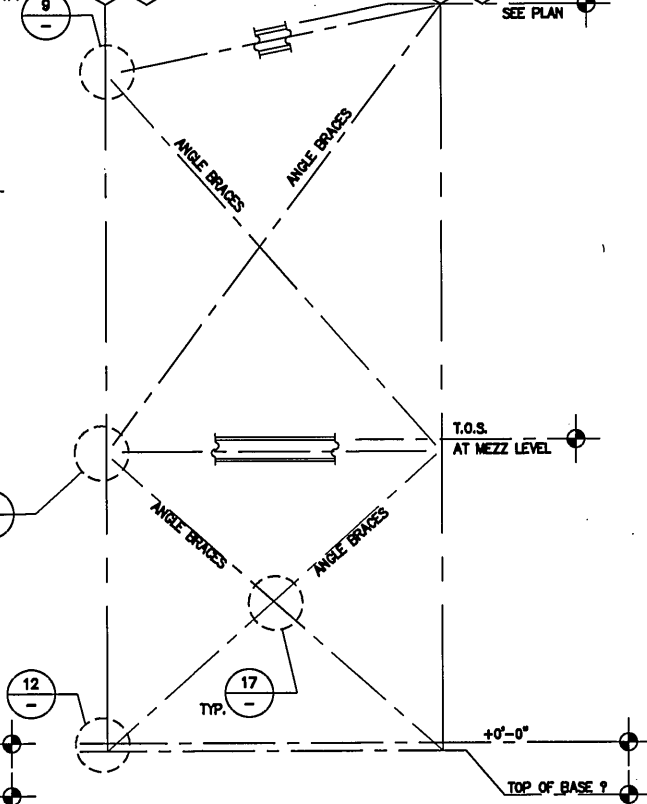

CROSSED BRACED FRAMED ELEVATION [BF-2]

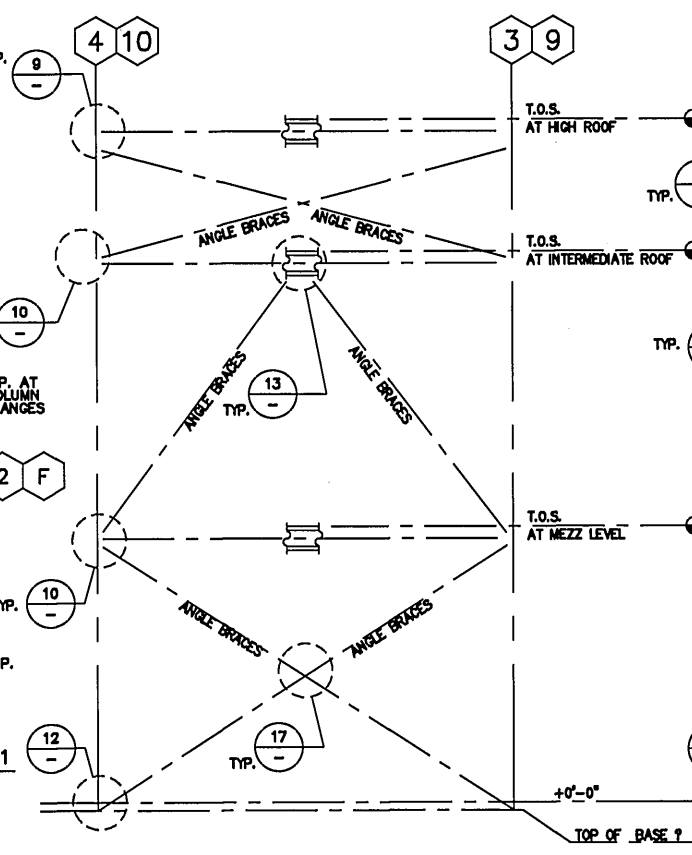

CROSSED & CHEVRON BRACED FRAMED ELEVATION [BF-3]

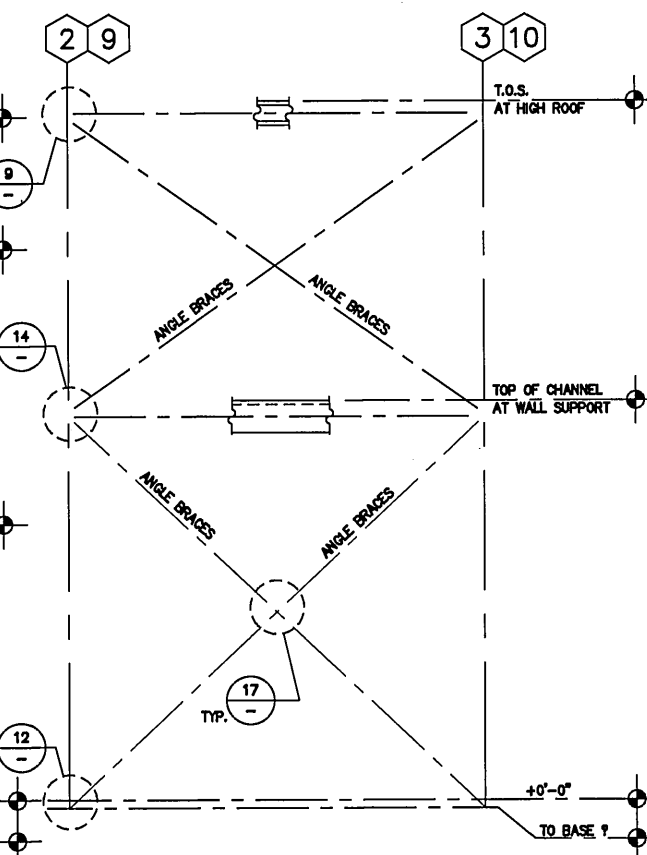


CROSSED BRACED FRAME ELEVATION [BF-4]

BRACED FRAME	BRACE TYPE	GUSSET PLATE THICKNESS, "t"	WELD "A" S L	WELD "B" S L	WELD "C" S L
[BF-1]	J.L. 4x4x3/8	1/2"	1/4" 4" 1/4" 8"	1/4" 8"	1/4" 8"
[BF-2]	J.L. 4x4x3/8	1/2"	1/4" 4" 1/4" 8"	1/4" 8"	1/4" 8"
[BF-3]	J.L. 4x4x3/8	1/2"	1/4" 4" 1/4" 8"	1/4" 8"	1/4" 8"
[BF-4]	J.L. 4x4x3/8	1/2"	1/4" 4" 1/4" 8"	1/4" 8"	1/4" 8"

NOTE:
1. WELD LENGTHS NOTED IN SCHEDULE ARE MINIMUM LENGTHS TO BE WELDED ON BOTH SIDES OF GUSSET PLATE.

FOOTING MARK	BASE PLATE THICKNESS, "t"	ANCHOR BOLTS SIZE	ANCHOR BOLTS EMBEDMENT	NUMBER	NON-SHRINK GROUT ("d")
[BF-1]	1/2"	3/4"	15"	8"	1 1/2"
[BF-2]	1 1/2"	3/4"	15"	8"	1 1/2"
[BF-3]	1"	3/4"	15"	8"	1 1/2"
[BF-4]	1"	3/4"	15"	8"	1 1/2"

NOTE:
1. SIZES AND LENGTHS NOTED IN SCHEDULE ARE MINIMUM REQUIRED.
2. "W" MAY VARY, SEE DETAIL.

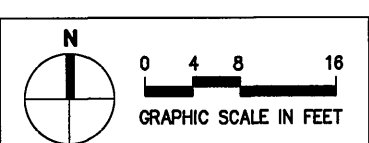

DASSE DESIGN INC.
STRUCTURAL ENGINEERS
23100 RIVERVIEW BLVD., SUITE 200
OAKLAND, CA 94620-1070
(415) 551-1070

The Ratcliff Architects
ARCHITECTS
1100 CALIFORNIA STREET, SUITE 200
OAKLAND, CA 94604
(415) 763-1070

DESIGNED BY	J.W.	PROJECT MGR.	R.P.E. No.
DESIGN CHECKED BY	J.W.	PROJECT SUPERVISOR	R.P.E. No.
DRAWN BY	M.T.	APPROVED	
BY	REG. APP.	PRINCIPAL-IN-CHARGE, R.P.E. NO.	

100% SUBMITTAL

IF THIS SHEET IS LESS THAN 30" X 42", IT IS A REDUCED PRINT SCALE ACCORDINGLY.

EAST BAY MUNICIPAL UTILITY DISTRICT
SPECIAL DISTRICT No. 1
OAKLAND, CALIFORNIA


MAINTENANCE FACILITY SD 223
WASTE WATER TREATMENT PLANT
TRA PROJECT NO. 96007.02

BRACED FRAME DETAILS


FACTORY
SCALE NONE
DATE 23 MAR. 1998

DRAWING No. **97.3**
SHEET OF
SPECIFICATION NO.


FILE: F:\BRACED\3\Drawings\BRACED_FRAME_DETAILS.dwg 02/09/98 at 21:08
XREF: 1. 01531-TB.DWG

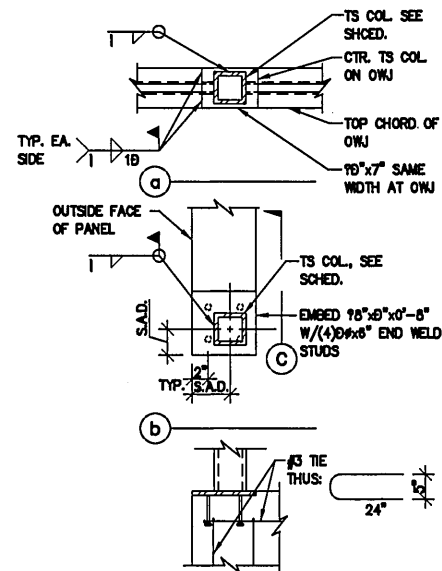


13 TS COLUMN AT OWJ AND TILT UP PANEL

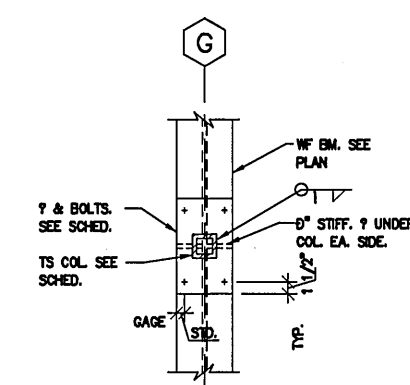

14 TS COLUMN BASE CONNECTION AT WF BEAM

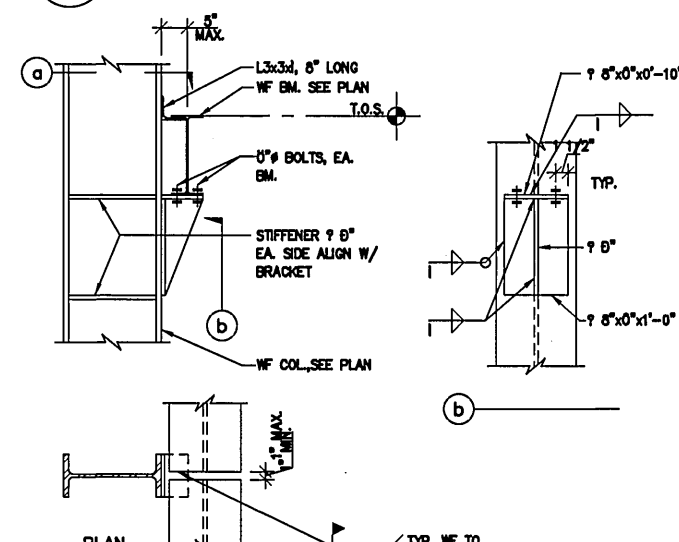


15 OFFSET WF SUPPORT

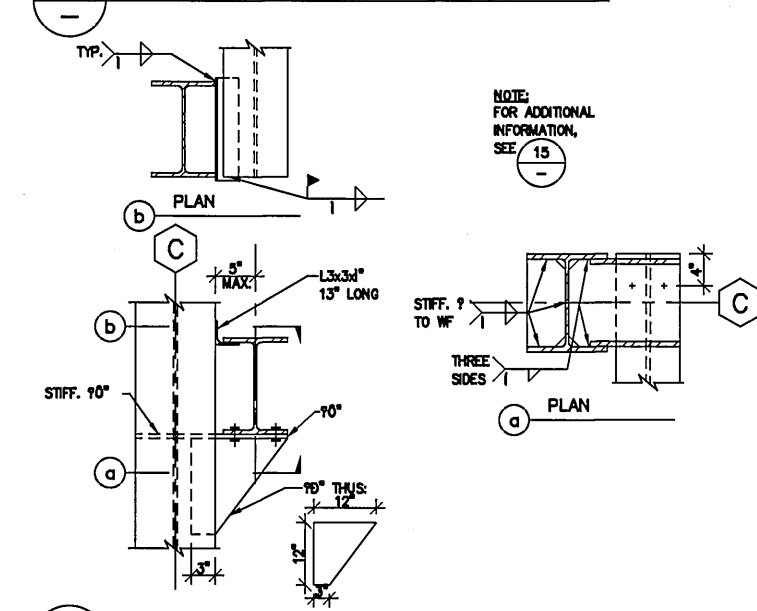


16 OFFSET WF SUPPORT

COLUMN SCHEDULE				
MARK	COLUMN SIZE	BASE # B x t x c	ANCHOR BOLTS (A307 U.O.N.)	BASE PLATE DETAIL
WF1	W12x58	1'-6"x8"x1'-8"	(4) 0"	15 S7.3
WF2	W12x50	1'-4"x8"x1'-8"	(4) 0"	15 S7.3
WF3	W12x58	SEE DETAIL	SEE DETAIL	12 S7.3
TS6	TS6x8d	1'-2"x8"x1'-2"	(4) 0"	16 S7.3
TS4	TS4x6d	SEE DETAIL	SEE DETAIL	13
TS3	TS3x3d	1'-2"x8"x1'-0"	(4) 0"	14


9 COLUMN SCHEDULE

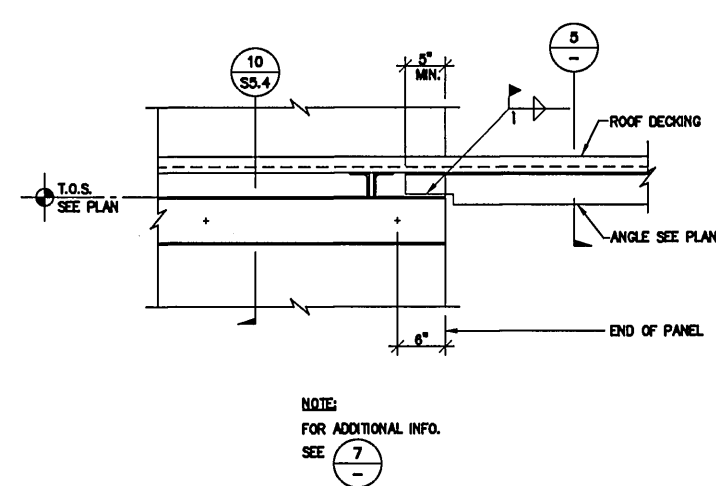


10

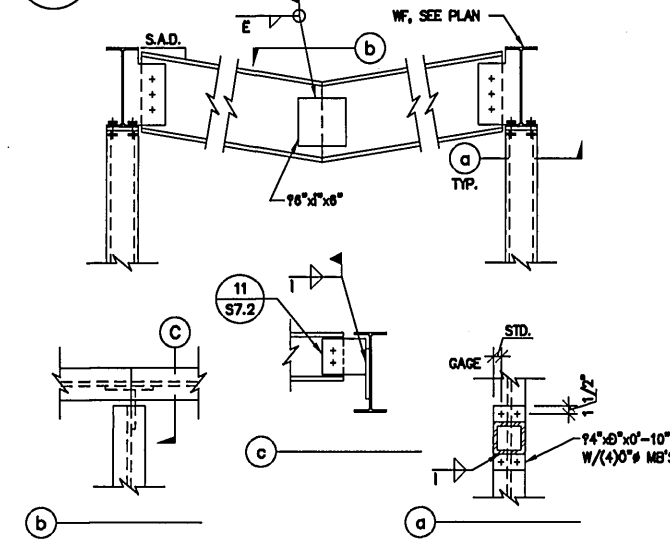


11

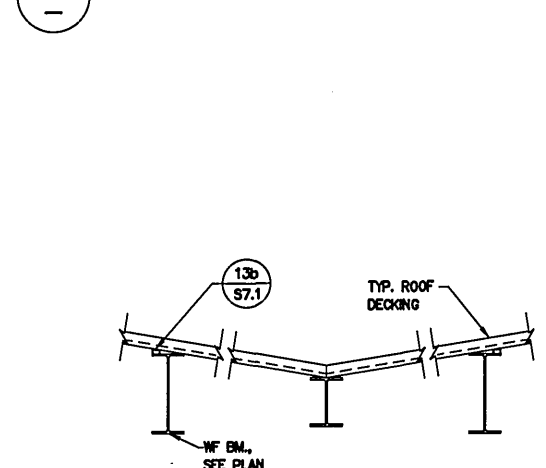


12

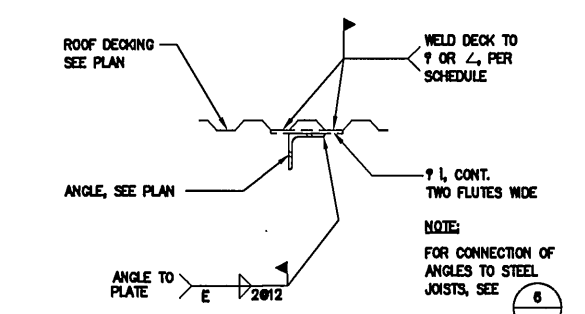


5

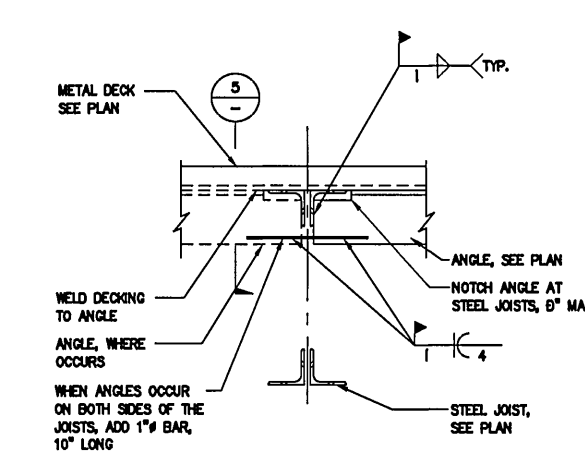


6

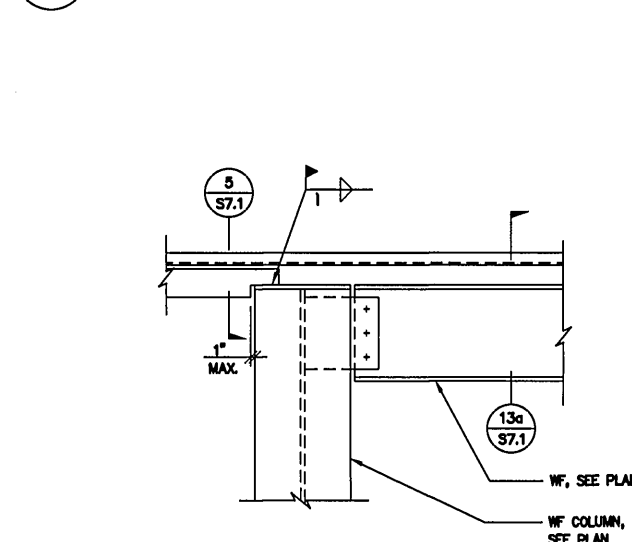


7

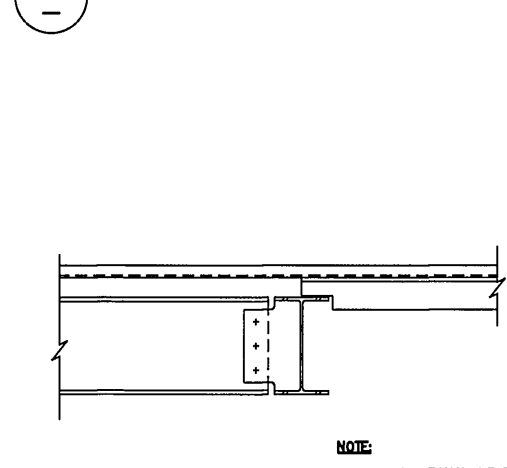

8

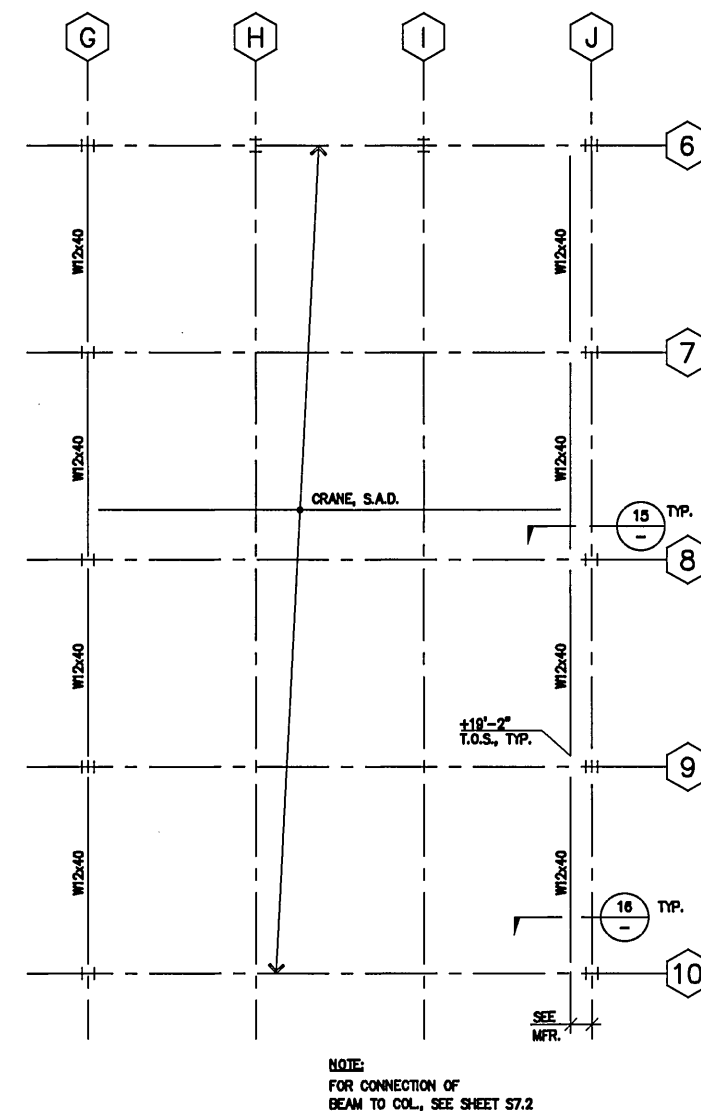

2 5 TON CRANE FRAMING PLAN

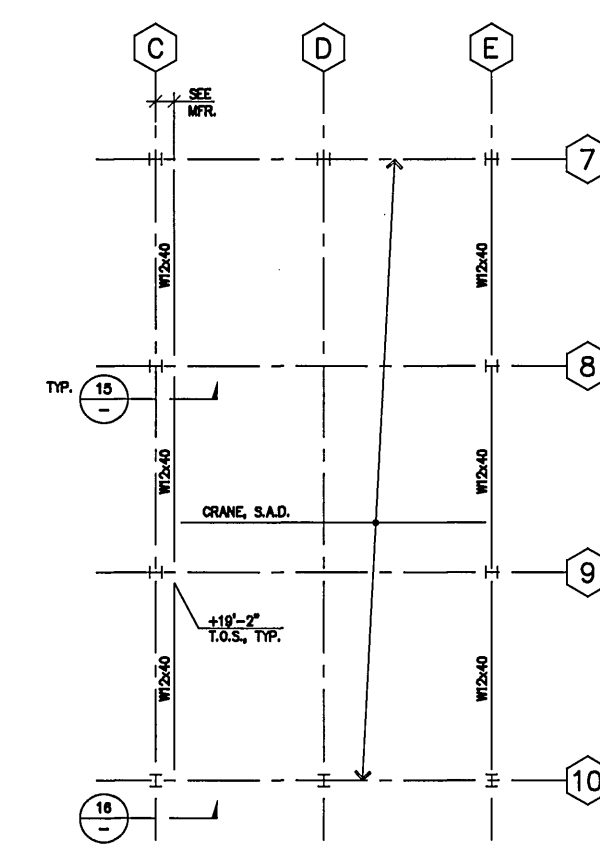

4 3 TON CRANE FRAMING PLAN



100% SUBMITTAL

IF THIS SHEET IS LESS THAN 30" X 42", IT IS A REDUCED PRINT SCALE ACCORDINGLY

EAST BAY MUNICIPAL UTILITY DISTRICT
SPECIAL DISTRICT NO. 1
OAKLAND, CALIFORNIA

MAINTENANCE FACILITY SD 223
WASTE WATER TREATMENT PLANT
TRA PROJECT NO. 96007.02


TYPICAL STEEL DETAIL

DRAWING No. 874

SHEET OF

SPECIFICATION NO.

FILE: F:\0816202\Struct\0816202.dwg 02/06/98 at 21:48

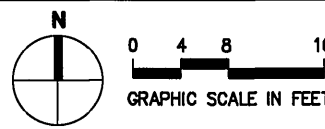

DASSE DESIGN INC.
STRUCTURAL ENGINEERS
30 New Montgomery St., Suite 600
Oakland, CA 94612-4000

The Ratcliff Architects
ARCHITECTS
1000 BAY STREET
OAKLAND, CA 94612

NO.	DATE	REVISION	BY	CHK.	APP.	REVISION
1	3/20/98	RECORD DRAWING	JW	JLW		
2	3/20/98	EDMUD/PLAN CHECK COMMENT	JW	JLW		

DESIGNED BY	JW
DESIGN CHECKED BY	JW
DRAWN BY	WTO
IN CHARGE	JW
APPROVED	JW

PROJECT NO.	96007.02
PROJECT SUPERVISOR	JW
DATE	23 MAR. 1998

3.6 Maintenance Center (F4)

3.6.1 Description

The Maintenance Center was design in 1998 as part of project SD223A. The building was designed in accordance with the 1994 Uniform Building Code for Life Safety performance, the minimum building code requirement for all buildings. The Maintenance Center is a highly irregular one-story building with a low, intermediate, and high-roof portion. The building also has a mezzanine level which extends partially into the high and intermediate roof portions. Although each roof portion has a metal deck diaphragm, the mezzanine level has a concrete-filled metal deck. The high and intermediate-roof portions consist of steel braced frames and precast concrete wall cladding, while the low-roof portion consists of precast concrete shear walls. The entire structure is supported by cast-in-place concrete pile caps with precast concrete piles.



Figure 3.6-1: Maintenance Center

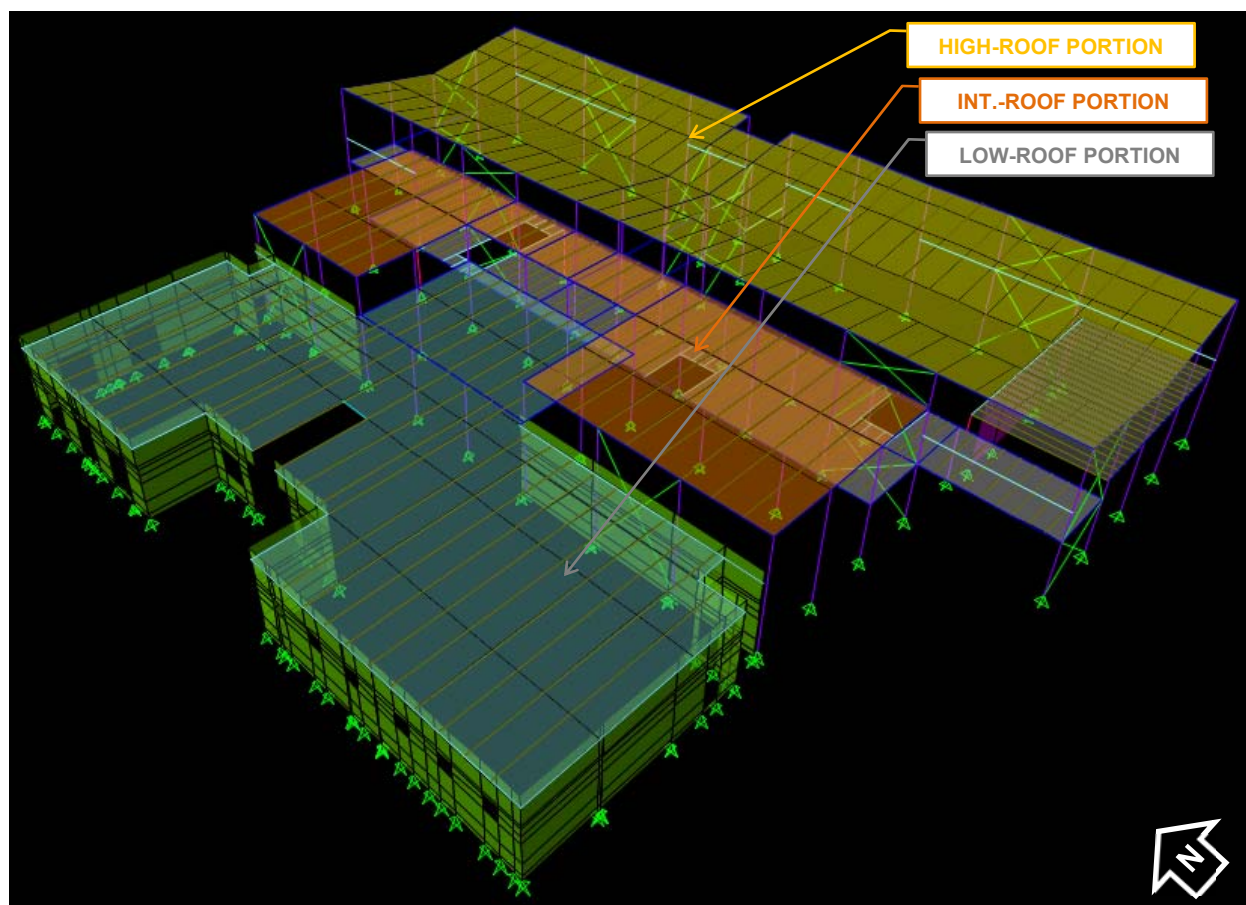


Figure 3.6-2: Maintenance Center Analysis Model of Existing Building

3.6.2 Seismic Deficiencies & Proposed Retrofit Measures

The following table summarizes the ASCE 41 Tier 3 seismic deficiencies identified and the corresponding retrofit measures proposed for the Maintenance Center.

Low-Roof Portion

Table 3.6-1: Seismic Deficiencies and Proposed Retrofit Measures (Low-Roof Portion)

TIER 3 SEISMIC DEFICIENCIES	PROPOSED SEISMIC RETROFIT MEASURES
<p>Precast Concrete Walls (Out-of-Plane) The precast concrete wall panels lack cross ties in the north-south direction, and they are not adequately anchored to the existing steel joists and metal deck roof diaphragm in the east-west direction.</p>	<p>Add steel cross-ties in the north-south direction. Strengthen the connection between the existing steel joists and the precast concrete walls.</p>
<p>Re-entrant Corners The metal deck roof diaphragm has several re-entrant corners with inadequate ties and connections.</p>	<p>Strengthen the existing re-entrant corner ties and connections.</p>
<p>Steel Truss Collectors The existing steel trusses and connections appear to lack adequate strength to serve as collectors.</p>	<p>Strengthen the existing steel truss top chords and their connections to the precast concrete shear walls.</p>
<p>Precast Concrete Walls (In-Plane) The precast concrete shear wall panels are not interconnected and they are not adequately connected to the existing concrete foundation.</p>	<p>Connect the existing precast concrete panels together with steel plates. Strengthen the connection between the existing precast concrete panels and the existing concrete grade beams with new concrete beams.</p>
<p>Precast Concrete Piles The structure's 12" square precast concrete piles are partially embedded in liquefiable soil. The piles are close to meeting the acceptance criteria for combined axial loads and flexure.</p>	<p>Improving the existing soil using jet grouting is proposed as a potential strengthening measure to provide improved soil lateral resistance around the perimeter of the building.</p>
<p>Seismic Gaps The low-roof framing and metal deck are connected directly to the intermediate roof steel columns without a seismic gap to allow for the two different lateral systems to behave independently.</p>	<p>Add steel beams and columns below the low-roof portion which encroaches into the intermediate-roof portion. Cut back the low-roof metal deck and beams so that the two structures are no longer tied together.</p>

Intermediate-Roof and High-Roof Portion

Table 3.6-2: Seismic Deficiencies and Proposed Retrofit Measures

TIER 3 SEISMIC DEFICIENCIES	PROPOSED SEISMIC RETROFIT MEASURES
Precast Concrete Wall Panels The precast concrete wall panels are not adequately anchored for out-of-plane loading.	Strengthen the existing steel channel beams along the east side of the building. Provide additional epoxy anchors.
Metal Deck Diaphragm The existing metal deck roof diaphragm does not have adequate shear strength.	Provide additional lines of braced frames in order to reduce the diaphragm demands.
Concrete-Filled Metal Deck Diaphragm The concrete-filled metal deck diaphragm at the mezzanine level does not have adequate shear strength.	Provide additional lines of braced frames in order to reduce the diaphragm demands. Replace the existing steel trusses along the new braced frame lines with steel wide flange beams with welded shear studs.
Steel Braced Frame & Collector Beams The steel braced frame and collector beams and their connections do not have adequate strength.	Strengthen the existing steel beams with welded steel plates. Strengthen the existing steel beam connections.
Steel Braces & Connections The steel braces and their connections do not have adequate strength.	Replace the existing steel braces and gusset connections with new Buckling Restrained Braces (BRB's) and gusset connections. Provide additional braced frames.
Steel Braced Frame Columns Some steel braced frame columns do not have adequate compression strength.	Strengthen the existing columns with welded steel plates. Provide additional braced frames.
Steel Braced Frame Column Anchorage The braced frame column anchors do not have adequate strength for combined shear and tension.	Strengthen the existing anchorage. Provide additional braced frames.
Steel Braced Frame Stability The steel braced frames along gridlines 5 and 6 are not braced out-of-plane.	Brace the braced frames to the mezzanine diaphragm with horizontal steel braces.
Steel Gravity Columns The steel gravity columns along gridline F, which support the high and intermediate roof, do not have adequate strength to accommodate the differential diaphragm displacements between the high-roof and intermediate-roof.	Provide additional lines of braced frames in the east-west direction. Add new braces from the intermediate-roof to the high-roof at gridlines 5 and 6.
Welding & Paint Shop Mezzanine The CMU walls along the north side of the shops are not adequately anchored for out-of-plane loads to the steel joists and concrete-filled deck. The concrete-filled deck above the shops does not have an adequate load path to the braced frames.	Strengthen the connection between the existing steel joists and the CMU walls. Provide additional braced frames, and add new beams and braces to collect and transfer loads from the concrete-filled deck to the braced frames.
Precast Concrete Piles See related discussion for the Low-Roof portion in Table 3.6-1.	See related discussion for the Low-Roof portion in Table 3.6-1.
Seismic Gaps See related discussion for the Low-Roof portion in Table 3.6-1.	See related discussion for the Low-Roof portion in Table 3.6-1.


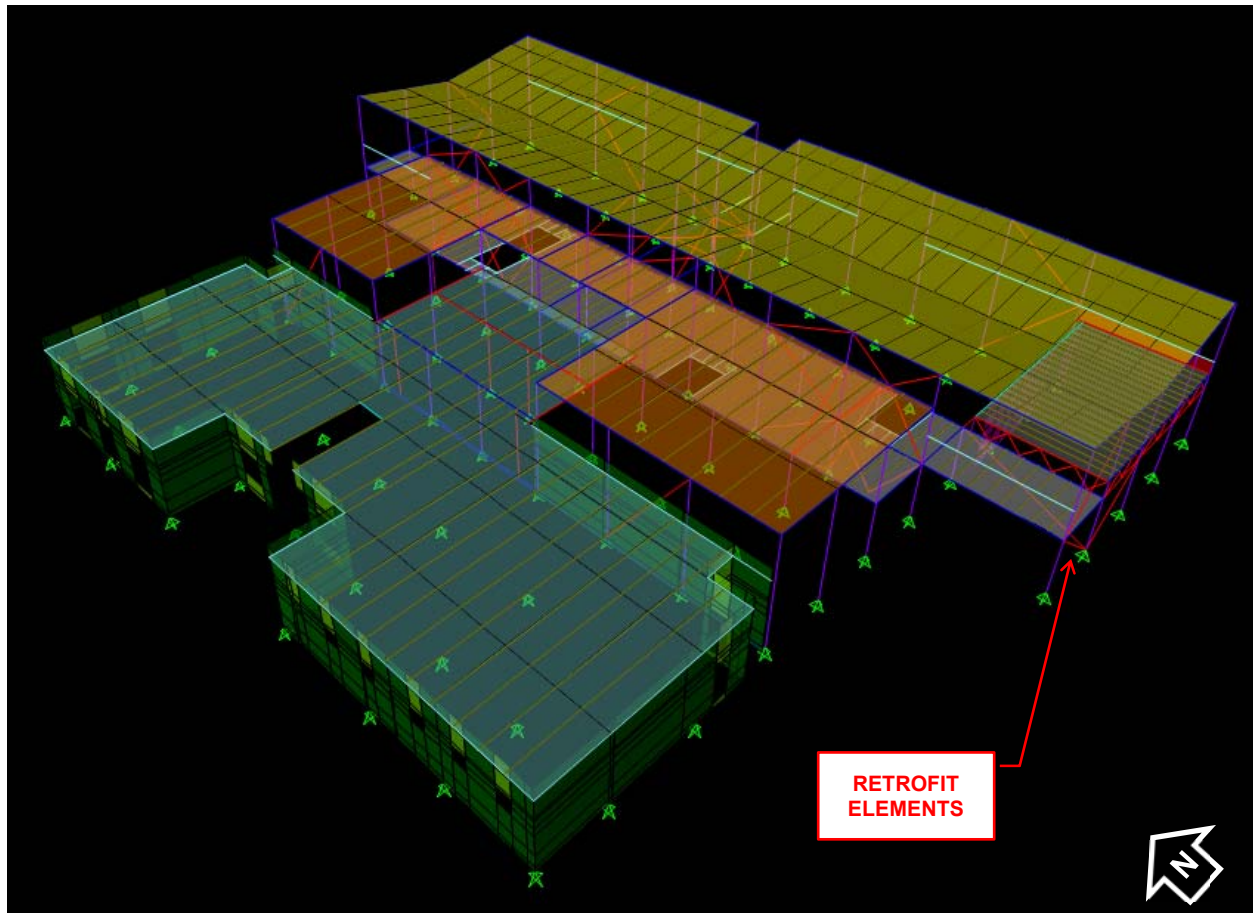


Figure 3.6-3: Maintenance Center Analysis Model of Retrofitted Building

KEY NOTES:

- A) REMOVE ALL (E) STEEL BRACES AND GUSSET PLATES.
- B) ADD BUCKLING RESTRAINED BRACES (BRB) & GUSSET PLATES, TYP. SEE FIGURES MC-4 & MC-5 FOR BRACED FRAME ELEVATIONS.
- C) ADD 30"x30" CONCRETE GRADE BEAM BETWEEN (E) PILE CAPS. PROVIDE EPOXY DOWELS INTO (E) SLAB ON GRADE @ 12" O.C. ON EACH SIDE OF GRADE BEAM.
- D) STRENGTHEN (E) STEEL COLUMN W/ WELDED STEEL PLATES.
- E) STRENGTHEN ALL BRACED FRAME COLUMN BASE ANCHORAGE CONNECTIONS.
- F) ADD HSS6x6 STEEL COLUMN & 18"x3'-0"SQ. FOOTING TO SUPPORT LOW ROOF FRAMING.
- G) STRENGTHEN (E) PRECAST WALL JOINTS @ ALL WALLS SUPPORTING LOW ROOF (9 LOCATIONS). PROVIDE STEEL PLATES ON EACH SIDE OF PRECAST WALL W/ THRU-BOLTS @ 24" O.C.
- H) STRENGTHEN (E) PRECAST CONC. WALL BASE CONNECTION W/ 8"x24" CONCRETE CURB W/ EPOXY DOWELS INTO TOP OF (E) CONC. GRADE BEAM FACE OF (E) PRECAST CONC. WALL, TYP. SEE DETAIL 3/T-1 (SIM).
- I) SAWCUT VERTICAL SLOT IN (E) PRECAST WALL & FILL W/ COMPRESSIBLE MATERIAL.

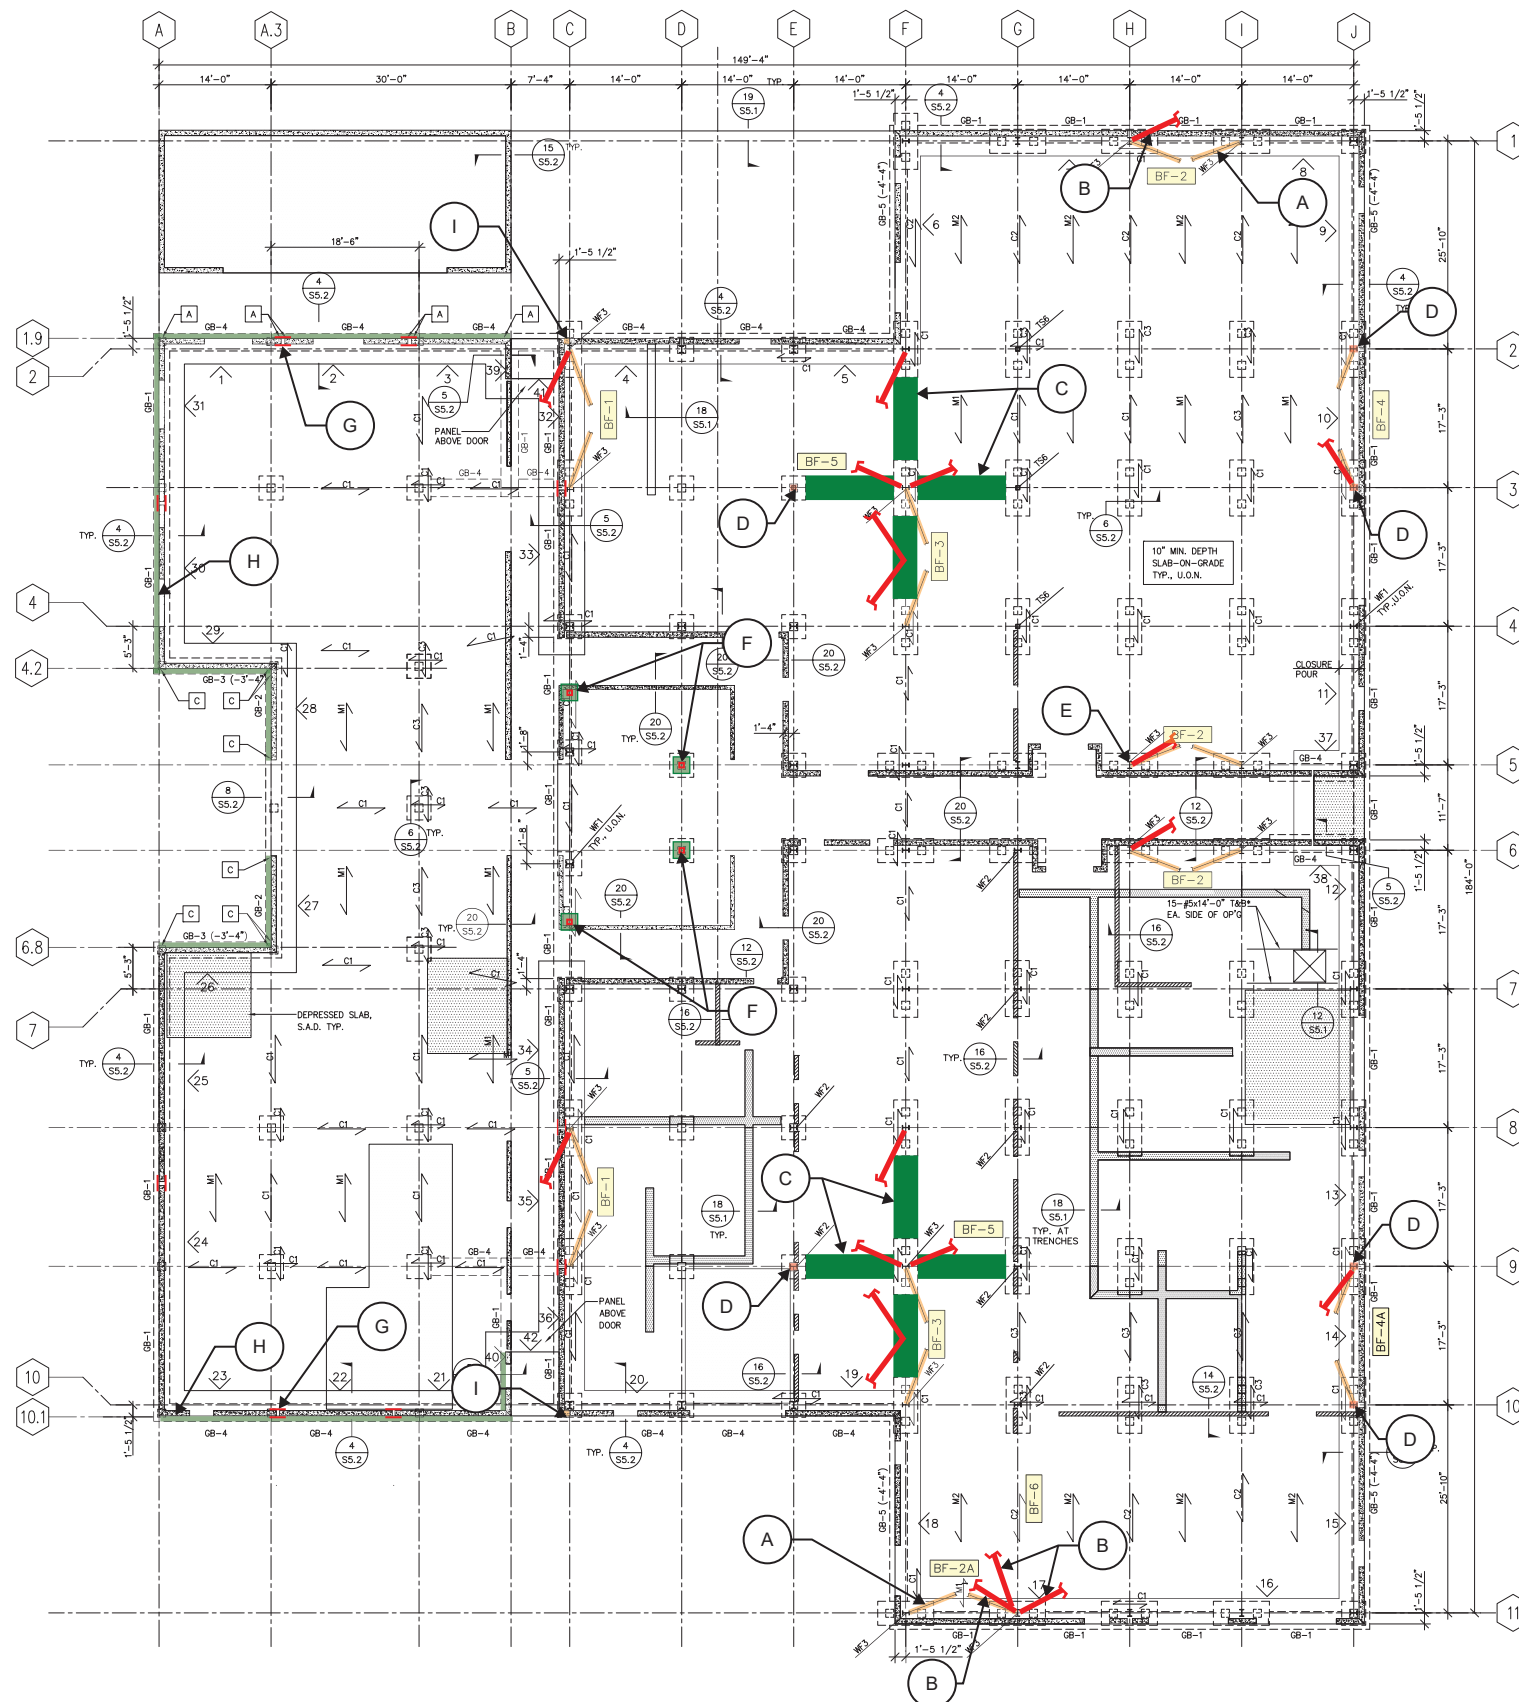

LEGEND

- DEMO EXISTING ELEMENT
■ NEW CONCRETE ELEMENT
■ NEW STEEL ELEMENT
■ NEW FRP ELEMENT

SEE DETAIL "X" ON FIGURE MC-"Y"

Figure MC-1: Maintenance Center First Floor & Foundation Plan




KEY NOTES:

- A) REMOVE ALL (E) STEEL BRACES AND GUSSET PLATES.
- B) ADD BRB & GUSSET PLATES, TYP. SEE FIGURES MC-4 & MC-5 FOR BRACED FRAME ELEVATIONS.
- C) SHORE (E) MEZZANINE DECK, DEMO (E) STEEL TRUSS, & ADD (N) W12x STEEL BEAMS. ADD WELDED SHEAR STUDS TO TOP BEAM FLANGE @ 12" O.C.
- D) ADD ROUND HSS5x HORIZONTAL DIAGONAL BRACING.
- E) STRENGTHEN (E) STEEL BEAMS W/ WELDED STEEL PLATES, TYP.
- F) STRENGTHEN (E) STEEL BEAM CONNECTIONS, TYP.
- G) STRENGTHEN (E) STEEL CHANNELS W/ WELDED STEEL PLATES & ADD OUT-OF-PLANE WALL EPOXY WALL ANCHORS @ 24" O.C., TYP.
- H) ADD ROUND HSS5x DIAGONAL BRACING, TYP.
- I) ADD W12x STEEL BEAMS ALIGNED W/ MEZZANINE LEVEL.
- J) ADD W12x STEEL BEAM BELOW (E) WELDING & PAINT SHOP CONCRETE-FILLED FLOOR DECK. ADD WELDED SHEAR STUDS TO TOP BEAM FLANGE @ 12" O.C.
- K) ADD 12"x30" CONCRETE BEAM ALONG TOPSIDE OF (E) WELDING & PAINT SHOP FLOOR DECK. CONNECT CONCRETE BEAM TO BOTTOM OF (E) STEEL CHANNEL W/ SHEAR STUDS @ 12" O.C., TO TOP OF (E) FLOOR DECK W/ (2) EPOXY DOWELS W/ 3" EMBED @ 6" O.C., AND TO (E) STEEL COLUMN @ GRIDLINE J-10 W/ (4) WELDED LONGITUDINAL REINFORCING BARS.
- L) STRENGTHEN (E) STEEL JOIST CONNECTIONS TO (E) CMU WALL, TYP.

LEGEND

- DEMO EXISTING ELEMENT
- NEW CONCRETE ELEMENT
- NEW STEEL ELEMENT
- NEW FRP ELEMENT

SEE DETAIL "X" ON FIGURE MC-"Y"

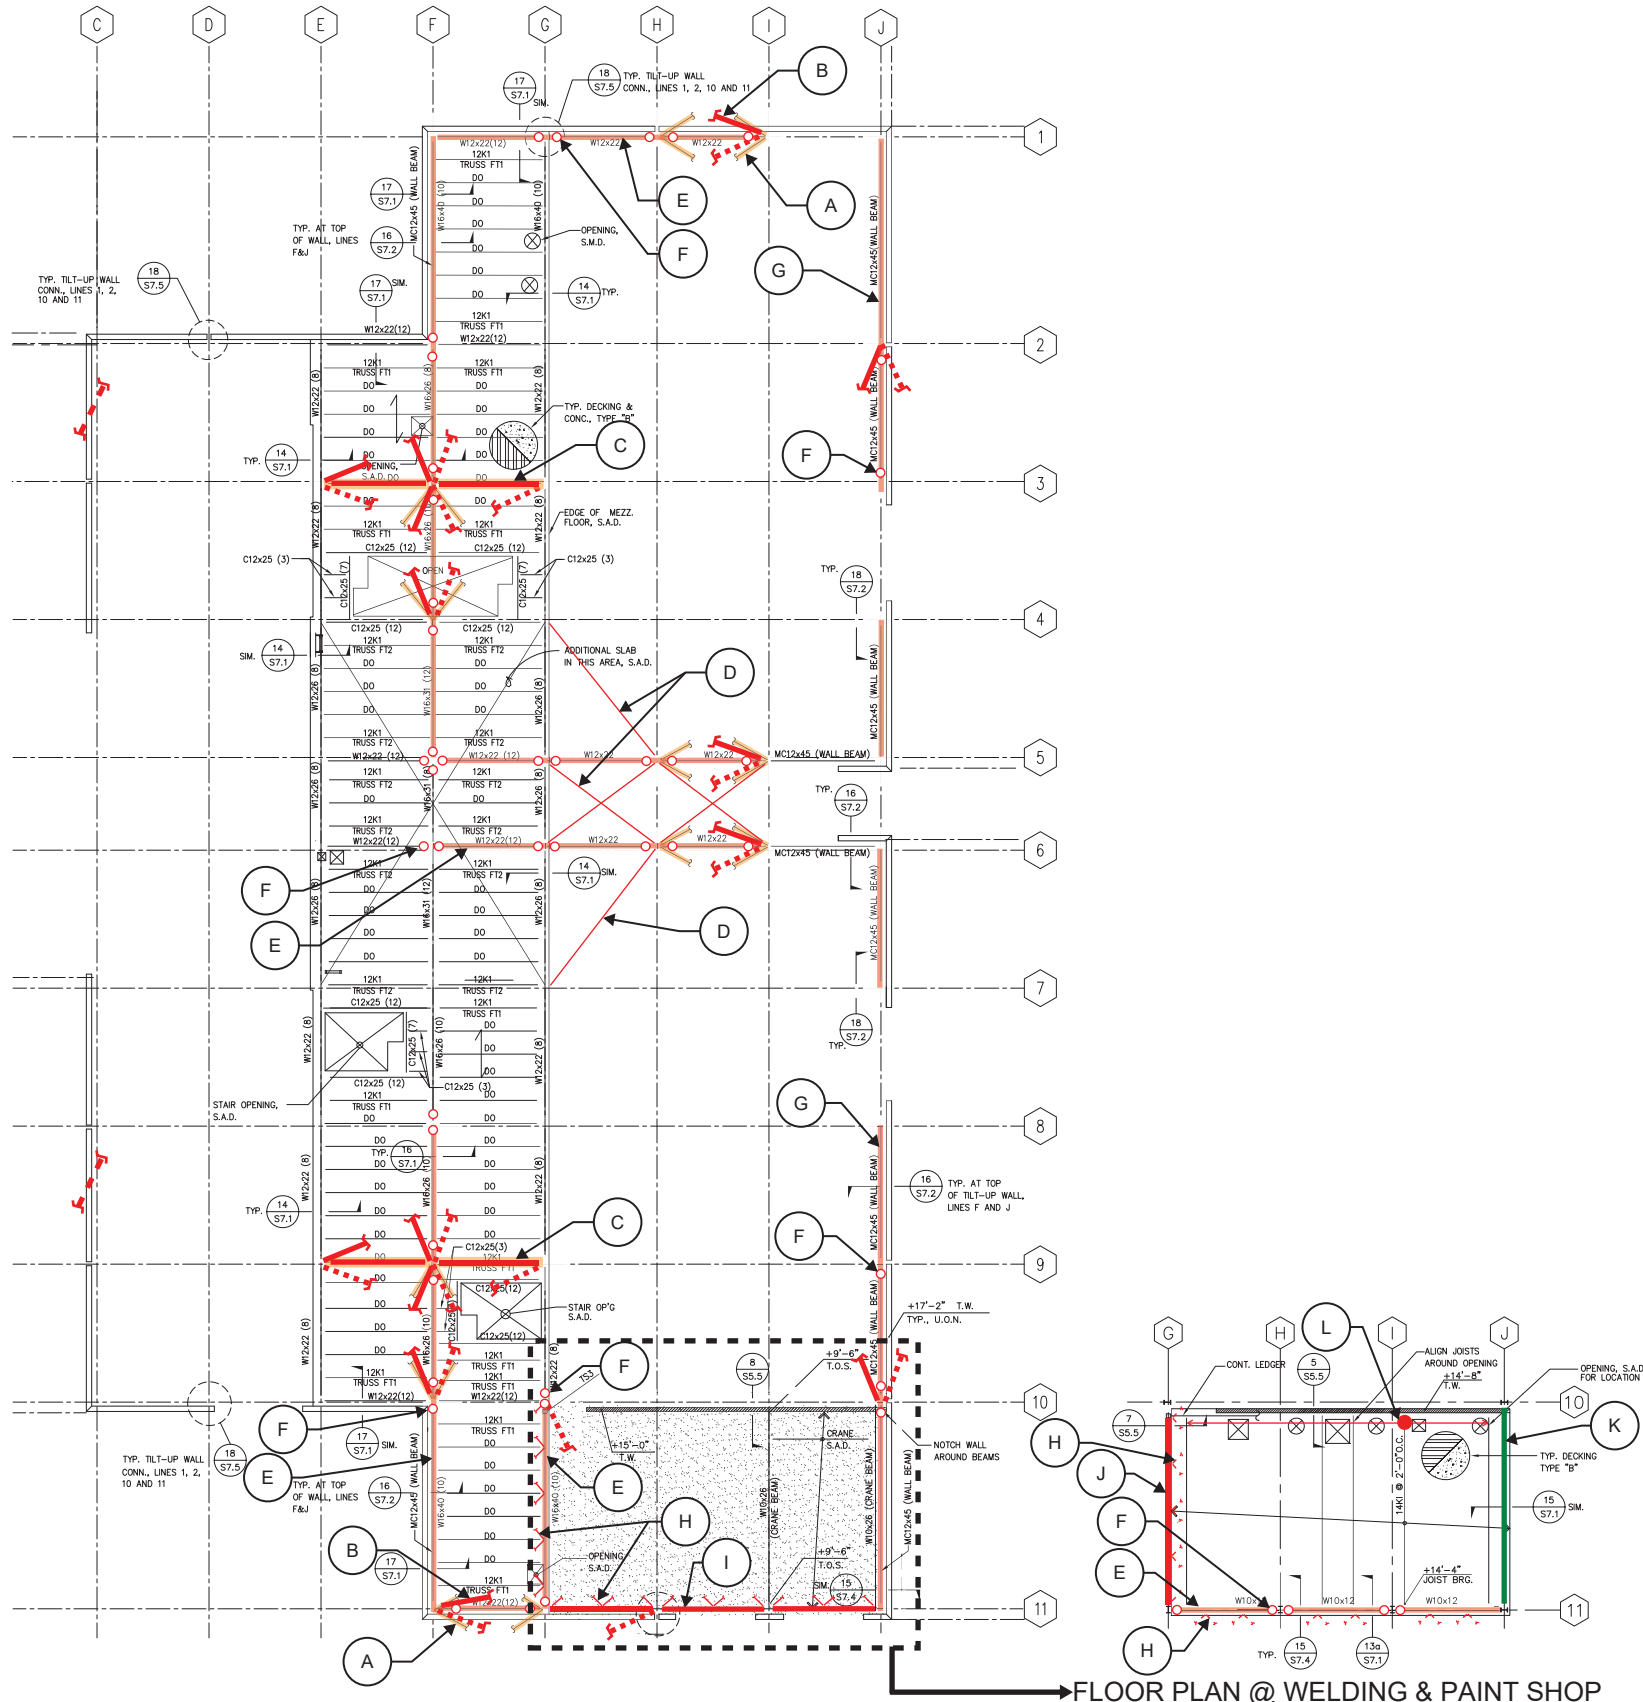

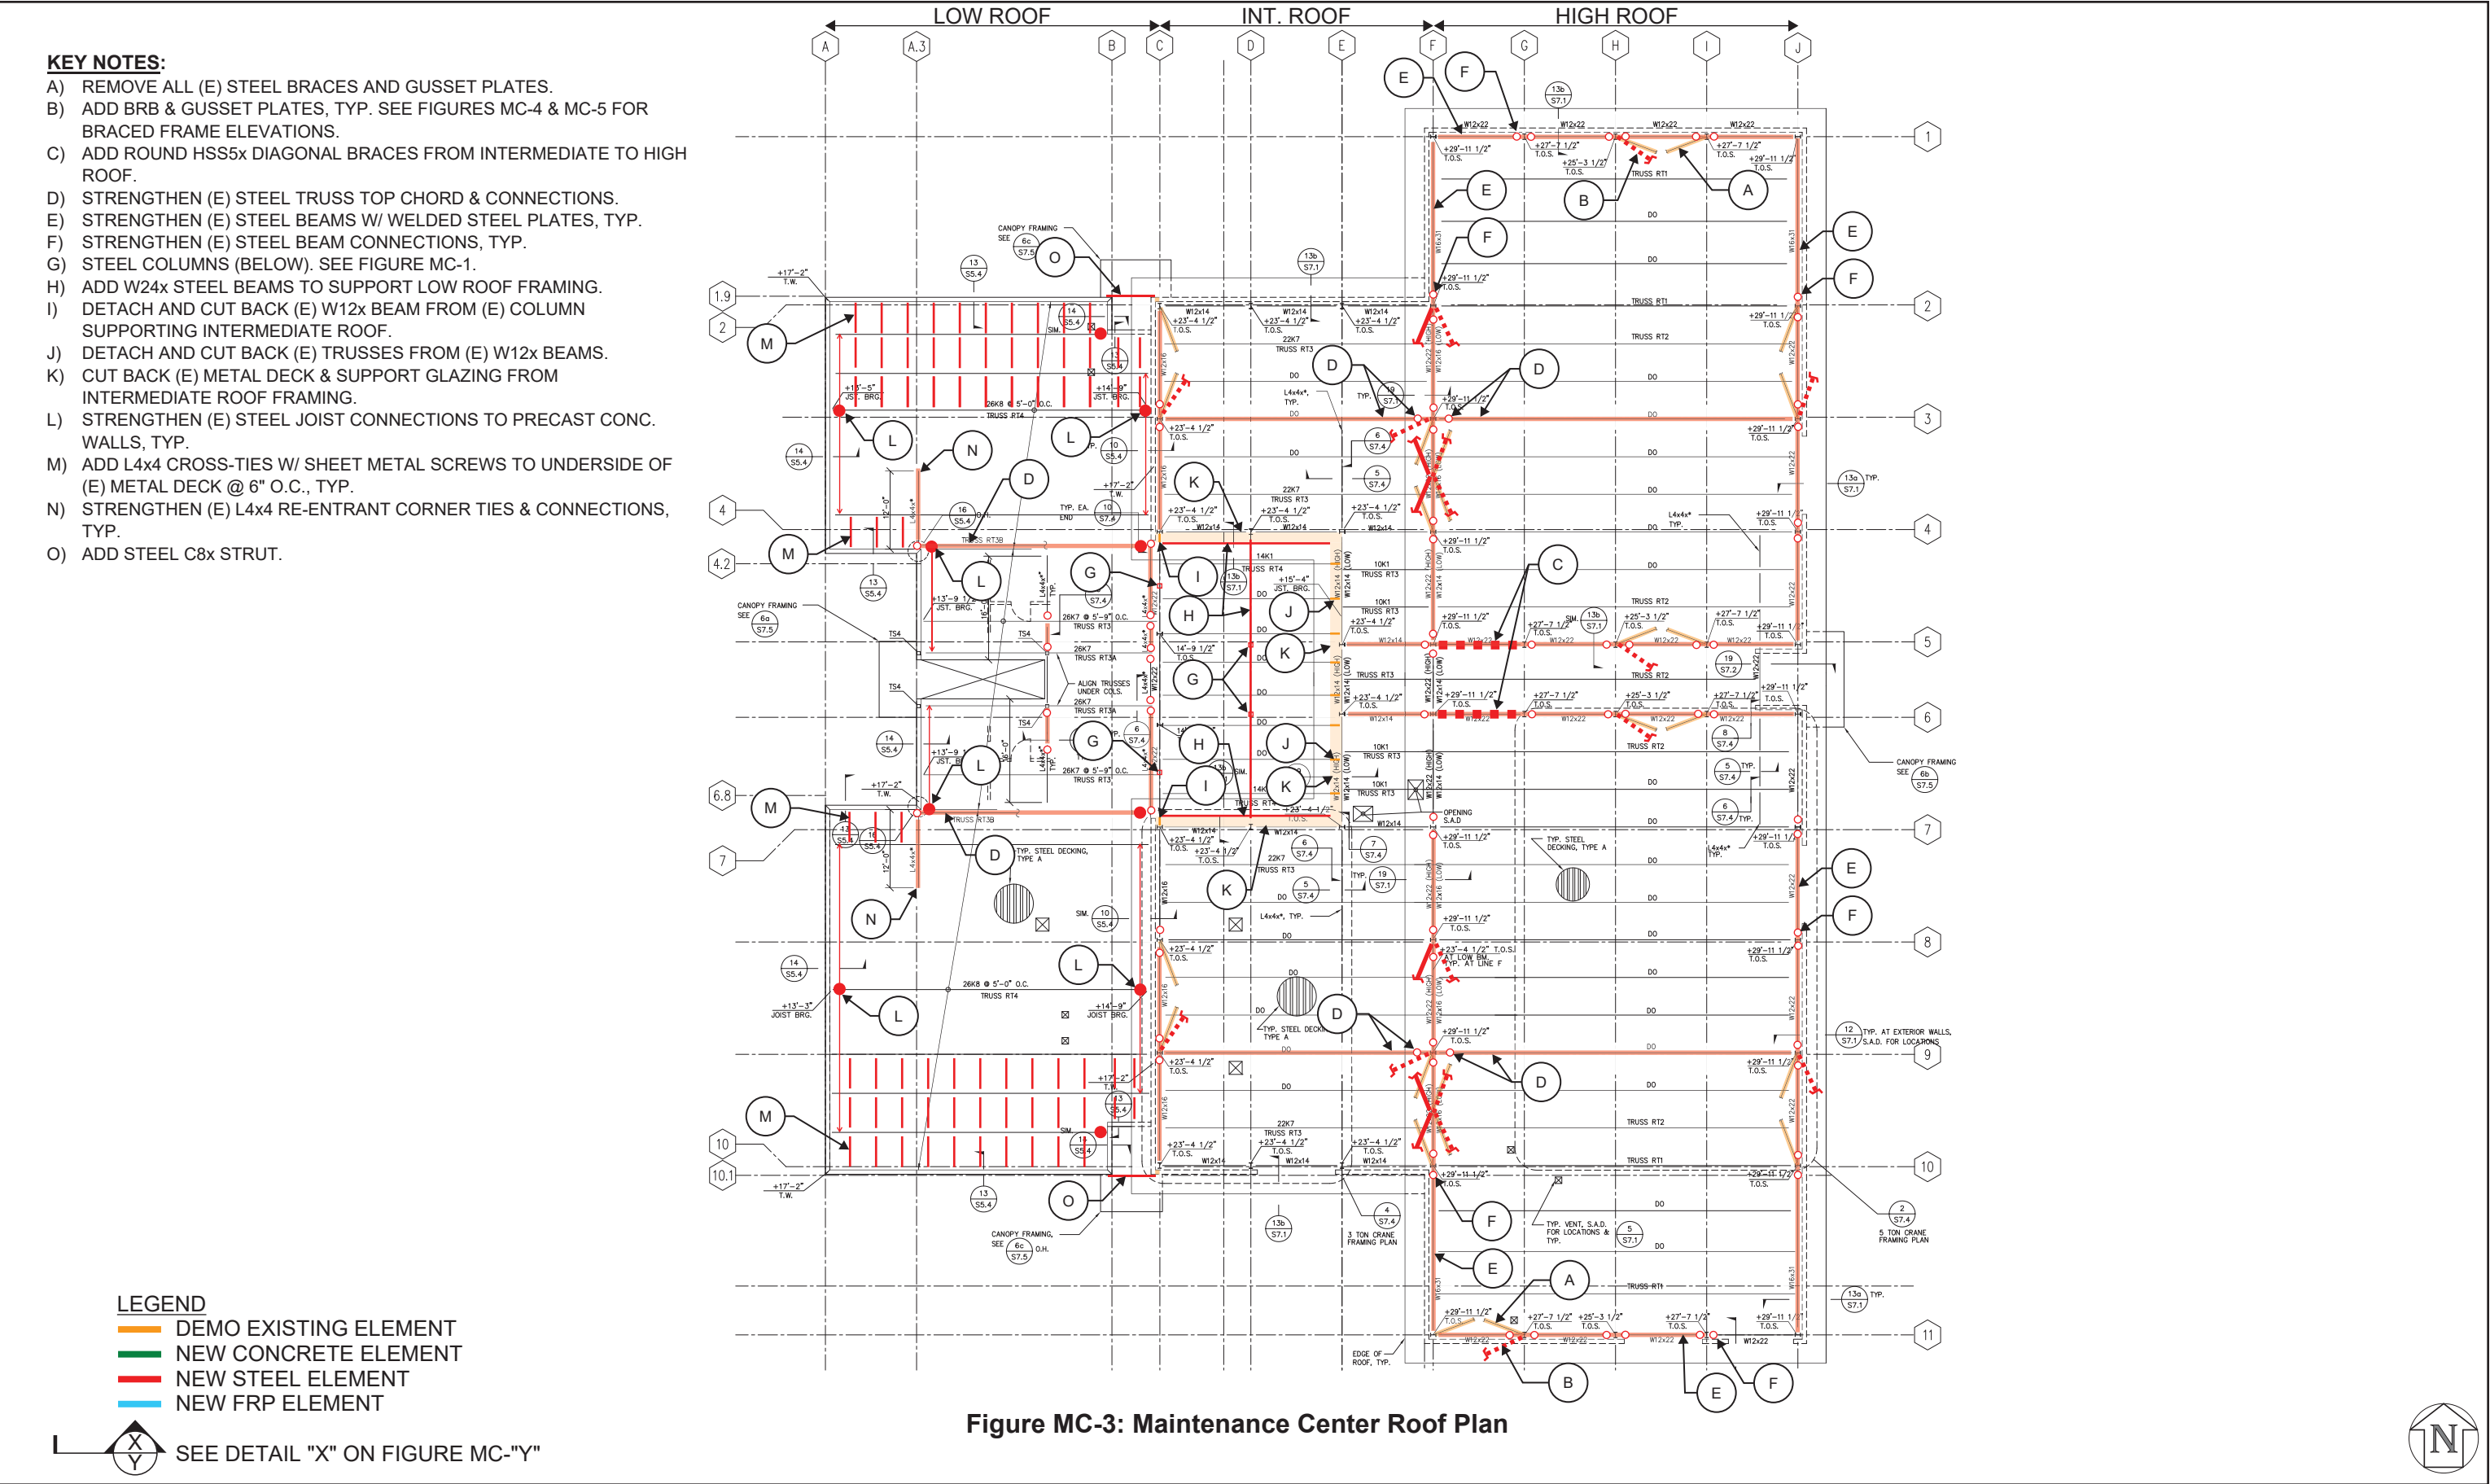


Figure MC-3: Maintenance Center Roof Plan



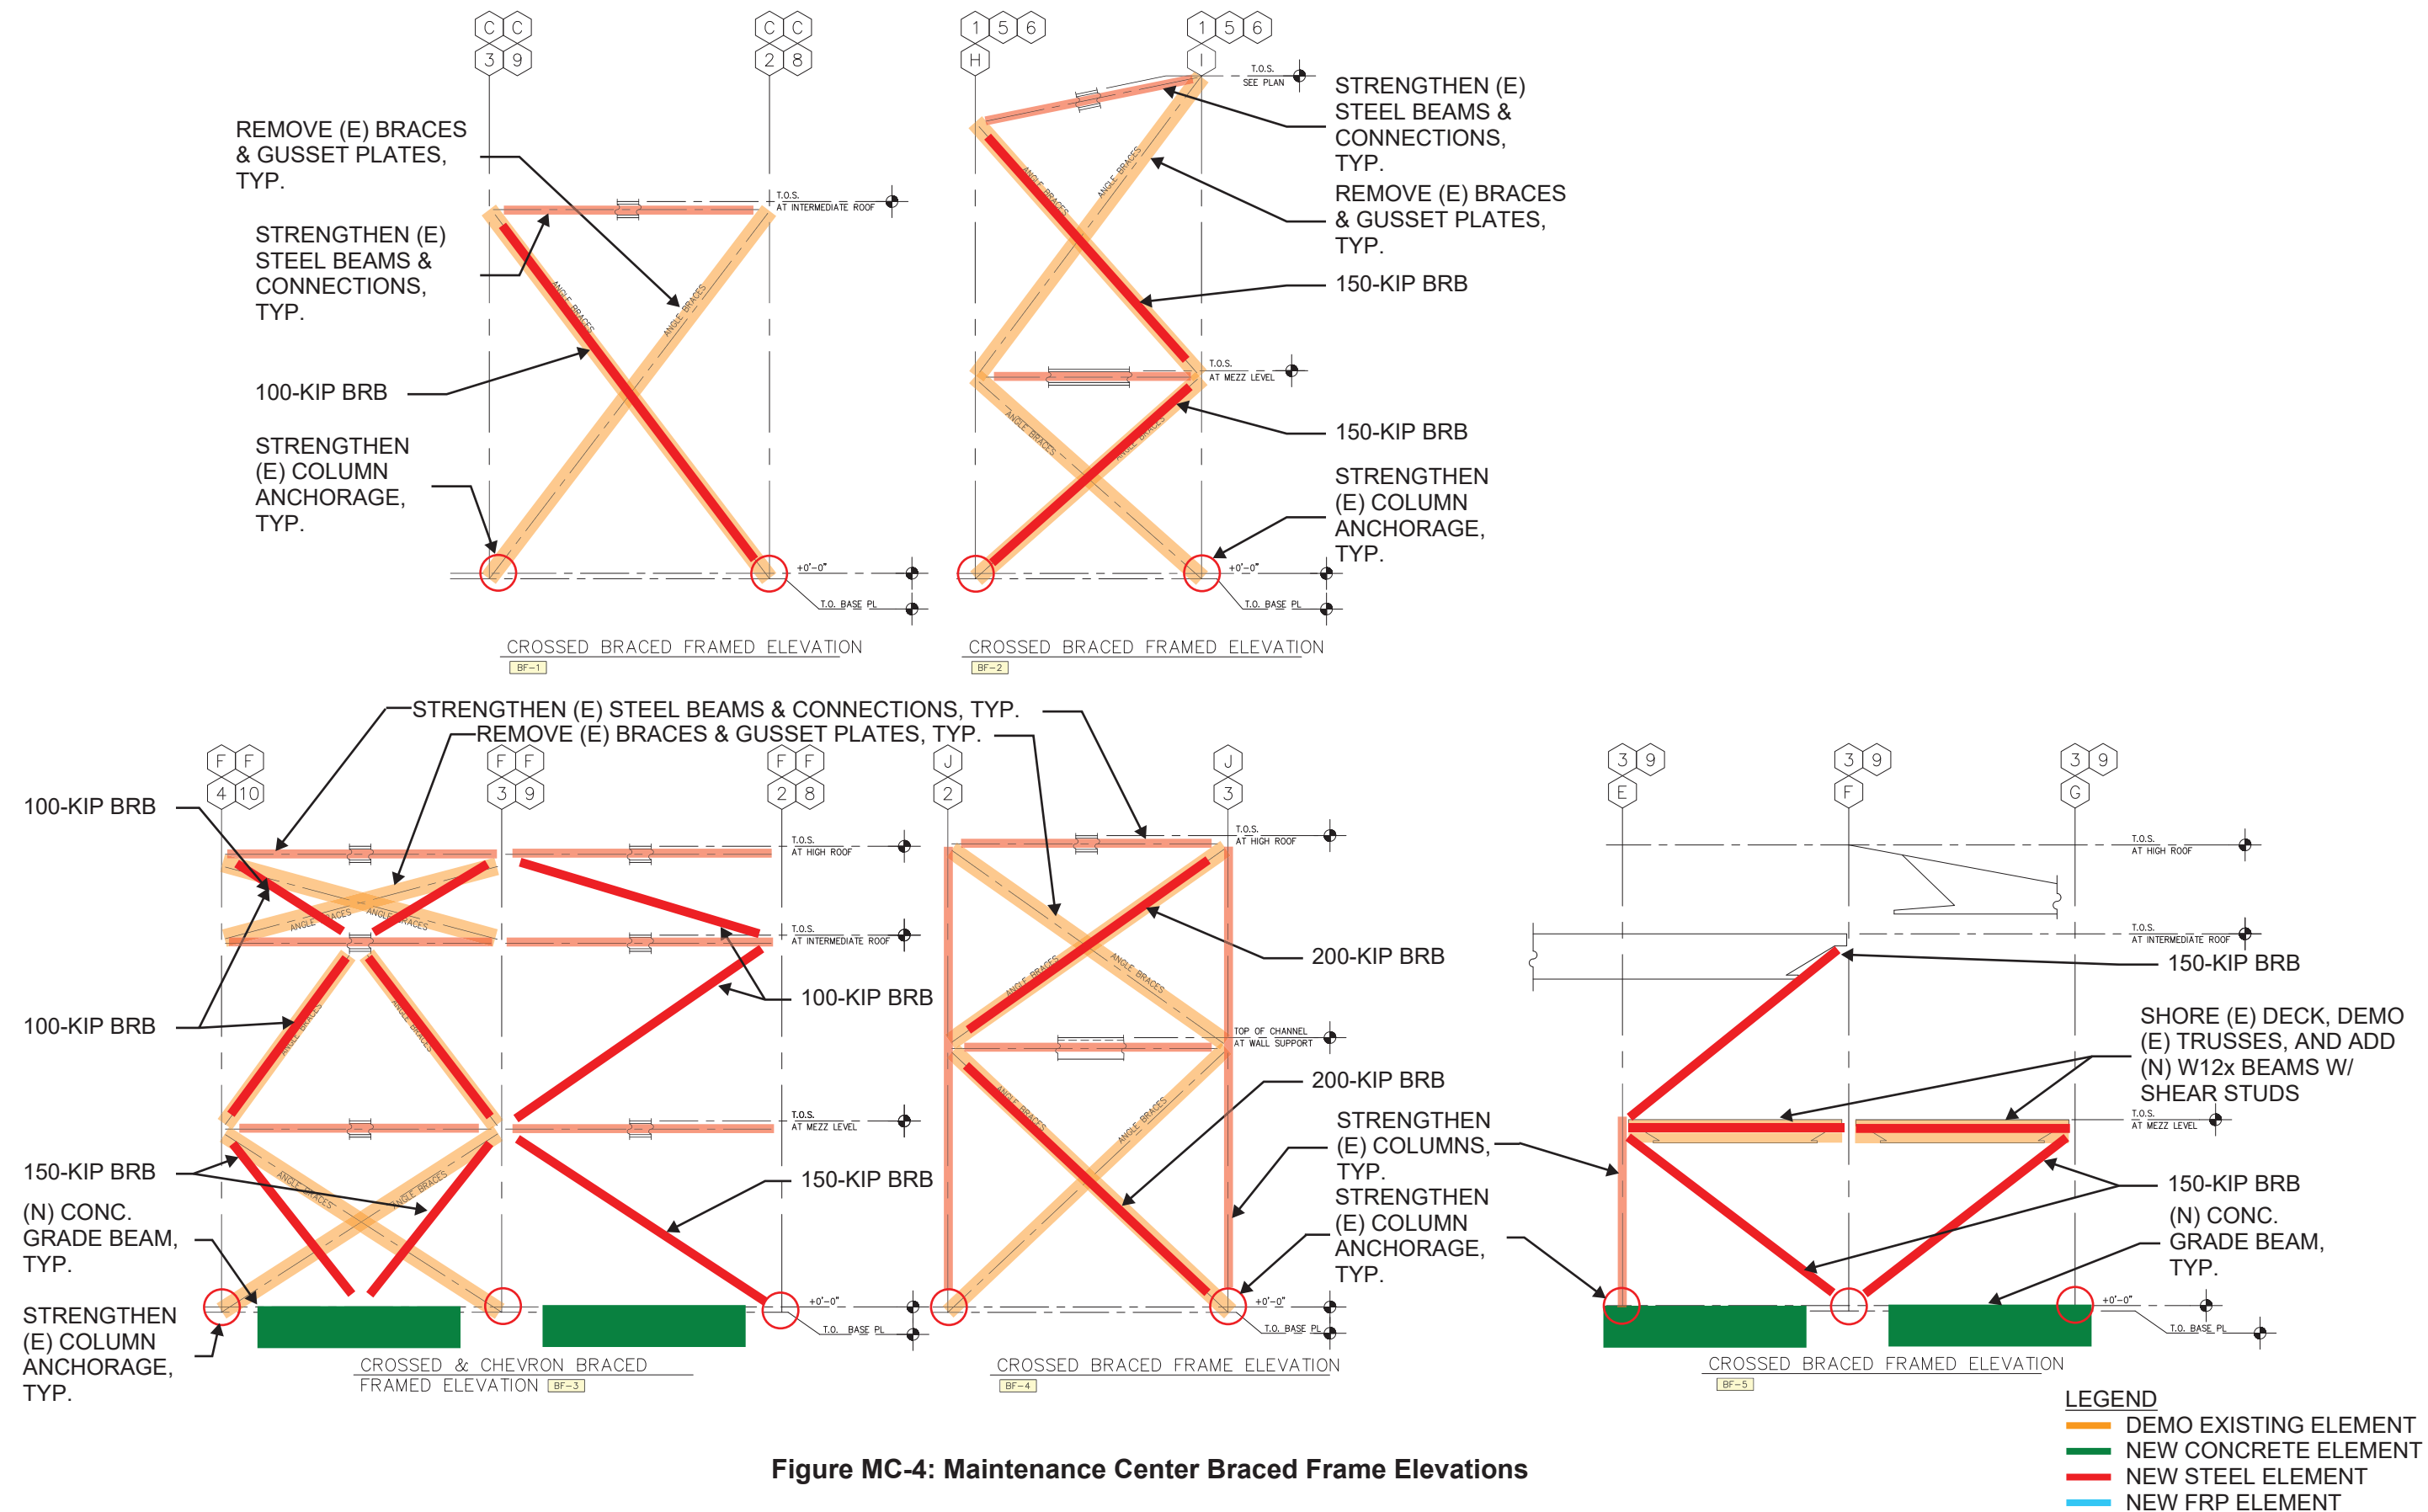


Figure MC-4: Maintenance Center Braced Frame Elevations

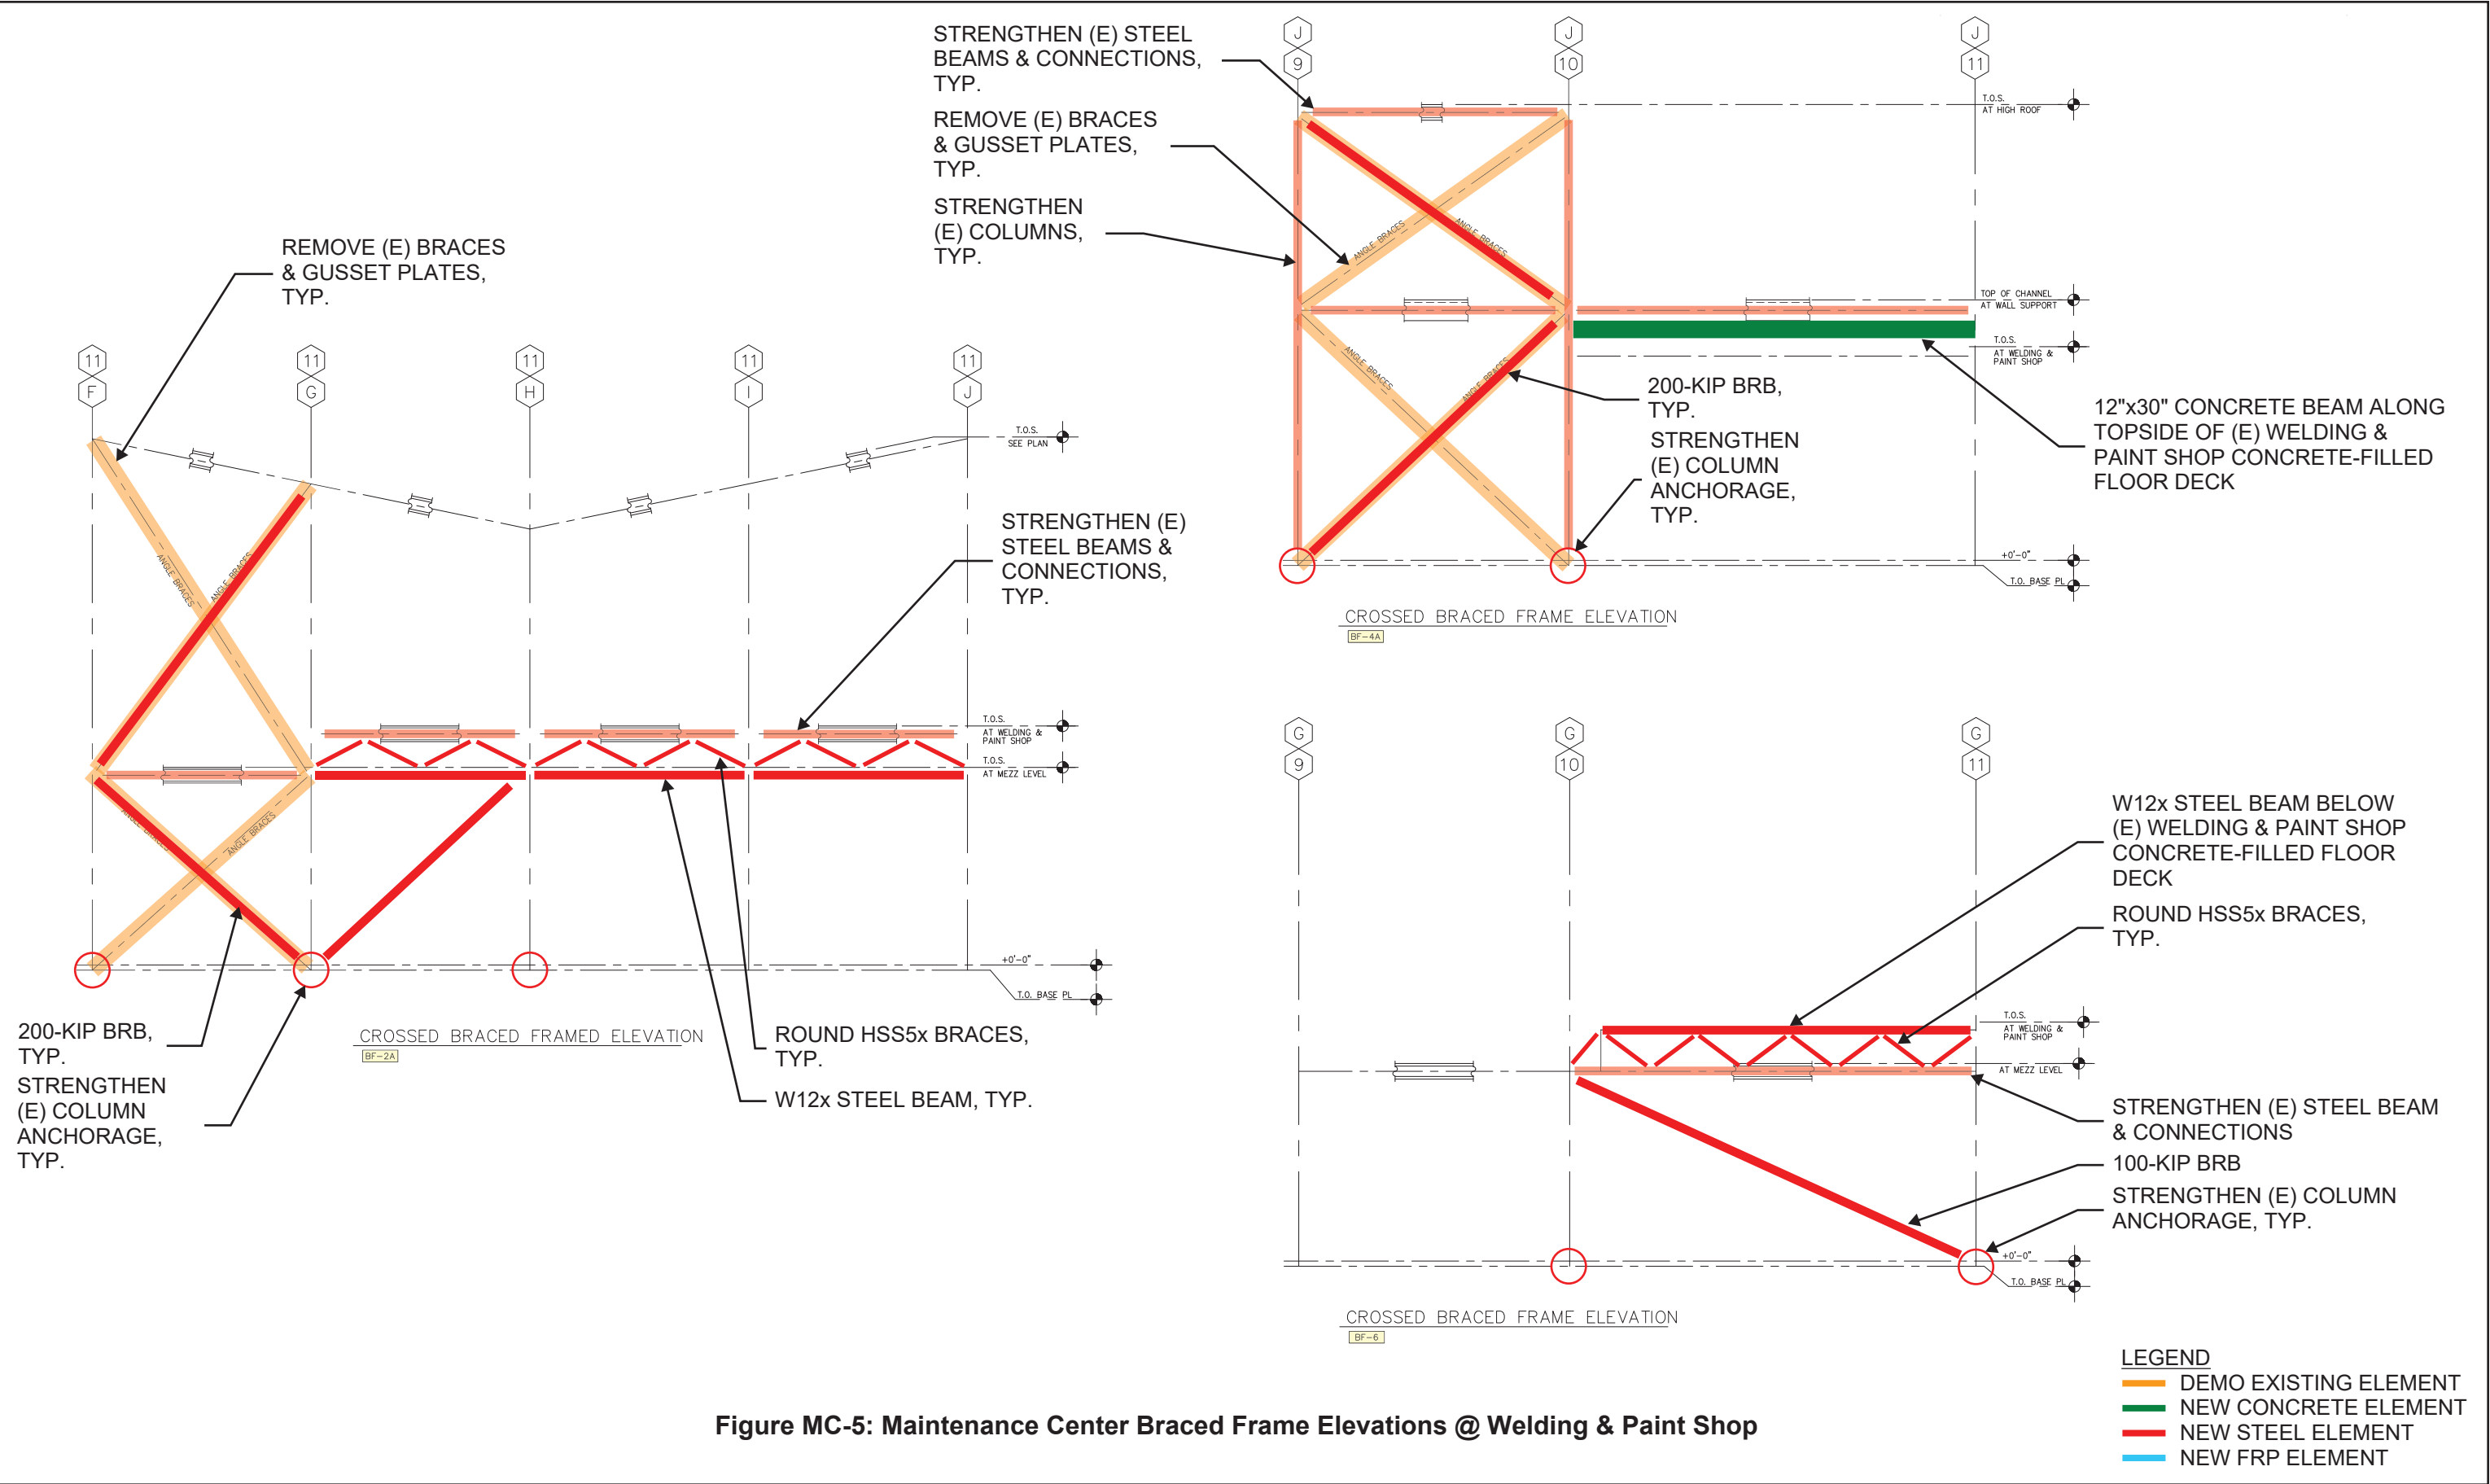


Figure MC-5: Maintenance Center Braced Frame Elevations @ Welding & Paint Shop

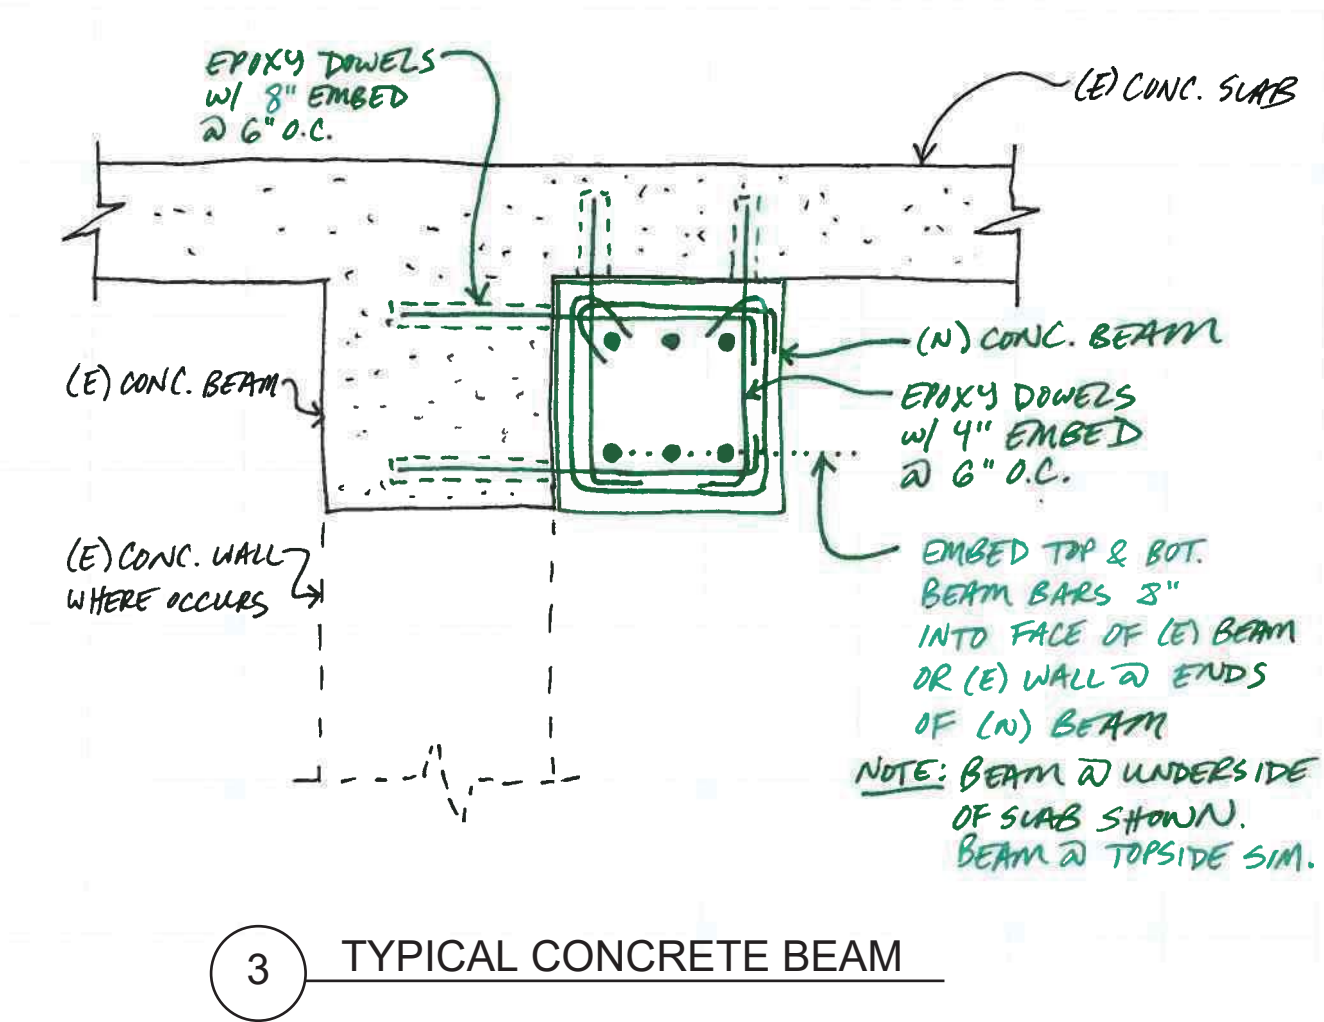


Figure T-1: Typical Detail










Maintenance Canopy

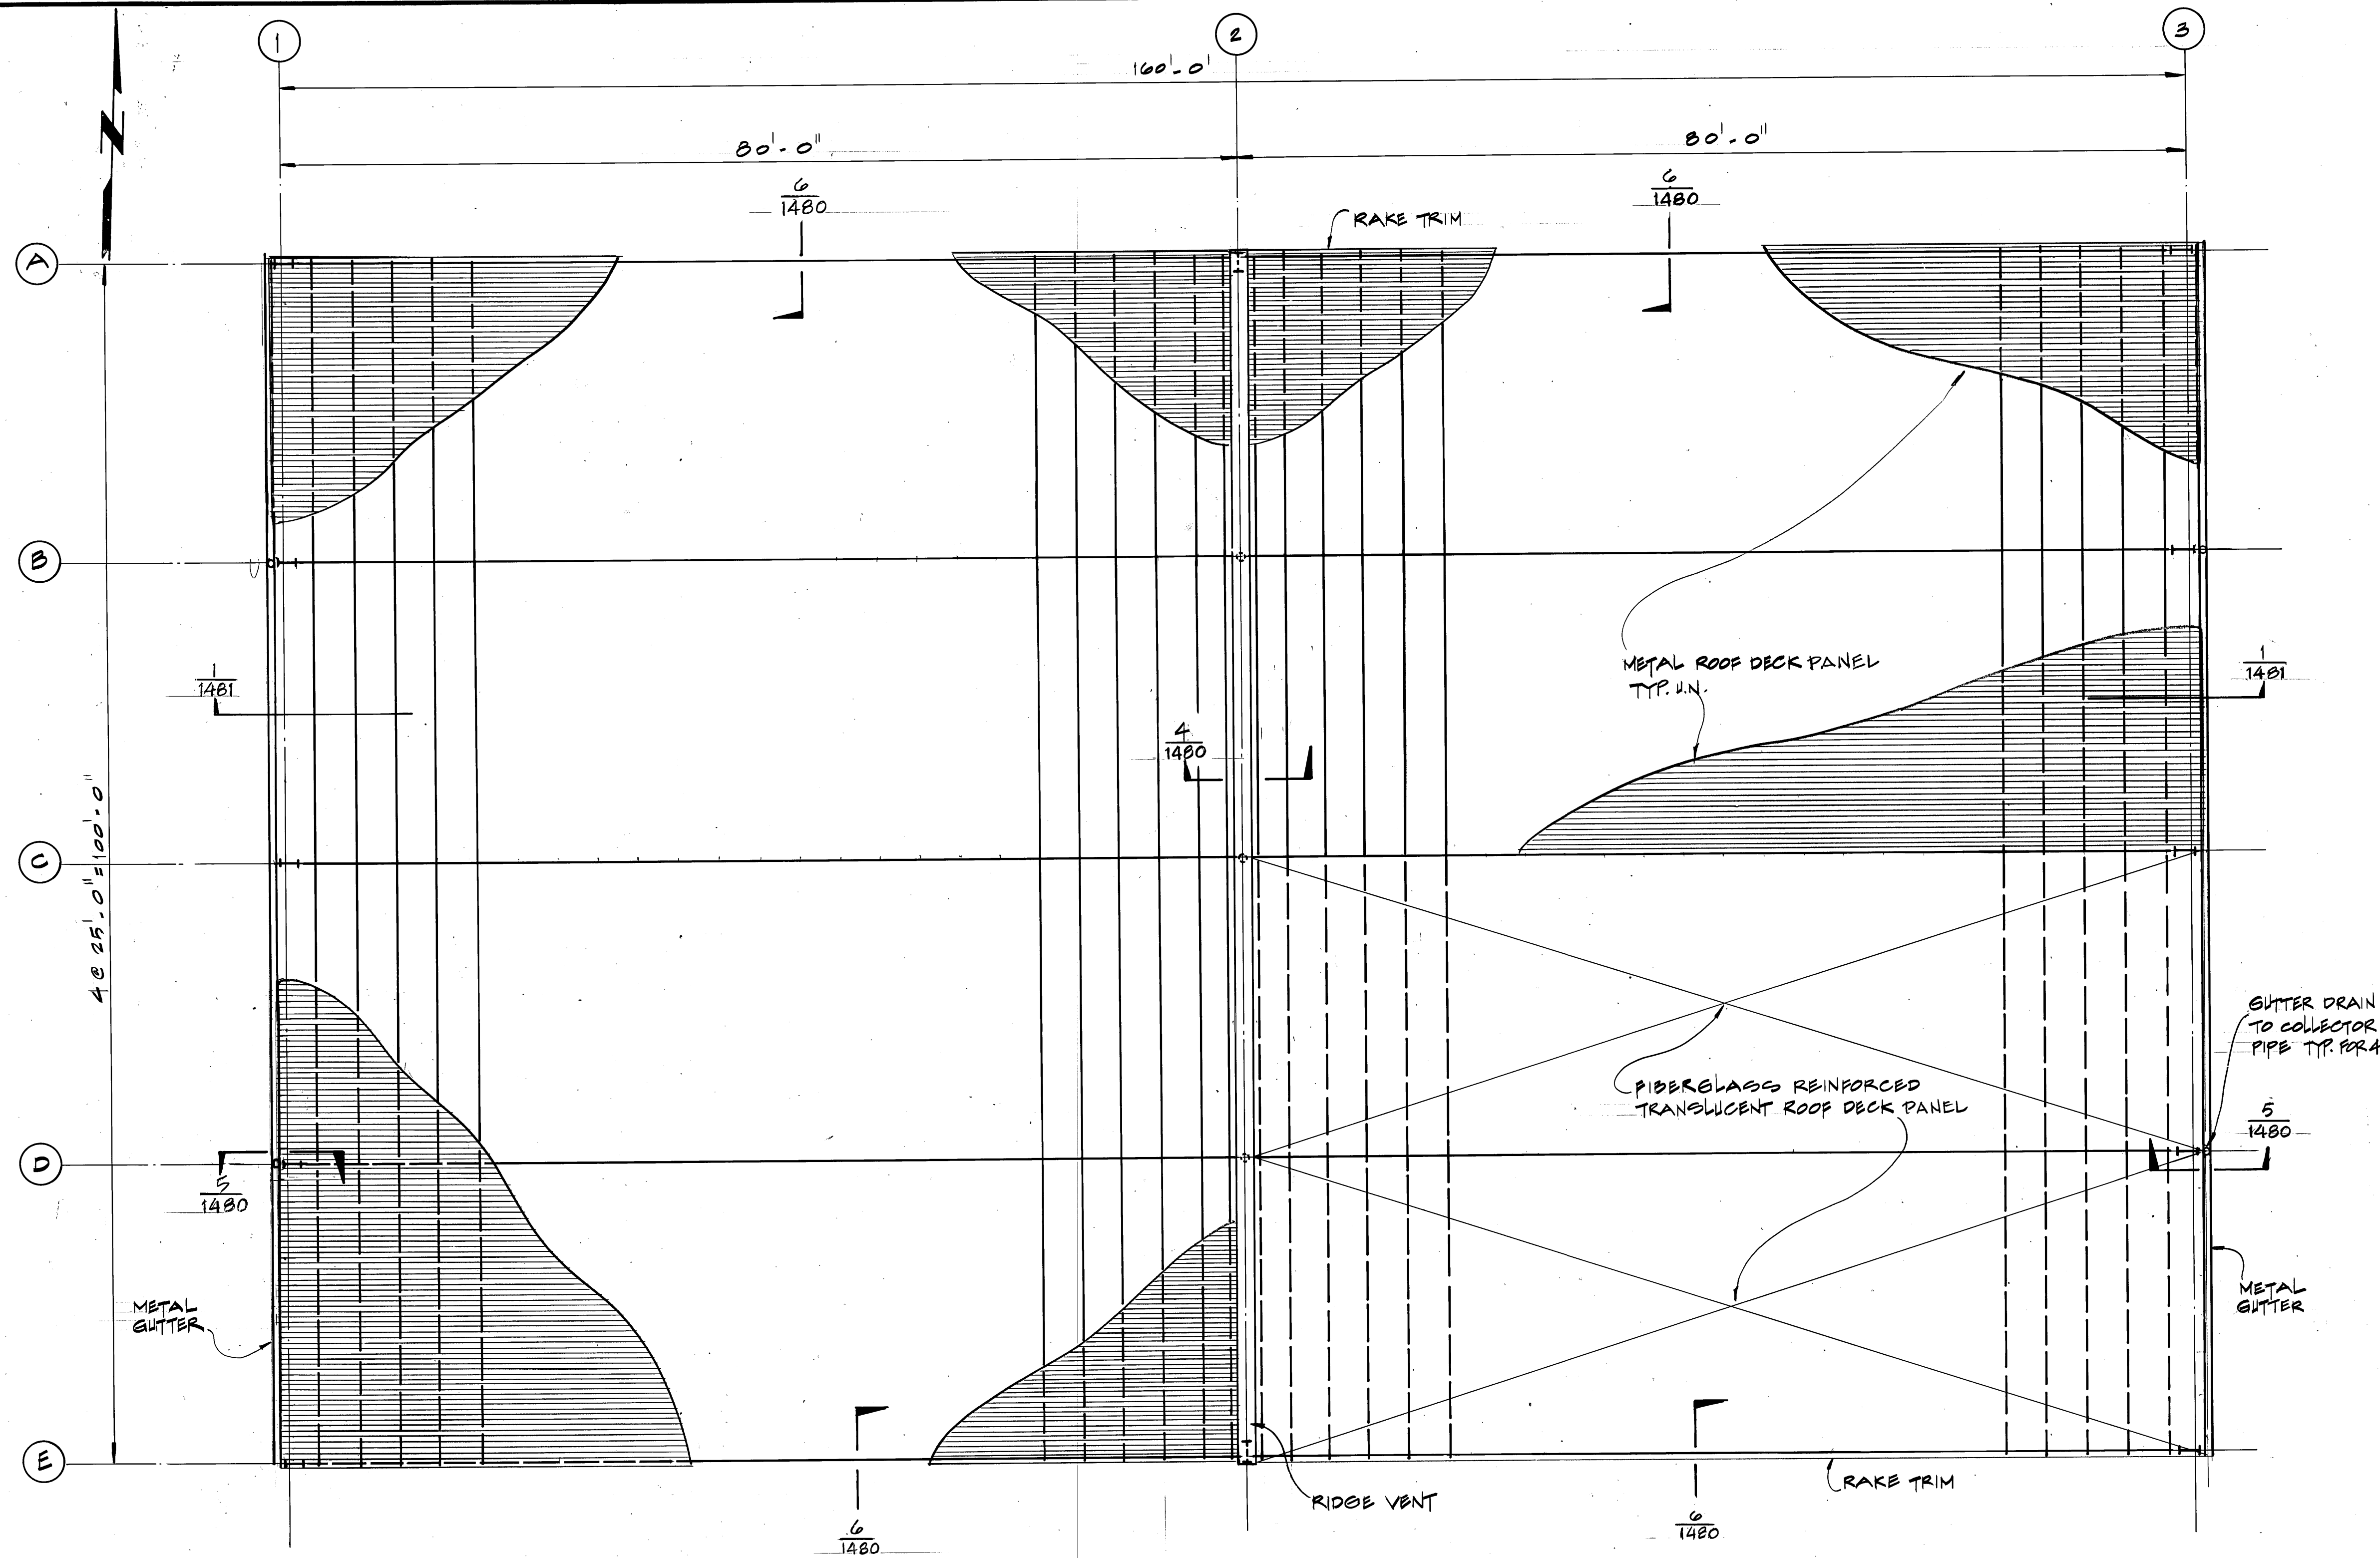

ROOF FRAMING PLAN

1/8" = 1'-0"

(CONTINUED FROM SHT. VG1478)

1.3 SAFETY. JOBSITE SAFETY IS THE SOLE RESPONSIBILITY OF THE CONTRACTOR. SITE REVIEW OF THE CONSTRUCTION BY THE ENGINEER IS TO DETERMINE CONFORMANCE WITH THE PLANS AND SPECIFICATIONS ONLY.

1.4 SHOP DRAWINGS. COMPLETE DETAILS OF ALL COMPONENTS OF PREFABRICATED METAL BUILDING SHALL BE SUBMITTED PRIOR TO CONSTRUCTION FOR REVIEW BY THE ENGINEER. EACH PART SHALL BE LEGIBLY MARKED TO CORRESPOND TO ERECTION DRAWINGS. ONCE REVIEWED AND APPROVED, NO CHANGES OR DEVIATIONS FROM THE SHOP DRAWINGS WILL BE PERMITTED WITHOUT THE APPROVAL OF THE ENGINEER.

2.0 MATERIALS.

2.1 STEEL FRAMEWORK. STEEL FRAMEWORK SHALL BE IN ACCORDANCE WITH THE AISC STEEL CONSTRUCTION MANUAL. STEEL FRAMING LESS THAN 3/16-INCH THICK SHALL MEET THE REQUIREMENTS OF THE AISI LIGHT GAUGE STEEL DESIGN SPECIFICATION.

2.2 SIDING AND ROOFING. SIDING AND ROOFING PANELS SHALL, AS FAR AS PRACTICAL, BE ONE TYPE AND USED THROUGHOUT THE PROJECT. THE MINIMUM THICKNESS OF STEEL SHALL BE 24 GAUGE.

2.3 FASTENERS. FASTENERS FOR ATTACHMENT OF PANELS TO STRUCTURAL SUPPORTS SHALL BE SELF-TAPPING STAINLESS STEEL SHEET METAL SCREWS. ALL FASTENERS SHALL HAVE POLYMERIZED CHLOROPRENE WASHERS.

2.4 SHEET METAL ACCESSORIES. SHEET METAL ACCESSORIES INCLUDING GUTTERS, DOWNSPOUTS, VENTILATORS, AND TRIM SHALL BE ZINC-COATED SHEET STEEL WITH FACTORY APPLIED PAINT FINISH.

2.4.1 GUTTERS AND DOWNSPOUTS SHALL BE SIZED TO ACCOMMODATE A RAINFALL OF 0.5 in./hr. GUTTERS SHALL BE FORMED IN SECTIONS NOT LESS THAN 8 FEET AND SHALL BE SUPPORTED AT NOT MORE THAN 36 INCHES ON CENTER. DOWNSPOUTS SHALL BE PROVIDED IN APPROXIMATELY 10-FOOT LENGTHS AND SHALL BE SUPPORTED AT A MAXIMUM SPACING OF 60 INCHES ON CENTER.

2.4.2 CONTINUOUS GRAVITY (RIDGE) ROOF VENTILATORS SHALL BE FABRICATED FROM ZINC-COATED STEEL NOT LESS THAN 26 GAUGE IN THICKNESS. VENTILATORS SHALL BE PROVIDED COMPLETE WITH EXTERIOR WINDBAND, INTEGRAL RAIN CONE, BRACES, CHAIN OPERATED DAMPERS, AND BIRD SCREENING. THROAT SIZE (VENT OPENING) SHALL BE NOT LESS THAN 9 INCHES.

2.4.3 CLOSURE STRIPS SHALL BE FORMED OF COMPRESSED RUBBER OR OTHER MATERIAL THAT IS STANDARD WITH THE MANUFACTURER. CLOSURE STRIPS SHALL NOT ABSORB WATER AND SHALL MATCH THE CONFIGURATIONS OF THE ROOFING AND SIDING PANELS.

2.4.4 ALL SIDE AND END LAPS SHALL BE SEALED WITH TYPE II, CLASS B RIBBON FORM SEALANT CONFORMING TO FED. SPEC. TT-C-1796. MINIMUM WIDTH OF RIBBON SHALL BE 3/32 x 1/2 INCH.

2.5 PAINT. PRIOR TO FABRICATION THE ENGINEER SHALL NOTIFY THE CONTRACTOR OF THE COLOR OF SIDING AND ROOFING PANELS. ENGINEER WILL CHOOSE COLOR FROM THE STANDARD LIST OF COLORS OFFERED BY THE METAL BUILDING MANUFACTURER. STRUCTURAL STEEL SHALL BE PRIMED ONLY.

3.0 ERECTION.

3.1 GENERAL. CONCRETE FOUNDATIONS SHALL BE LEVEL AND TRUE, AND SHALL BE INSPECTED AND APPROVED BEFORE THE STRUCTURAL STEEL WORK IS STARTED. ANCHOR BOLTS SHALL BE INSTALLED WHILE THE CONCRETE WORK IS IN PROGRESS; TEMPLATES OR OTHER GAUGING DEVICES SHALL BE USED TO ASSURE ACCURATE SPACING OF THE ANCHOR BOLTS. COLUMNS, RIGID FRAMES, AND WALLS OF SELF-FRAMING BUILDINGS SHALL BE PLUMBED IN BOTH DIRECTIONS, GUYED AND STAYED, AND ALL FRAMING ELEMENTS SHALL BE ACCURATELY SPACED TO ASSURE THE PROPER FITTING OF PREFABRICATED WALL AND ROOF COVERINGS.

3.2 RIGID FRAMES AND COLUMN BASES. RIGID FRAMES AND COLUMN BASES SHALL BE SET ACCURATELY, USING A NONSHRINKING GROUTING MORTAR TO OBTAIN UNIFORM BEARING ON THE CONCRETE AND TO MAINTAIN A LEVEL BASE LINE ELEVATION. ANCHORS AND ANCHOR BOLTS FOR SECURING RIGID FRAMES, COLUMNS, OR STILL MEMBERS TO FOUNDATIONS SHALL BE STEEL, UNPAINTED, SET ACCURATELY TO TEMPLATES, AND OF PROPER SIZE TO ADEQUATELY RESIST ALL APPLICABLE DESIGN LOADS AT THE BASE.

3.3 WALL CONSTRUCTION. ALL SHEETS OR PANELS SHALL BE APPLIED WITH THE CORRUGATIONS IN A VERTICAL POSITION. SHEETS OR PANELS SHALL BE SUPPLIED IN THE LONGEST OBTAINABLE LENGTHS. ALL SIDE AND END LAPS SHALL BE SEALED WITH THE JOINT SEALING MATERIAL SPECIFIED HEREIN. ALL WALLS SHALL BE FLASHED AND/OR SEALED AT THE TOP.

3.4 ROOF CONSTRUCTION. ALL ROOFING PANELS SHALL BE APPLIED WITH CORRUGATIONS PARALLEL TO THE SLOPE OF THE ROOF. THE ROOFING PANELS SHALL BE APPLIED IN THE LONGEST LENGTHS OBTAINABLE WITH END LAPS OCCURRING ONLY AT STRUCTURAL MEMBERS. ALL SIDE AND END LAPS SHALL BE SEALED AS WELL AS THE ROOF VENT, EAVES, AND RAKES.



EAST BAY MUNICIPAL UTILITY DISTRICT
OAKLAND, CALIFORNIA

COMPOST DRYING FACILITY

ROOF FRAMING PLAN &
GENERAL NOTES

STRUCTURE OR
ZONE DESIGNATION

SCALE AS SHOWN

DATE 5-23-84

VG 1479



NO.	DATE	REVISION	BY	APP.
1	7/85	AS-BUILT		



Black & Veatch
Consulting Engineers
Walnut Creek, California

DESIGN BY	F. SENA
DESIGN CHECK BY	F. SENA
DRAWN BY	W.K. LUK
SR. PROJ. ENGR.	
APPROVED	Frederick Serna
PRINCIPAL-IN-CHARGE RPE NO.	61632

PROJECT ENGR.	J.P. Serna
MGR. SUPPORT SVCS.	B.M. Serna
MANAGER WASTEWATER DEPT.	Walter J. Bishop

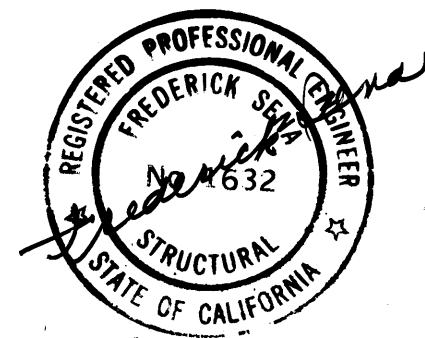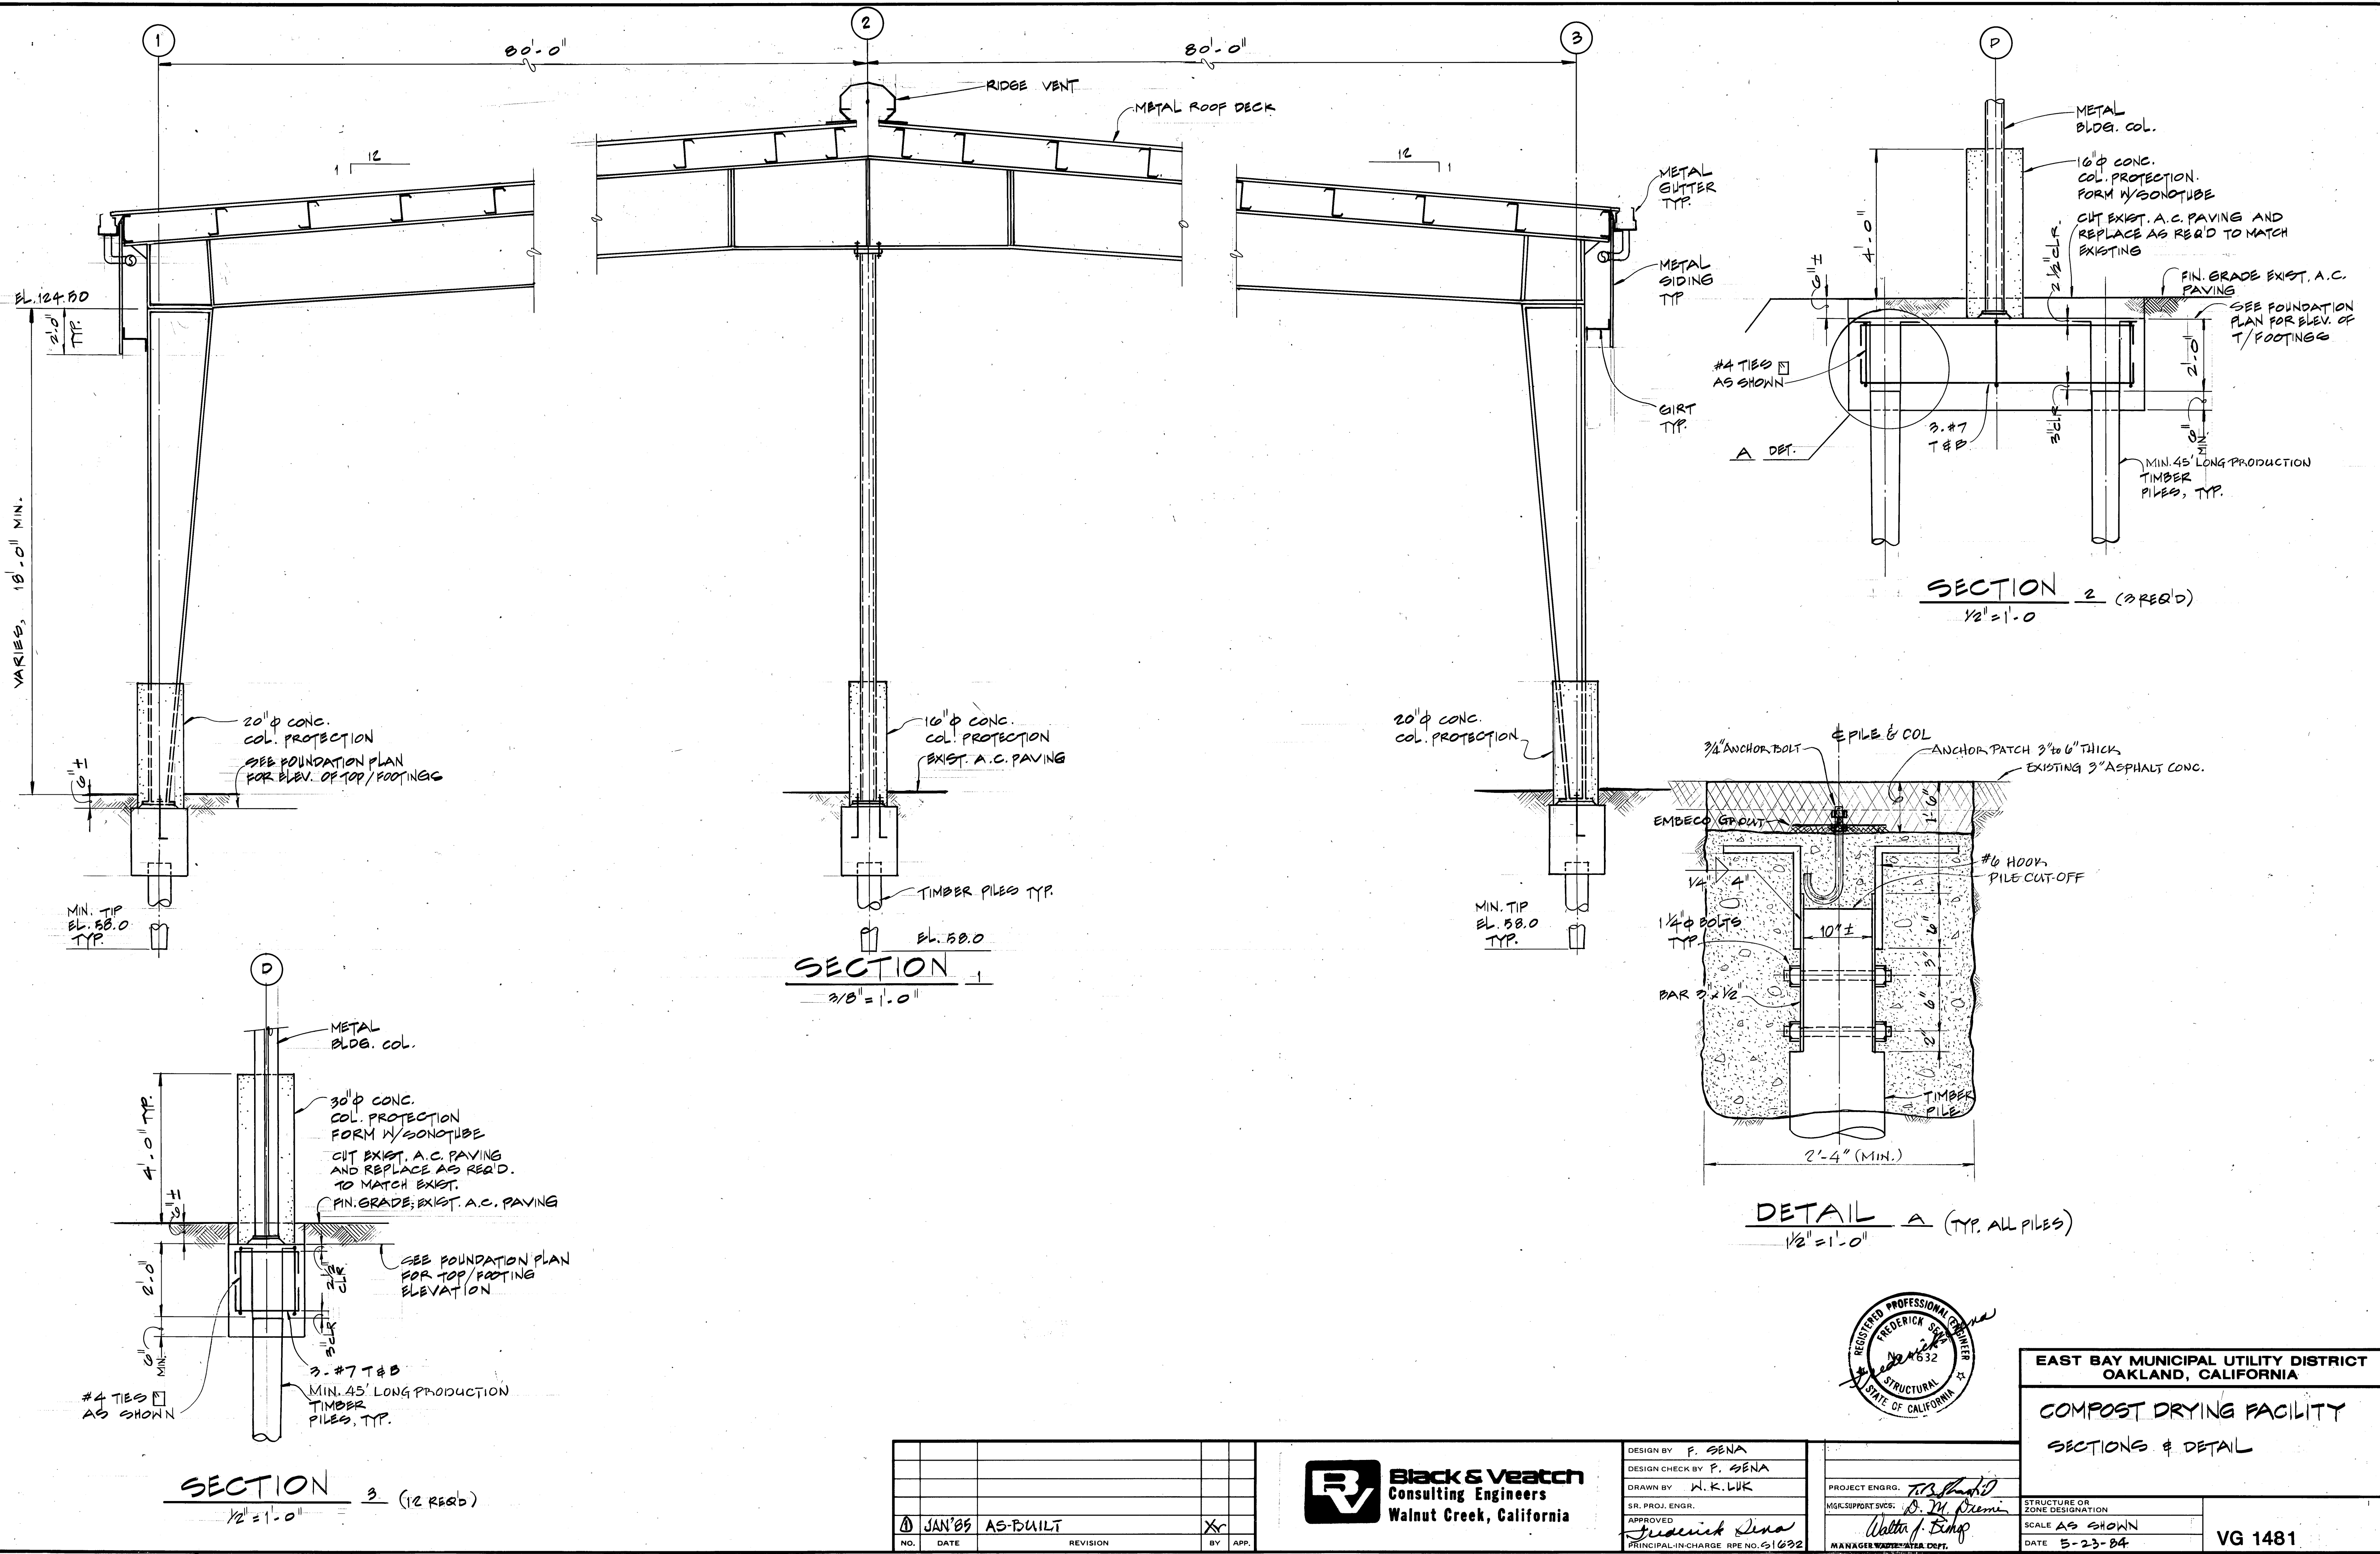




EAST BAY MUNICIPAL UTILITY DISTRICT OAKLAND, CALIFORNIA	
COMPOST DRYING FACILITY	
SECTIONS & DETAIL	
STRUCTURE OR ZONE DESIGNATION	SCALE AS SHOWN
DATE 5-23-84	VG 1481

Black & Veatch
Consulting Engineers
Walnut Creek, California

DESIGN BY F. SINA
DESIGN CHECK BY F. SINA
DRAWN BY W. K. LUK
SR. PROJ. ENGR.
APPROVED Frederick Sina
PRINCIPAL-IN-CHARGE RPE NO. 51632


PROJECT ENGR. F. Sina
MGR. SUPPORT SVCS. D. M. Premi
MANAGER WATER DEPT. Walter J. Bump

NO.	DATE	REVISION	BY	APP.
1	JAN '85	AS-BUILT	Xr	

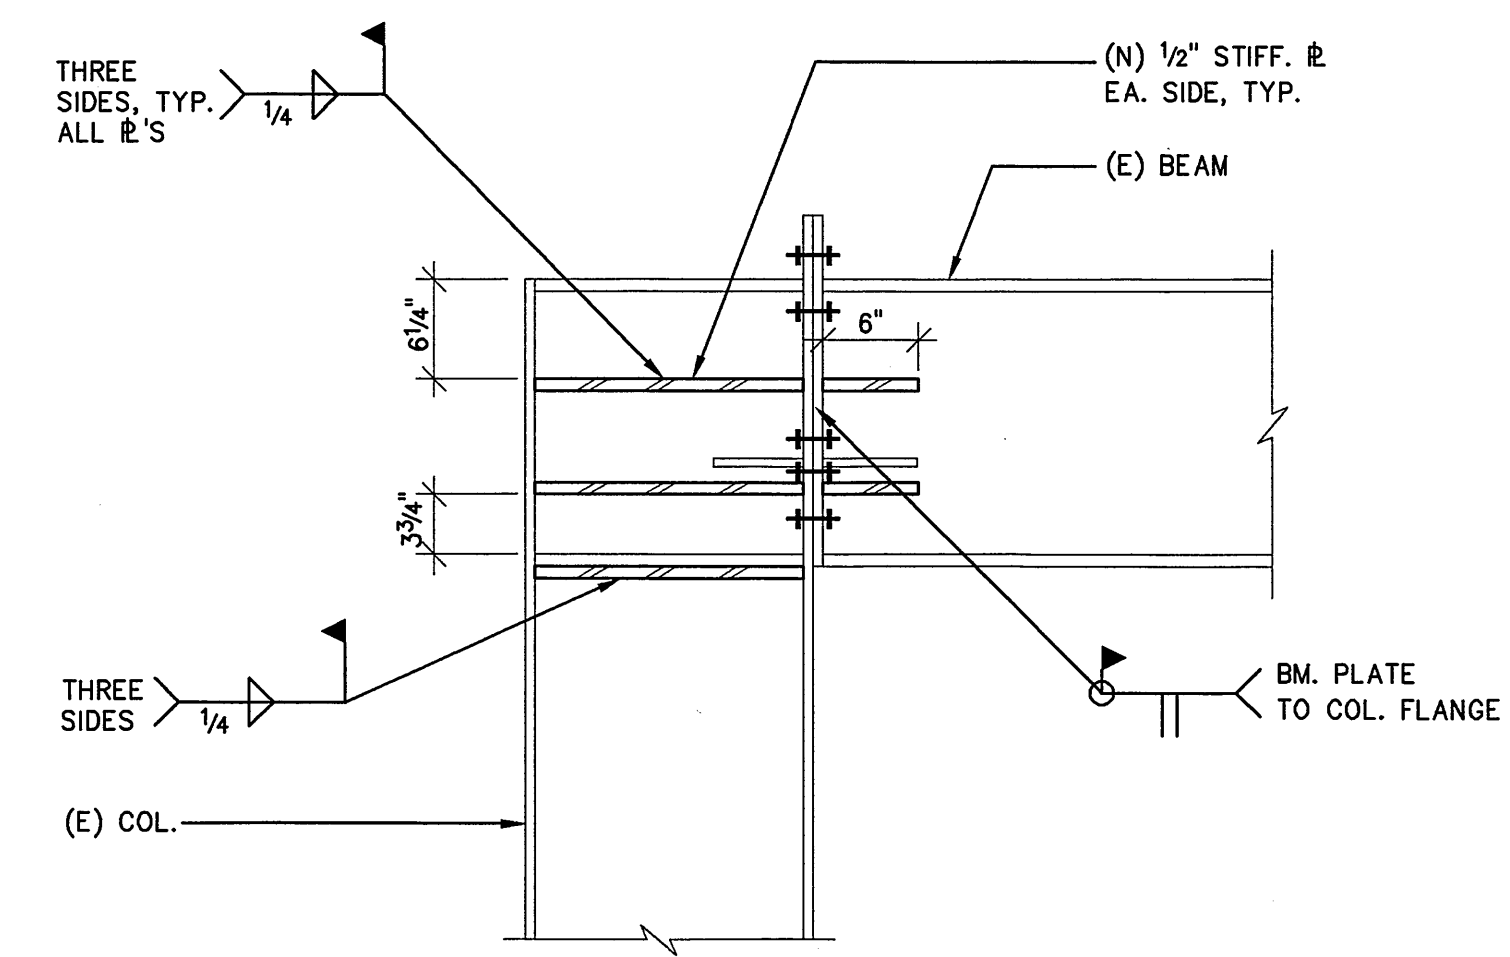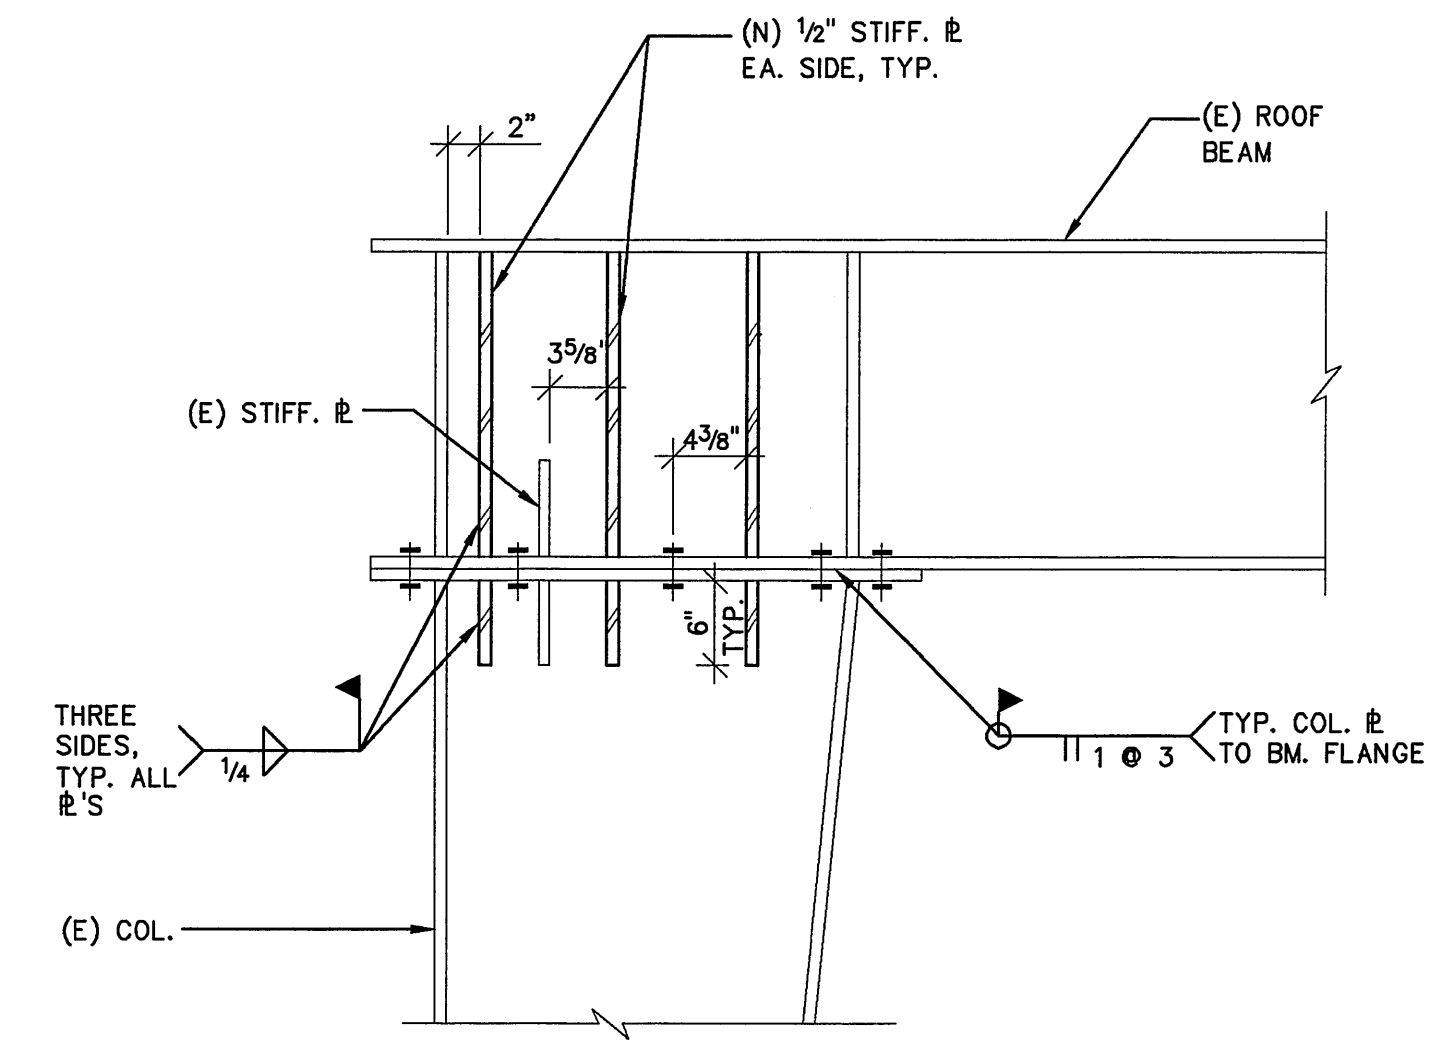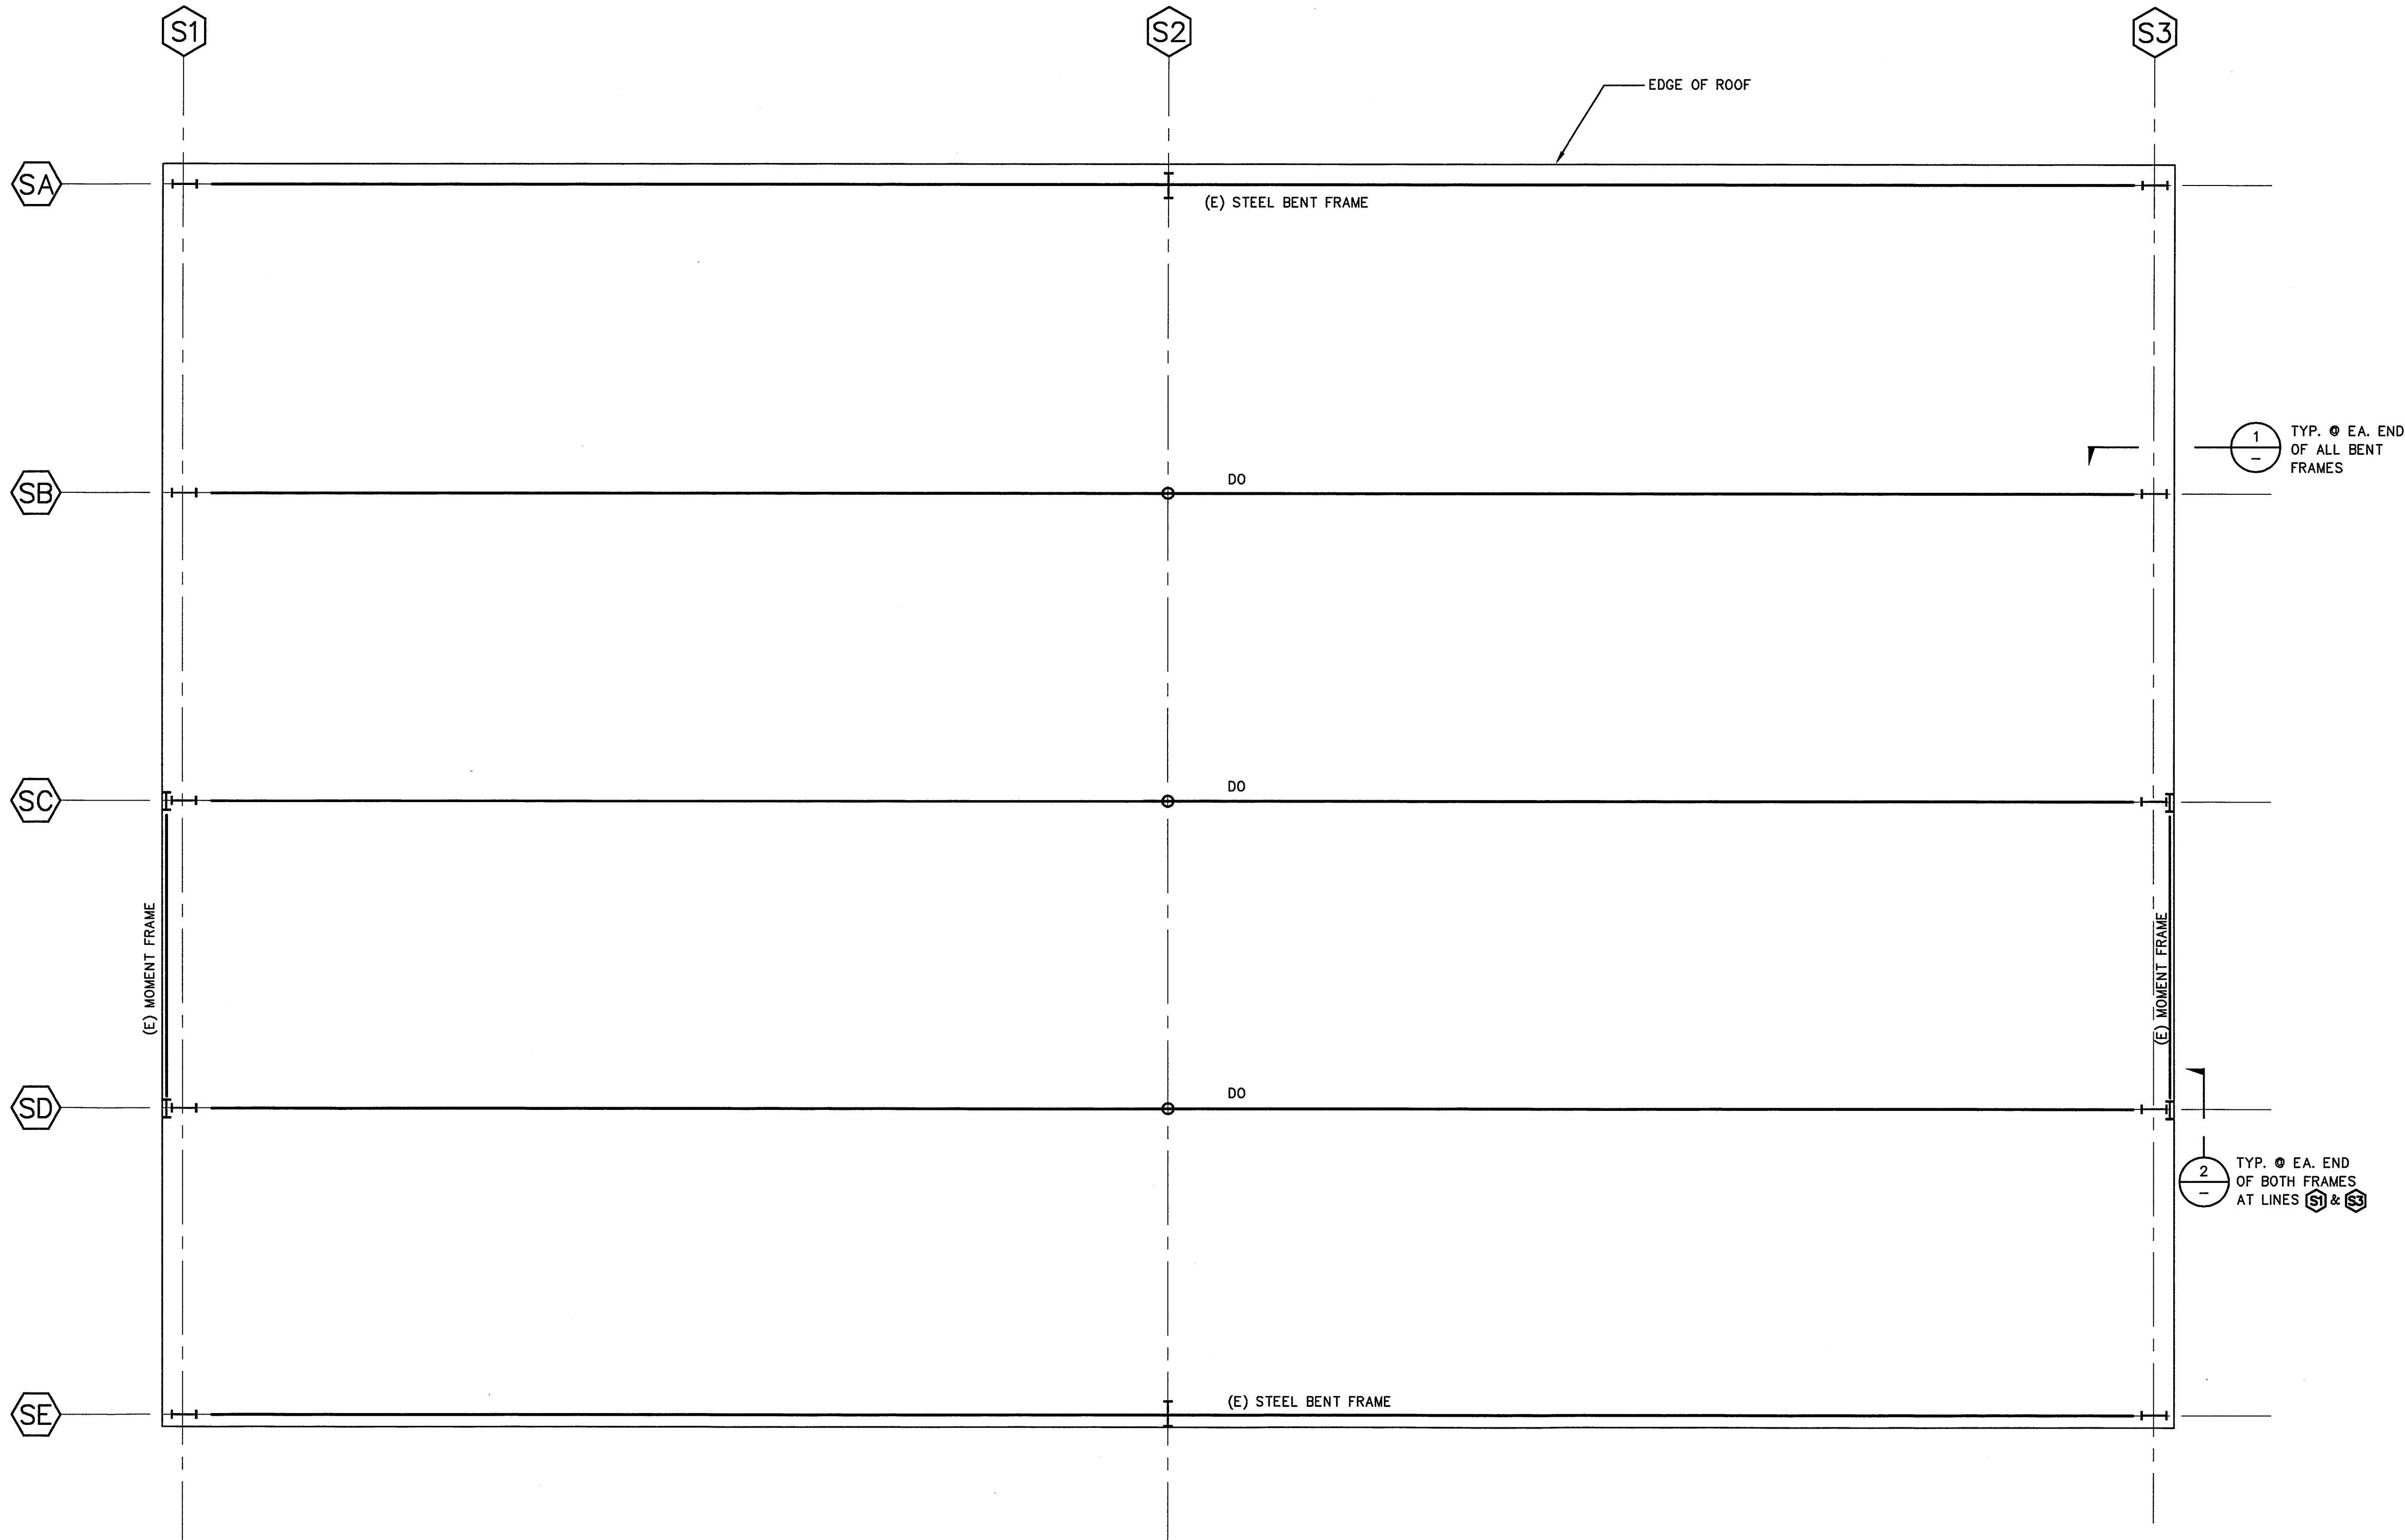

ROOF FRAMING NOTES

- SEE GENERAL NOTES ON SHEET S1.1.
- EXISTING CONSTRUCTION SHOWN ON THESE DRAWINGS WAS OBTAINED FROM EXISTING CONSTRUCTION DOCUMENTS AND SITE INVESTIGATION. THE CONTRACTOR SHALL VERIFY ALL EXISTING JOB CONDITIONS, REVIEW ALL DRAWINGS AND VERIFY DIMENSIONS PRIOR TO CONSTRUCTION. THE CONTRACTOR SHALL NOTIFY THE ARCHITECT OF ALL DISCREPANCIES AND EXCEPTIONS BEFORE PROCEEDING WITH THE WORK.
- THE REMOVAL, CUTTING, DRILLING, ETC. OF EXISTING WORK SHALL BE PERFORMED WITH GREAT CARE AND SMALL TOOLS IN ORDER NOT TO JEOPARDIZE THE STRUCTURAL INTEGRITY OF THE BUILDING. IF STRUCTURAL MEMBERS OR MECHANICAL, ELECTRICAL, OR ARCHITECTURAL FEATURES NOT INDICATED FOR REMOVAL INTERFERE WITH THE NEW WORK, THE ARCHITECT SHALL BE IMMEDIATELY NOTIFIED AND PRIOR APPROVAL SHALL BE OBTAINED BEFORE REMOVAL OF MEMBERS.
- THE CONTRACTOR SHALL SAFELY SHORE EXISTING CONSTRUCTION WHEREVER EXISTING SUPPORTS ARE REMOVED TO ALLOW THE INSTALLATION OF THE NEW WORK. ALL SHORING METHODS AND SEQUENCING OF DEMOLITION SHALL BE SPECIFIED BY A LICENSED STRUCTURAL ENGINEER TO BE RETAINED BY THE CONTRACTOR. SEE SPECIFICATIONS FOR DETAILED REQUIREMENTS.
- THE CONTRACTOR SHALL VERIFY THE LOCATION OF EXISTING UTILITIES BEFORE BEGINNING WORK. SPECIAL CARE SHALL BE TAKEN TO PROTECT UTILITIES THAT ARE TO REMAIN IN SERVICE DURING CONSTRUCTION.
- THE CONTRACTOR SHALL PROMPTLY REPAIR DAMAGE CAUSED DURING OPERATIONS WITH SIMILAR MATERIALS AND WORKMANSHIP.

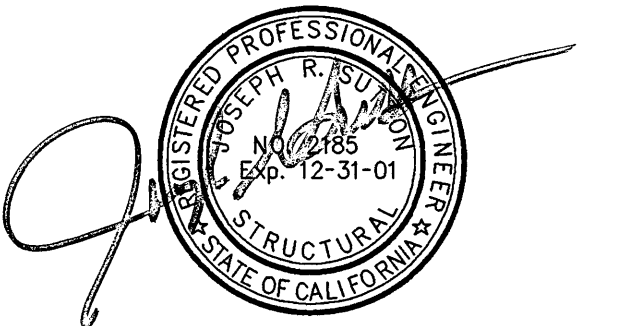

100% SUBMITTAL

IF THIS SHEET IS LESS THAN 30" X 42", IT IS A REDUCED PRINT SCALE ACCORDINGLY

EAST BAY MUNICIPAL UTILITY DISTRICT
SPECIAL DISTRICT No. 1
OAKLAND, CALIFORNIA


MAINTENANCE FACILITY SD 223
WASTE WATER TREATMENT PLANT
TRA PROJECT NO. 96007.02

ROOF FRAMING PLAN/DETAILS
EXISTING SHED

FACTORY
SCALE SEE PLAN
DATE 23 MAR. 1998

DRAWING No. **S2.5**
SHEET OF

SPECIFICATION NO.

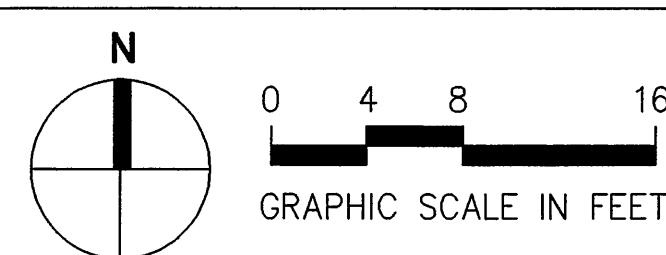

DASSE DESIGN INC.
STRUCTURAL ENGINEERS
22 New Montgomery St., Suite 500
Oakland, CA 94612
415/291-9900 • Fax 415/291-9905

The Ratcliff Architects
8400 DOWLE STREET
EMERYVILLE, CA 94608
(916) 655-1972

DESIGNED BY	JOW
DESIGN CHECKED BY	JOW
DRAWN BY	DMY/ATC
SR. PROJ. ENGR.	JOW
APPROVED	
PRINCIPAL-IN-CHARGE, R.P.E. NO.C	

PROJECT MGR.	R.P.E. NO.
PROJECT SUPERVISOR	R.P.E. NO.

NO.	DATE	REVISION	BY	REC.	APP.
1	3/20/98	EBMUD/PLAN CHECK COMMENT	JOW		

Old Compost Storage Facility / Maintenance Shed

Year Built: 1985

Build Code Designed: 1982 UBC

Build Code Used for Evaluation: 2007 CBC and ASCE 7-05

Description: The building is a pre-engineered, steel building. It is a one-story, open frame canopy structure having approximate dimensions of 160 feet long, 100 feet wide and 25 feet high. The total area of this building is about 16,000 square feet.

The lateral-loads of the building are resisted by rigid frames that are spaced at 25 and 80 feet apart in the north-south and east-west directions, respectively.

The roof is a braced frame structure consisting of rigid frame beams, struts, purlins and bracings. The roof is covered by metal deck that may not be considered as part of lateral-load-resisting system.

The steel columns are supported on pile cap that are founded on 16-ton timber piles.

See Figures B-1 to B-3 (attached).

Findings

Both wind and seismic loads required by the current CBC are significantly higher than that used in the original design. This is due to new force equations, increases in values of several design parameters, and more stringent combined load effects. The new design loads have caused a 50 to 75 percent increase of forces in the framing joints, columns, anchors, and connections of building attachments. The following structural elements are found to be deficient under the Code prescribed loads.

1. Joints in the rigid frames are overstressed under the Code prescribed loads.
2. Inadequate lateral resisting system in north-south direction.
3. Column base anchors do not have adequate shear and pull-out strengths due to insufficient connection with pile caps.
4. Roof tension rods appear to be inadequate to transfer loads to rigid frames.
5. Metal siding connections appear inadequate to withstand the code prescribed loads.

Recommended Retrofit Elements

1. Stiffen moment joints with knee bracings
2. Install a rigid frame or add bracings in existing framing in N-S direction along the center frame of building.
3. Install additional column base anchors by modifying existing base plate and connections.
4. Replace roof tension rods with larger rods and strengthen rod / frame connections.
5. Upgrade metal siding connection with additional metal fasteners and, if necessary, additional struts.











Fueling Station

SCHEDULE OF OPENINGS				
MARK	REQ'D	SIZE	TYPE	REMARKS
A	1	2"	MNPT	MONITOR
B	5	4"	MNPT	
C	7	2"	MNPT	
D	2	6"	MNPT	PRI. E-VENT
E	1	8"	MNPT	SEC. E-VENT


ESTIMATED TANK WEIGHT: 15,000 LBS

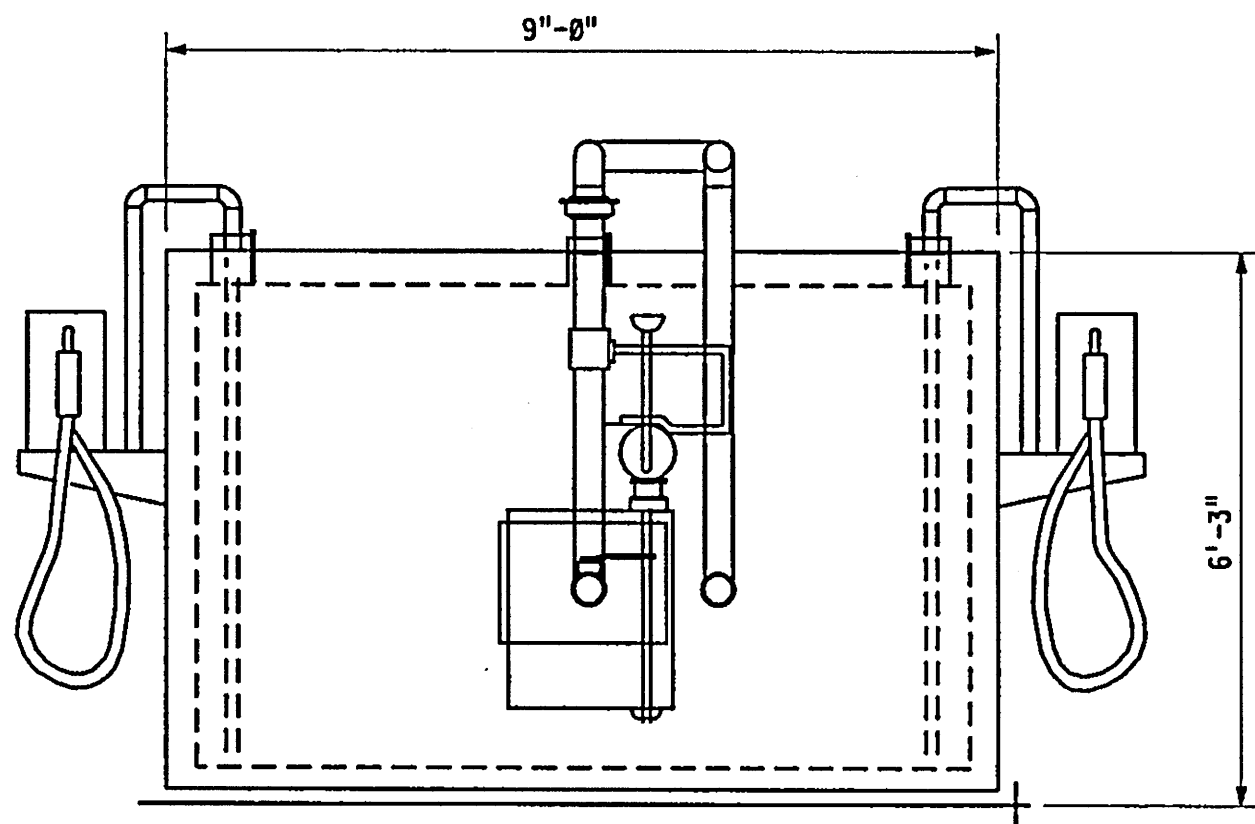

END VIEW

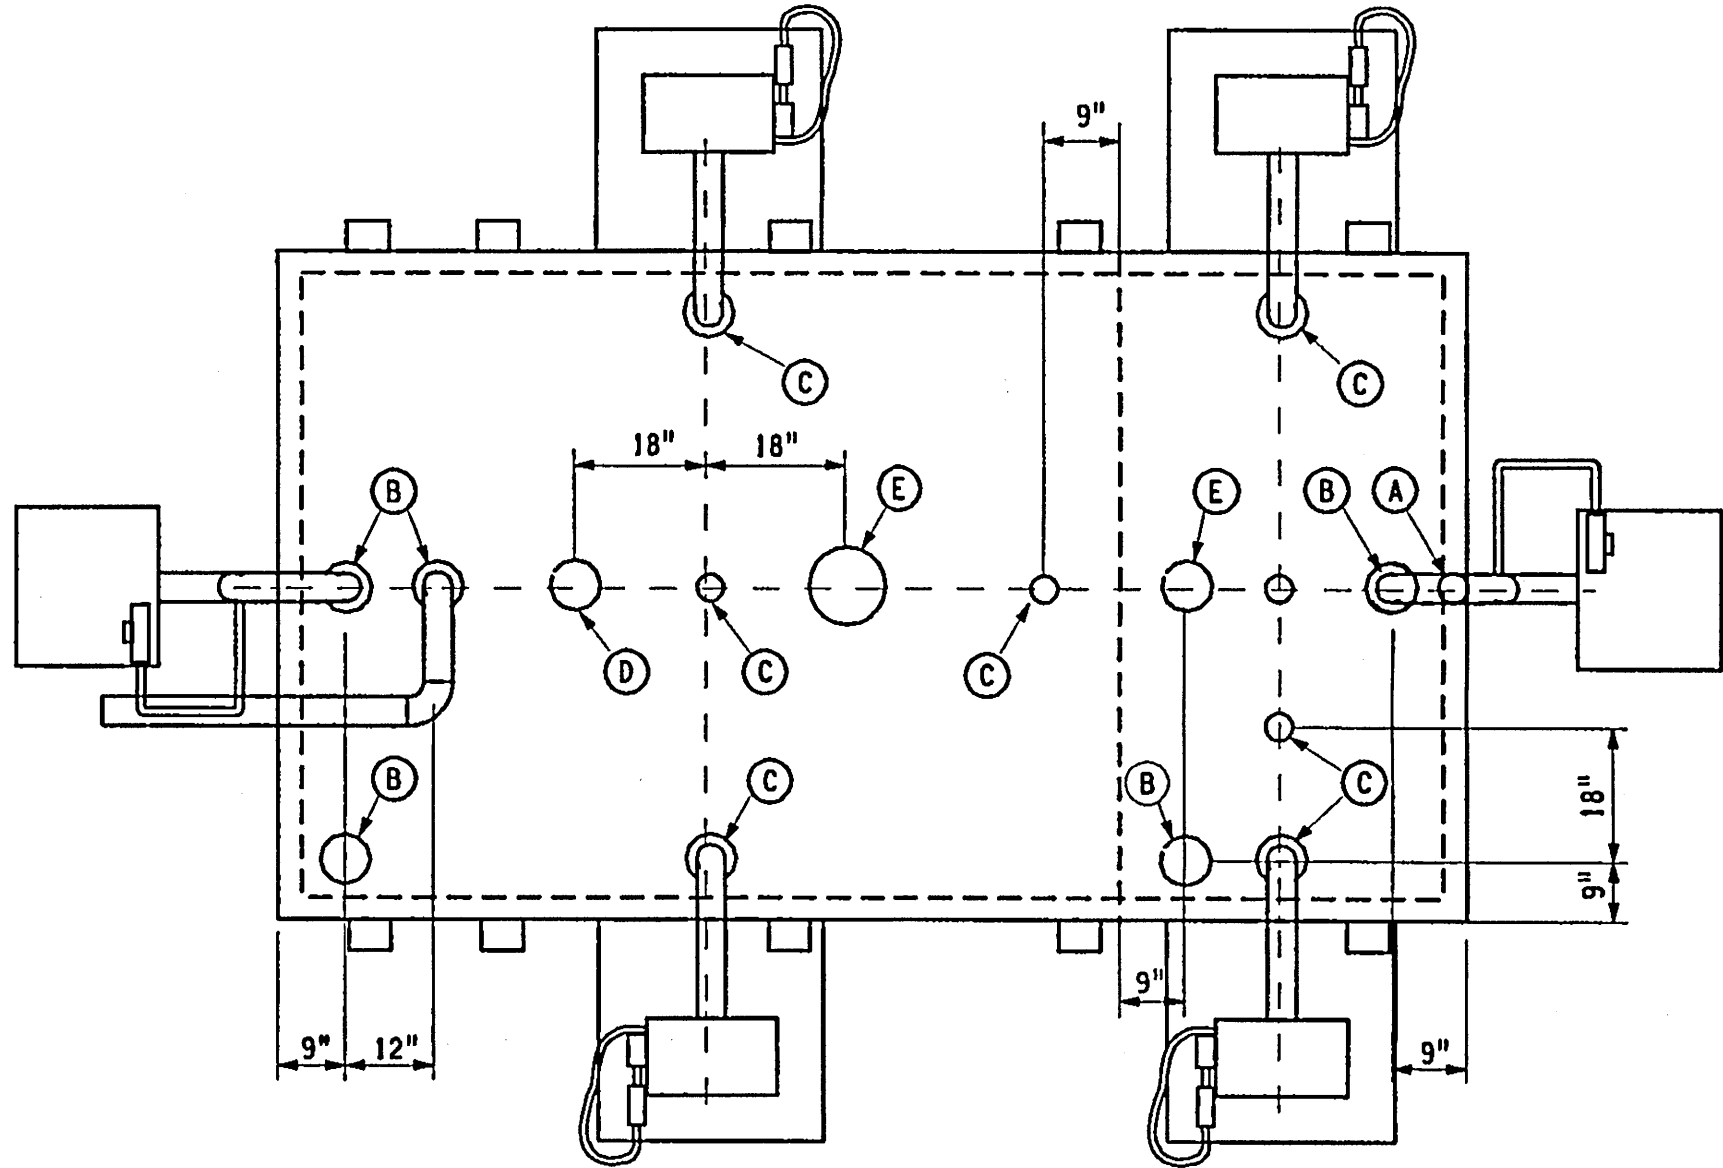


TOP VIEW

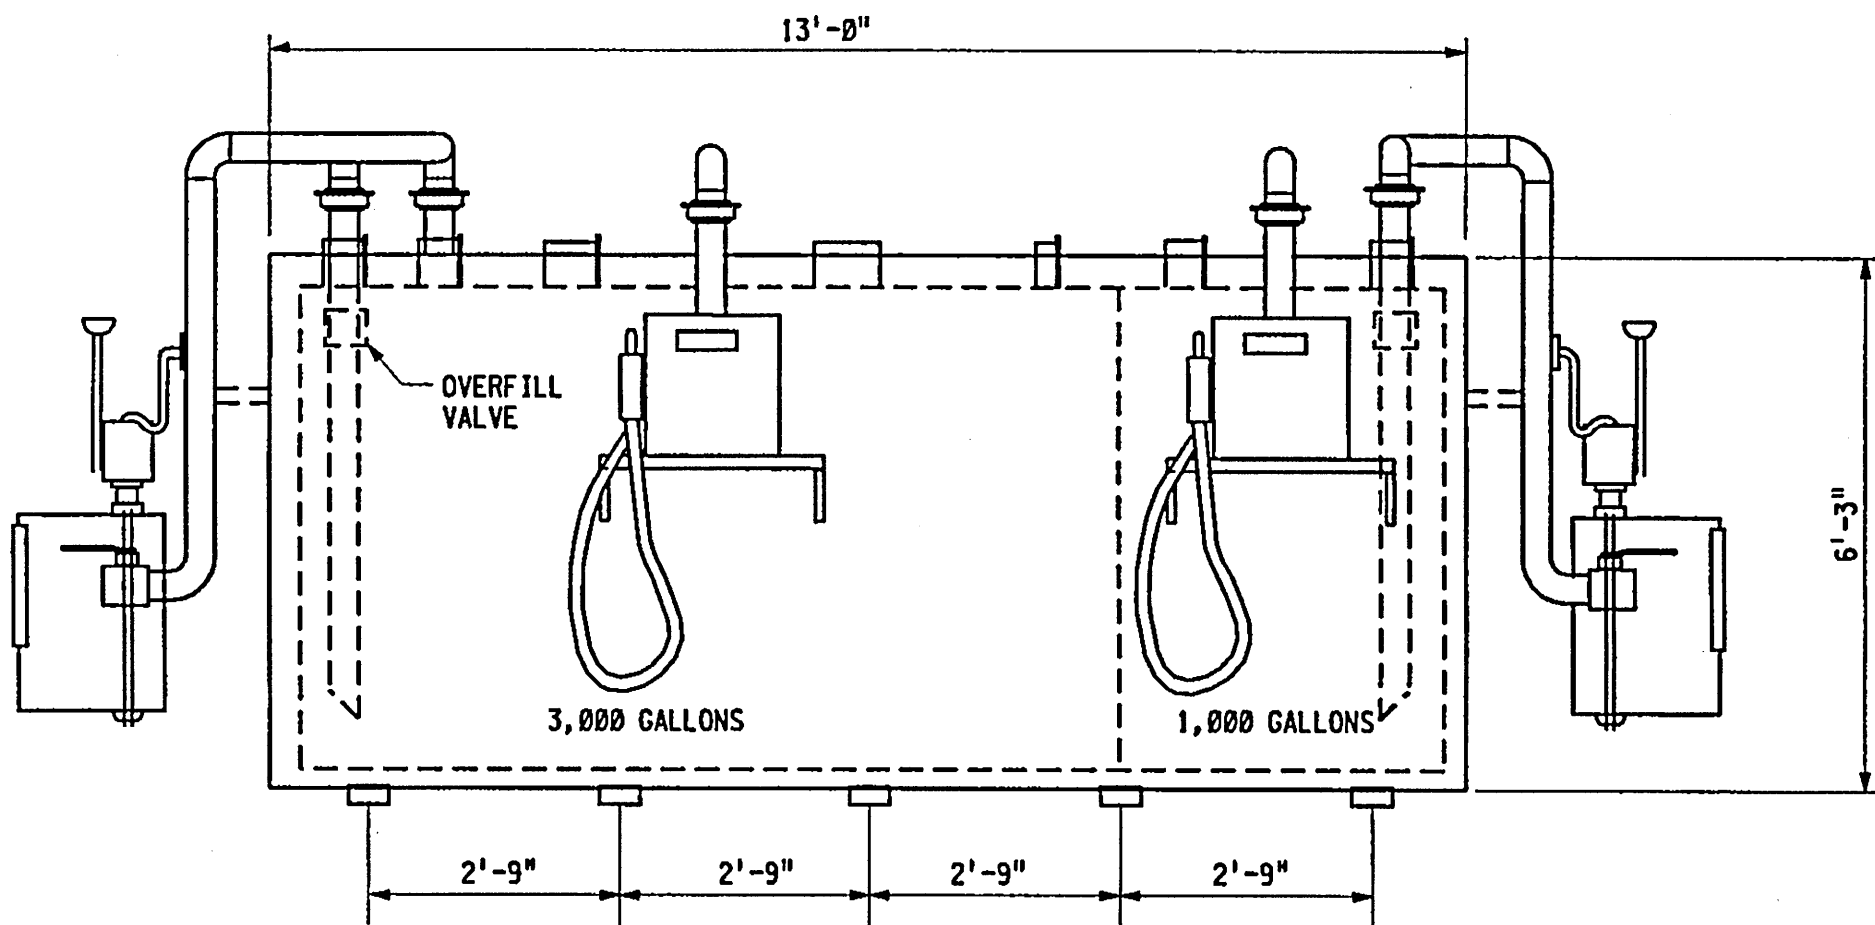


SIDE VIEW

FUEL TANK DETAIL

1
C-004

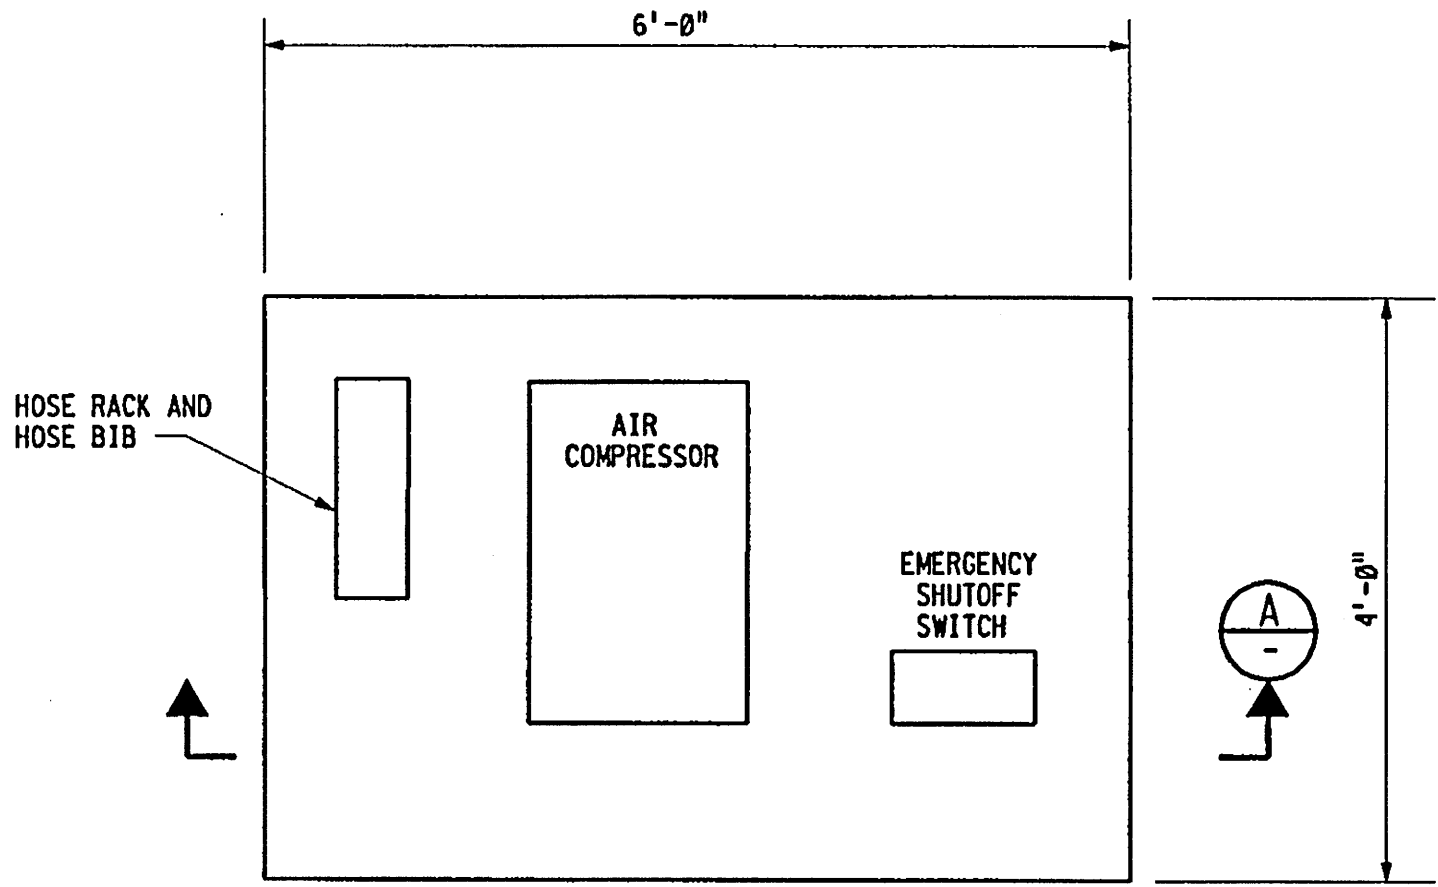

PLAN

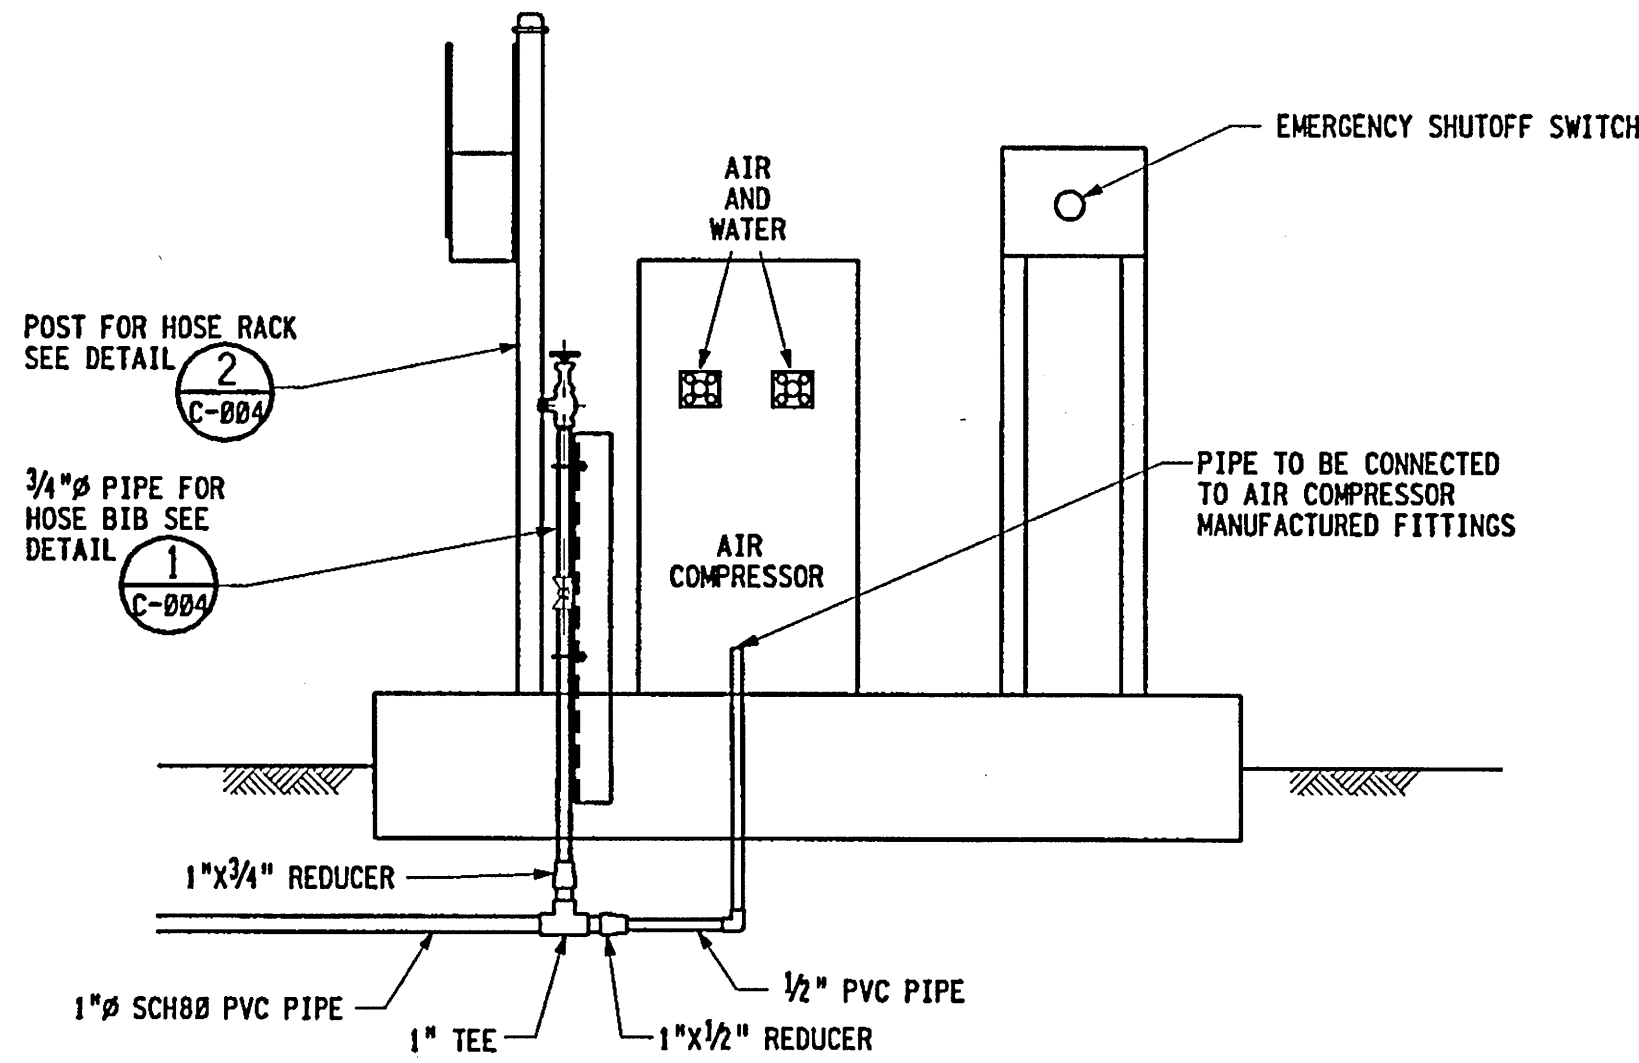

SECTION A

EQUIPMENT PAD DETAIL

2
C-004

NOTES

- CONTRACTOR TO FURNISH AND INSTALL 4000 GALLON DUAL COMPARTMENT, DOUBLE WALLED FIRE RATED TANK AS DESCRIBED IN SPECIFICATIONS SECTION 11110. ALL APPURTENANCES, INCLUDING BUT NOT LIMITED TO, VAPOR RECOVERY SYSTEM, FILL PORTS, DISPENSING PUMPS, SHALL BE PURCHASED AND INSTALLED AS A COMPLETE PACKAGE.
- CONTRACTOR TO SUBMIT STRUCTURAL CALCULATIONS FOR SEISMIC ANCHORAGE OF THE FUEL TANK IN ACCORDANCE WITH SPECIFICATIONS SECTION 01415.
- INNER AND OUTER TANKS SHALL BE CONSTRUCTED PER UL-42. TANKS SHALL BEAR UL 2085 LABEL FOR "INSULATED SECONDARY CONTAINMENT ABOVE GROUND TANK FOR FLAMMABLE LIQUIDS".

3" ON ORIGINAL DOCUMENT

NO.	DATE	REVISION	BY	REC.	APP.

DESIGN	DESIGN BY:	A. SIDHU	EAST BAY MUNICIPAL UTILITY DISTRICT SPECIAL DISTRICT No. 1 OAKLAND, CALIFORNIA
	DRAWN BY:	R. EBY	
REVIEW	DESIGN CHECKED BY:	T.N. CHEN	MAIN WASTEWATER TREATMENT PLANT FUELING FACILITY RELOCATION MECHANICAL FUEL TANK AND PIPING
	CONSTRUCTABILITY CHECKED BY:	D. SPOTTS	
RECOMMENDED	ELECTRICAL CHECKED BY:	R.P.E. No.	FACILITY: MWTP SCALE: 1"=10'-0" DATE: OCTOBER 2003
	PROJECT ENGINEER	A. SIDHU	
RECOMMENDED	PROJECT MANAGER	P. HOPKINS	DRAWING No. SD279-M-002 SHEET 8 OF 18
	SR. ENGINEER	T.N. CHEN	

2021 Criteria and Seismic Hazard Information

Evaluation Criteria



- **Evaluation Standards:** ASCE 41-17, ACI 350.3-06, ASCE 7-16, CBC

ASCE 41-17 Earthquake Levels for Existing Structures

ASCE 41-17 Designation	Probability of Exceedance (p/e)	Equivalent Return Period (Years)
BSE-2E	5% p/e in 50 years	975
BSE-1E	20% p/e in 50 years	225

- **Seismic Hazard Information:** 2020 Geotechnical Investigation Findings

