



PARTIAL PLAN
SCALE: 1/4" = 1'-0"


EXISTING OIL DRAIN RECEPTACLE W/ COVER, RELOCATE FROM EXISTING TANK TO BE LOCATED 3'-0" FROM CORNER OF NEW OIL DRUM SLAB.

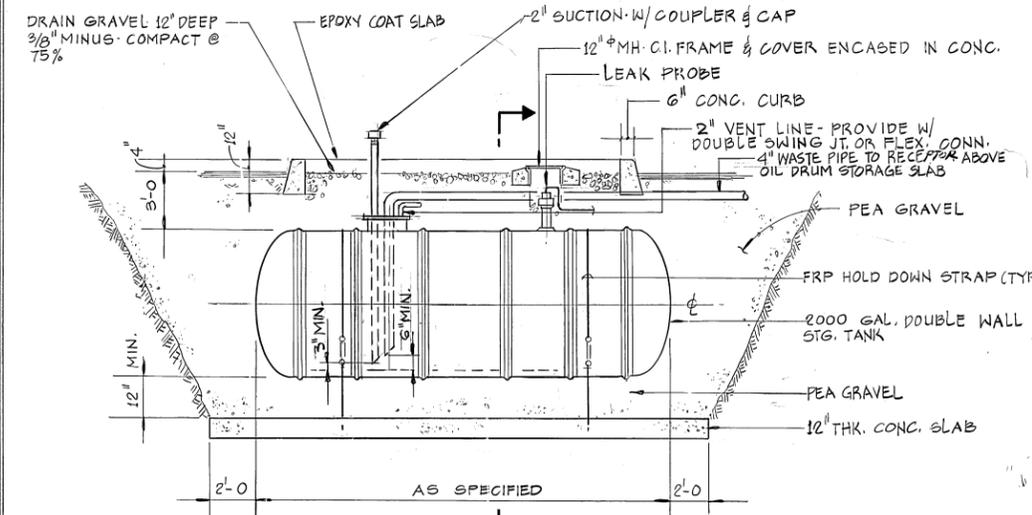

WASTE OIL STORAGE TANK
DETAIL 2
NO SCALE

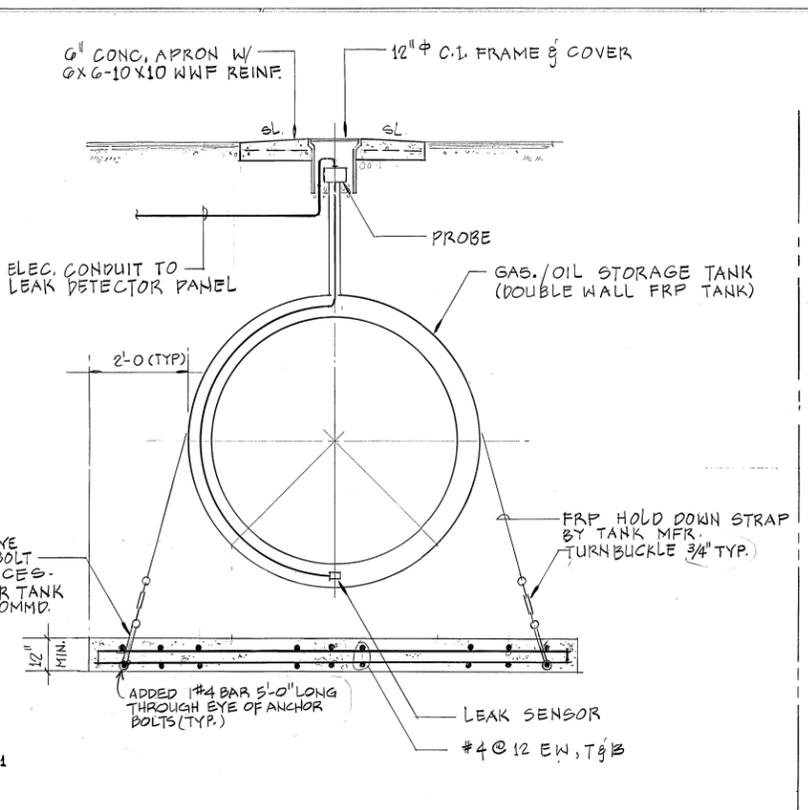

SECTION A-A
NO SCALE

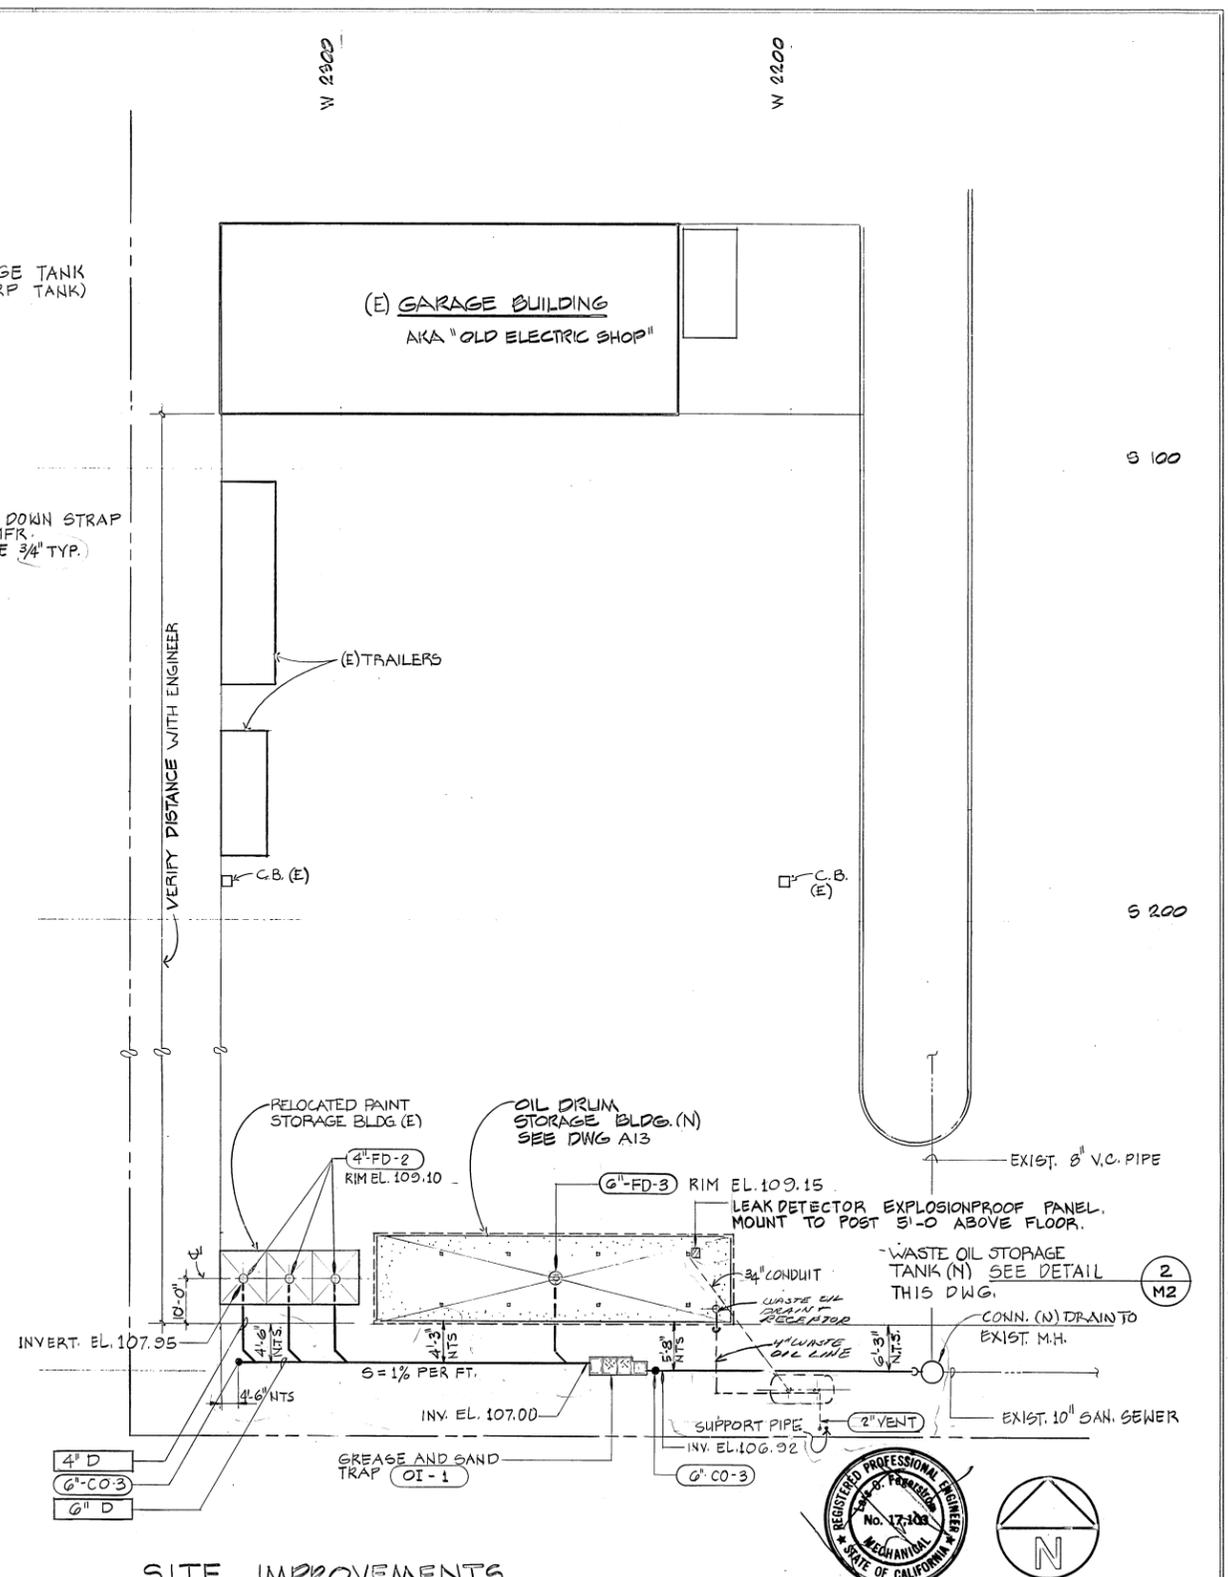

SITE IMPROVEMENTS
SCALE: 1" = 20.0'

NOTE: SEE SPECIFICATION SECTION 01014, SEQUENCE OF WORK, FOR SCHEDULING REQUIREMENTS.

NO.	DATE	REVISION	BY	REC.	APP.
Aug 87	As built		RVE	PSK	

LARS FAGERSTROM CONSULTING ENGINEERS, INC.
3815 BOMBARA ST. SUITE 200, WALNUT CREEK, CALIFORNIA 94598 (415) 932-0450

DESIGNED BY J.I.
DESIGN CHECKED BY L.F.
DRAWN BY J.I.
SR. PROJ. ENGR.
APPROVED Lars Fagerstrom ME17,103
PRINCIPAL-IN-CHARGE, NO. C

PROJECT ENG. J.B. Kistner
SIP. OF SPECIAL PROJECTS
MANAGER OF SUPPORT SERVICES
MANAGER OF WASTEWATER

EAST BAY MUNICIPAL UTILITY DISTRICT
OAKLAND, CALIFORNIA
MAINTENANCE FACILITIES IMPROVEMENTS SD 160
SITE PLAN DETAIL WEST AREA
STRUCTURE OR ZONE DESIGNATION
SCALE AS NOTED
DATE 21. NOV. 1985
HK M2